


**GRADING PLAN LEGEND:**

- PHASE 1 PROJECT LIMIT LINE
- EXISTING GRADE CONTOUR
- FINISH GRADE CONTOUR
- FINISH SPOT GRADE
- SEE CIVIL FOR CROSS REFERENCE OF PROPOSED ELEVATION
- TOP STEP
- BOTTOM STEP
- TOP OF WALL
- BOTTOM OF WALL
- TOP OF CURB
- GUTTER
- FINISH FLOOR
- TOP OF COLUMN

**sheet location**

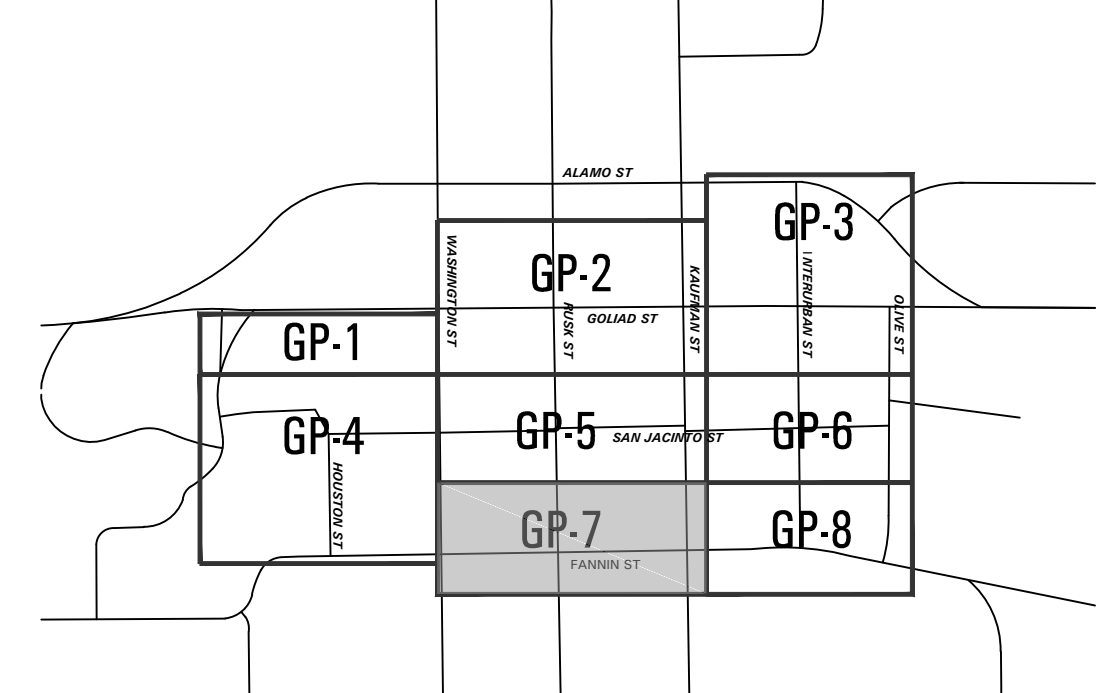

**Downtown Rockwall**  
 la terra studio Project #12024  
**streetscape improvements**  
 PHASE 2  
 rockwall, texas



submittals / revisions

no.	date	detail
△	05/08/14	RFI #20, #42, #43, #54
△	05/16/14	RFI #37
△	07/15/14	RFI #108
△	09/30/14	RFI #123
△	11/26/14	LASI #12
△	12/16/14	RFI #145

la terra studio, inc.  
 12024  
 its project number  
 02.26.2014  
 date  
 rac; bhm  
 drawn by  
 mtb  
 checked by

