


GRADING PLAN LEGEND:

	PHASE 1 PROJECT LIMIT LINE
	EXISTING GRADE CONTOUR
	FINISH GRADE CONTOUR
	FINISH SPOT GRADE
	SEE CIVIL FOR CROSS REFERENCE OF PROPOSED ELEVATION
	TOP STEP
	BOTTOM STEP
	TOP OF WALL
	BOTTOM OF WALL
	TOP OF CURB
	GUTTER
	FINISH FLOOR
	TOP OF COLUMN



Downtown Rockwall
 la terra studio Project #12024
 streetscape improvements
 PHASE 2
 rockwall, texas

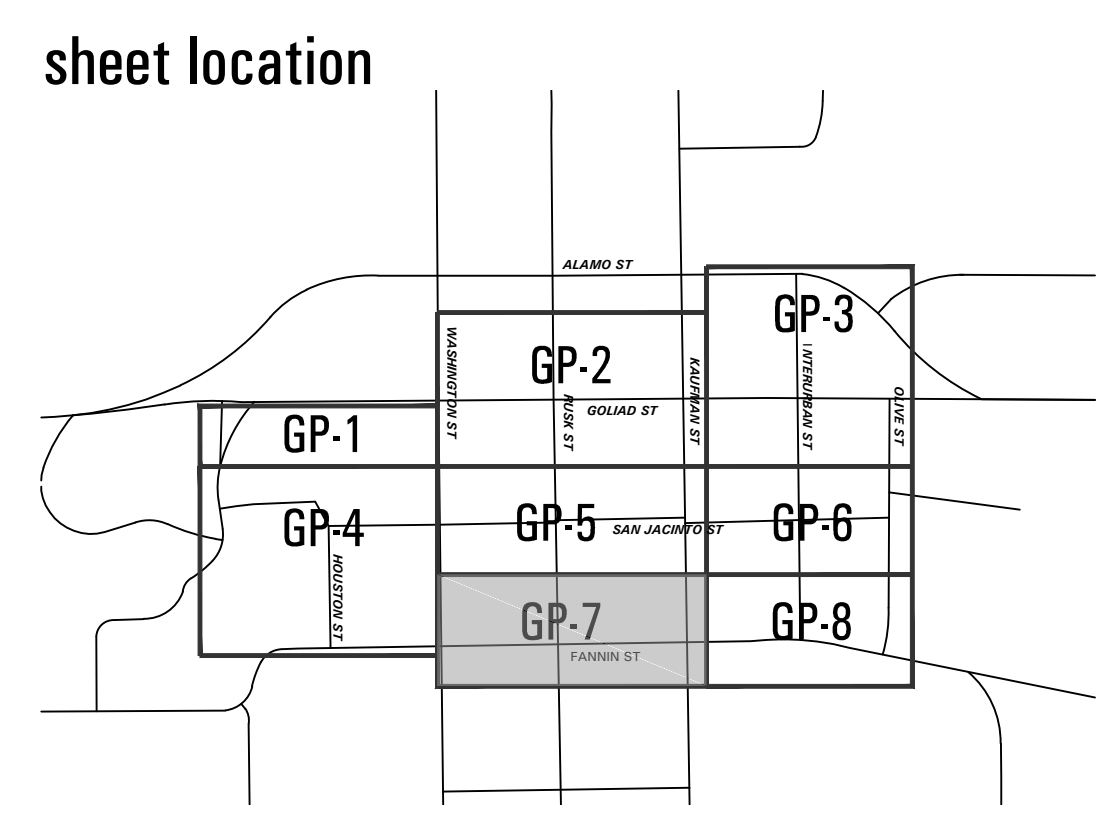

submittals / revisions

no.	date	detail
△	05/08/14	RFI #20, #42, #43, #54
△	05/16/14	RFI #37
△	07/15/14	RFI #108
△	09/30/14	RFI #123
△	11/26/14	LASI #12
△	12/16/14	RFI #145
△	01/13/15	RFI #153
△	04/15/15	RFI #146

la terra studio, inc.

12024
 its project number
 02.26.2014
 date
 rac; bhm
 drawn by
 mth
 checked by



Grading Plan
 sheet number
GP-7