


**SITE PLAN LEGEND:**

- EDGE OF PAVEMENT
- CONCRETE SIDEWALK PAVEMENT
- CONCRETE VEHICULAR PAVEMENT
- TYPICAL LIGHT FIXTURE

**sheet location**

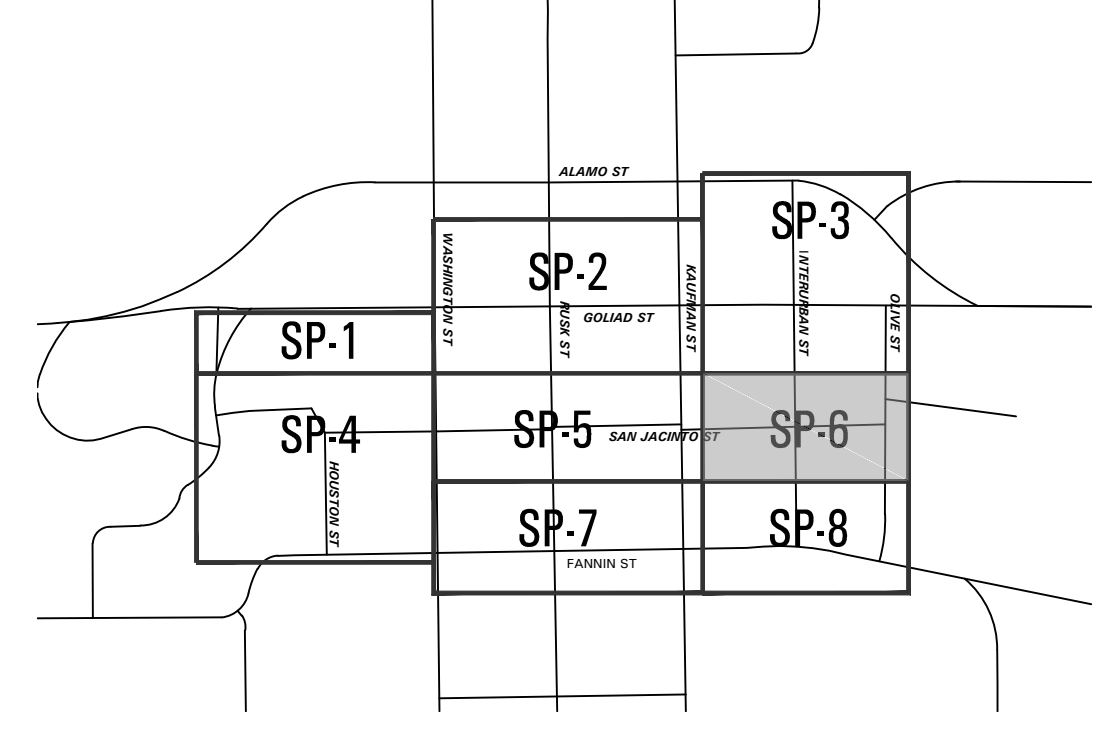

**Downtown Rockwall**  
streetscape improvements  
PHASE 2  
rockwall, texas




submittals / revisions

no.	date	detail
1	12/02/14	LASI #13
2	12/08/14	RFI #151

la terra studio, inc.

12024  
its project number  
02.26.2014  
date  
rac; bhm  
drawn by  
mtb  
checked by

registration

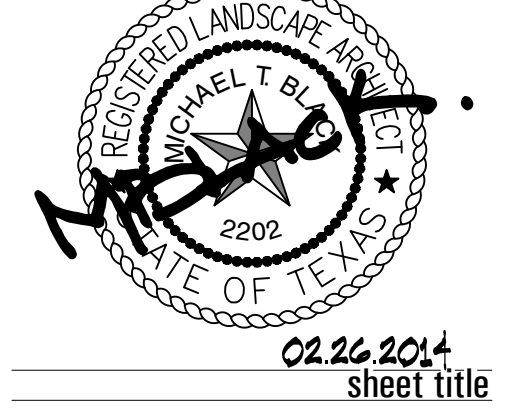

**Site Plan**  
sheet number  
**SP-6**