


~ MATCH LINE-SHEET GP-3 ~

MATCH LINE-SHEET GP-5 ~


~ MATCH LINE-SHEET GP-8 ~

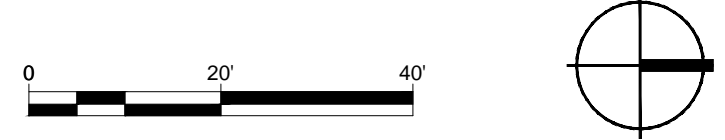

**GRADING PLAN LEGEND:**

|        |   |
|--------|---|
| 580    | EXISTING GRADE CONTOUR                              |
| 581    | FINISH GRADE CONTOUR                                |
| 587.25 | FINISH SPOT GRADE                                   |
| 580.00 | SEE CIVIL FOR CROSS REFERENCE OF PROPOSED ELEVATION |
| TS     | TOP STEP  |
| BS     | BOTTOM STEP   |
| TW     | TOP OF WALL   |
| BW     | BOTTOM OF WALL                                      |
| TC     | TOP OF CURB   |
| G      | GUTTER  |
| FF     | FINISH FLOOR  |
| TCOL   | TOP OF COLUMN                                       |

**sheet location**

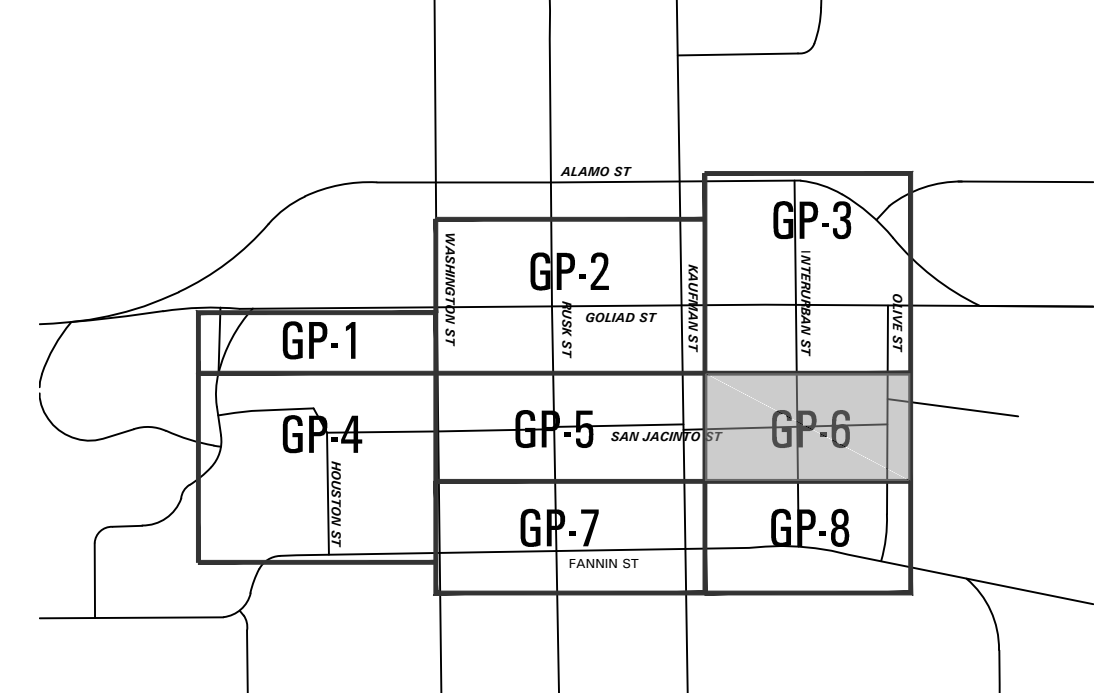

**Downtown Rockwall**  
 la terra studio Project #12024  
**streetscape improvements**  
 PHASE 2  
 rockwall, texas

submittals / revisions

| no. | date     | detail                      |
|-----|----------|-----------------------------|
| △   | 12/02/14 | RFI #62, #63, #64, LASI #13 |
| △   | 01/19/15 | RFI #156                    |

la terra studio, inc.  
 12024  
 Its project number  
 02.26.2014  
 date  
 rac; bhm  
 drawn by  
 mtb  
 checked by

