



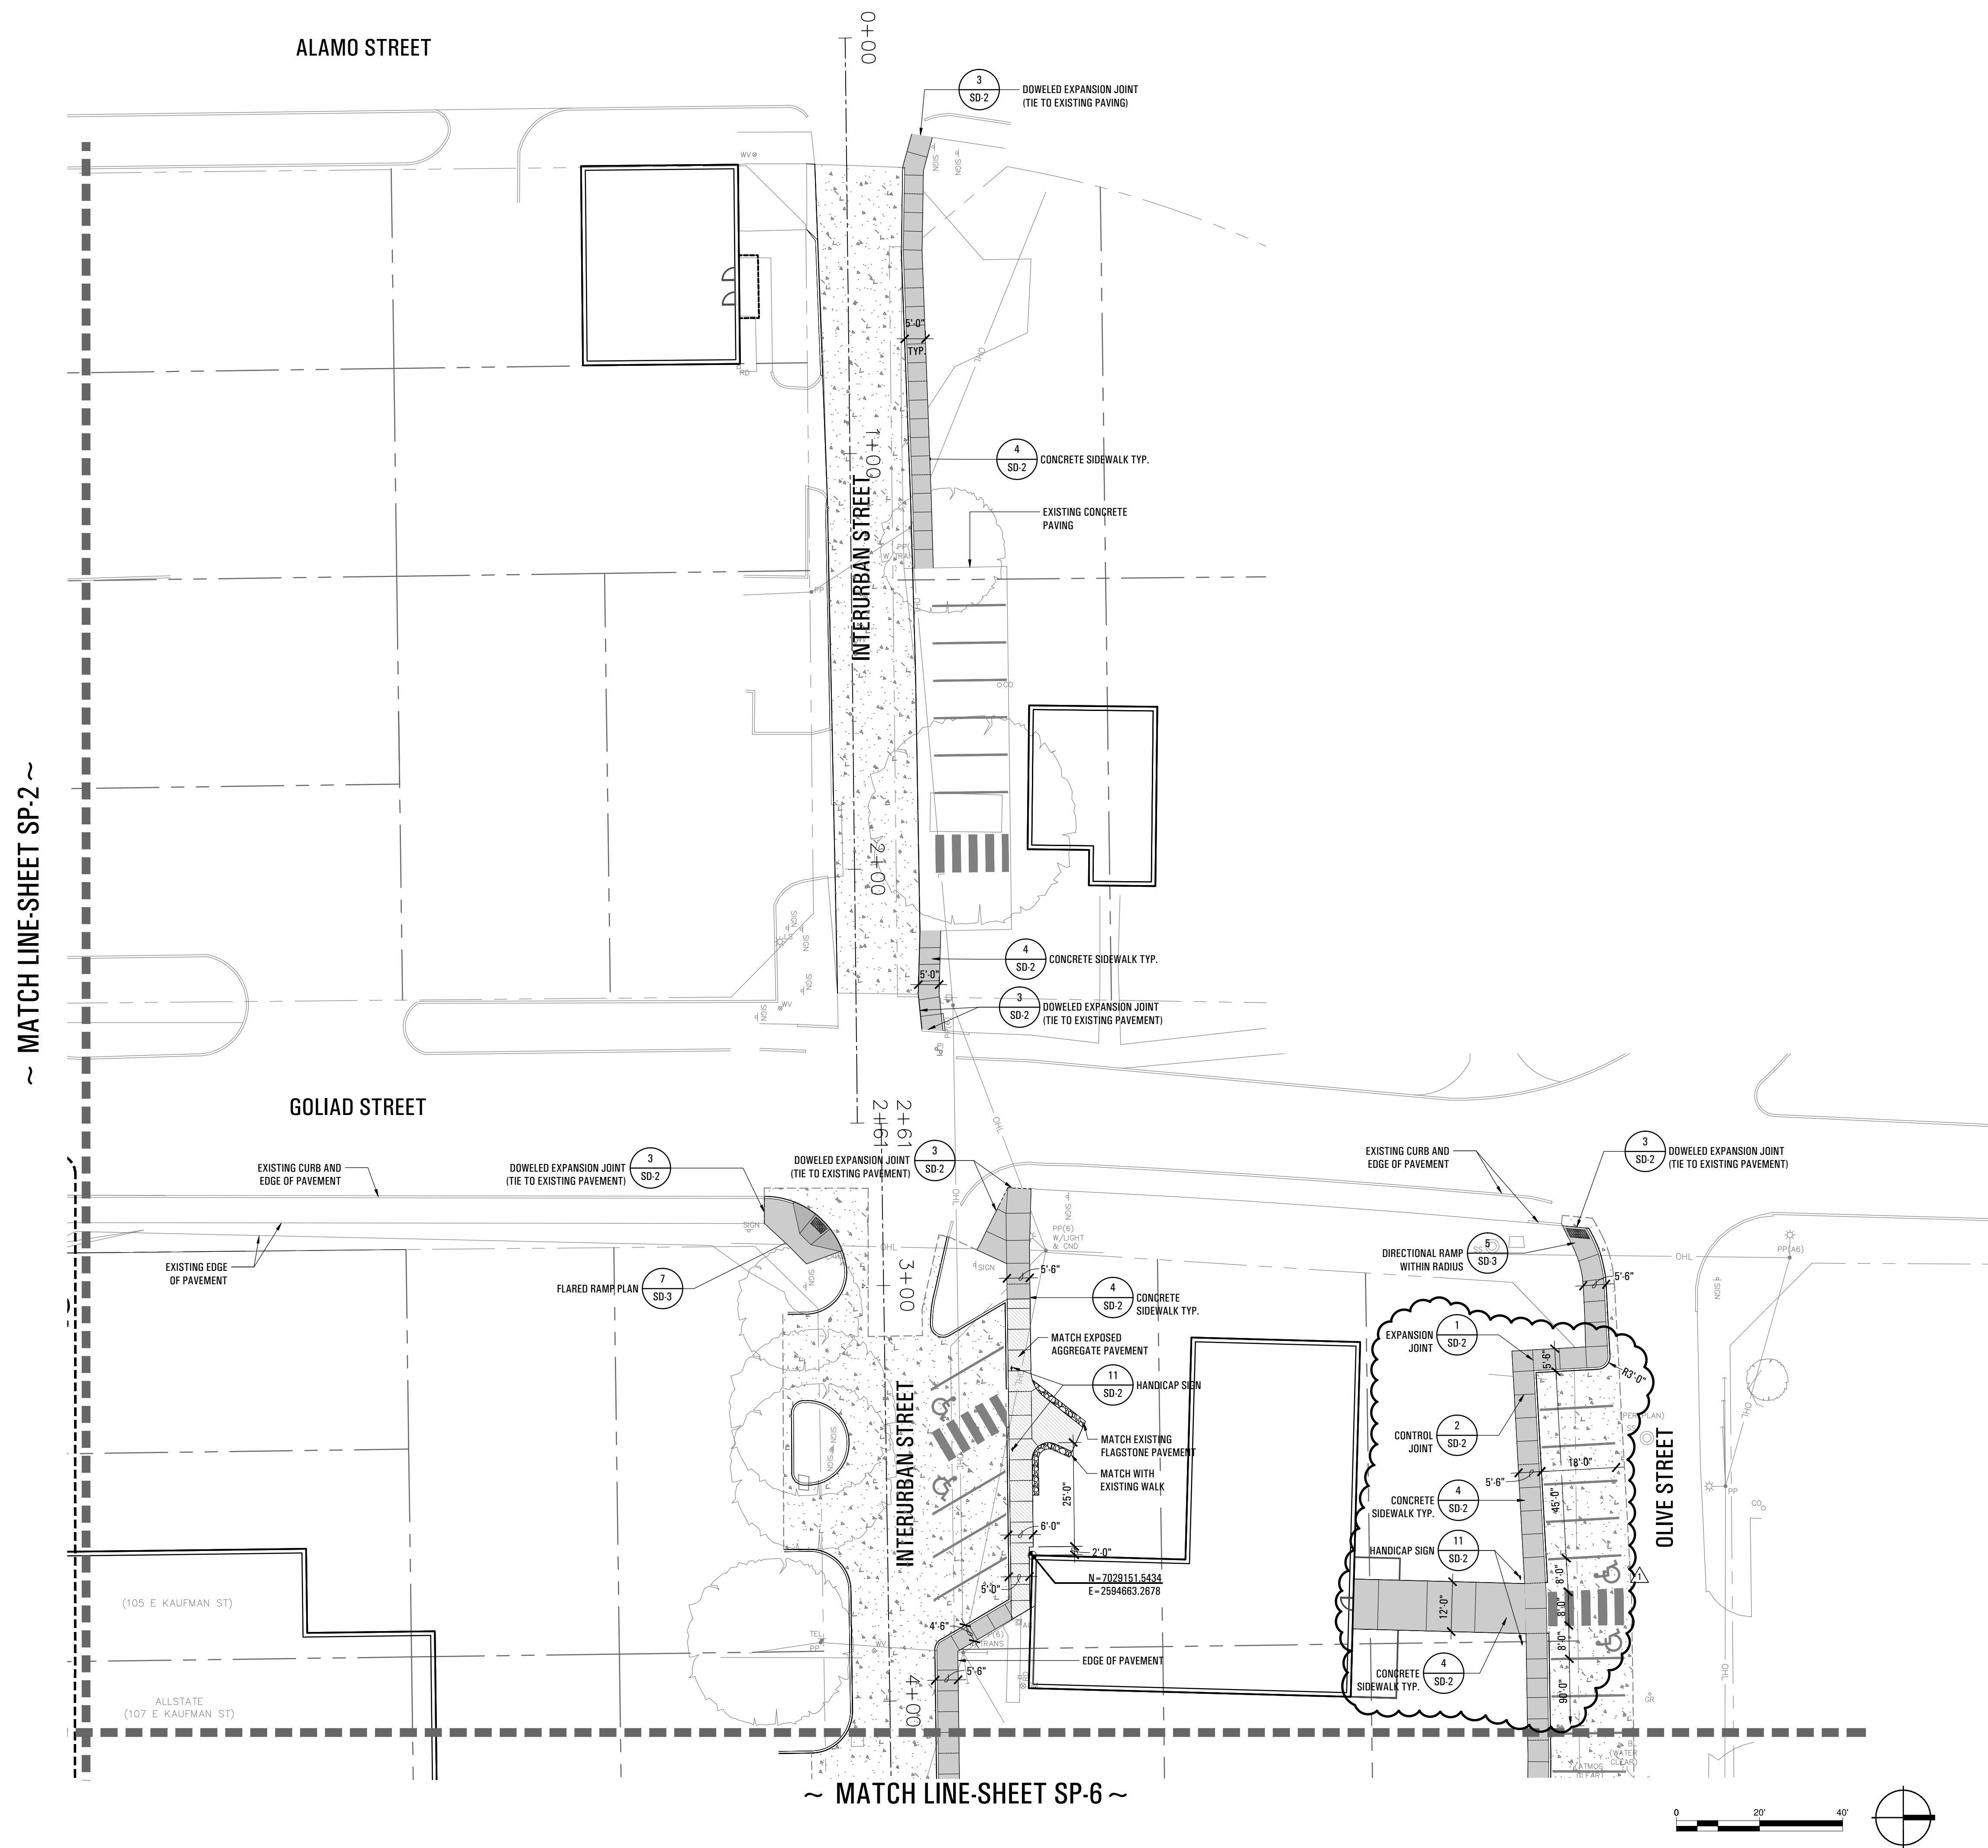

SITE PLAN LEGEND:

-
- The diagram illustrates four different pavement cross-sections, each with a corresponding label to its right:
- EDGE OF PAVEMENT:** Represented by a single horizontal line.
 - CONCRETE SIDEWALK PAVEMENT:** Represented by a solid gray rectangular block.
 - CONCRETE VEHICULAR PAVEMENT:** Represented by a rectangular block with a stippled or dotted texture.
 - TYPICAL LIGHT FIXTURE:** Represented by a horizontal line with a small circle (representing a light fixture) positioned below it.

sheet location

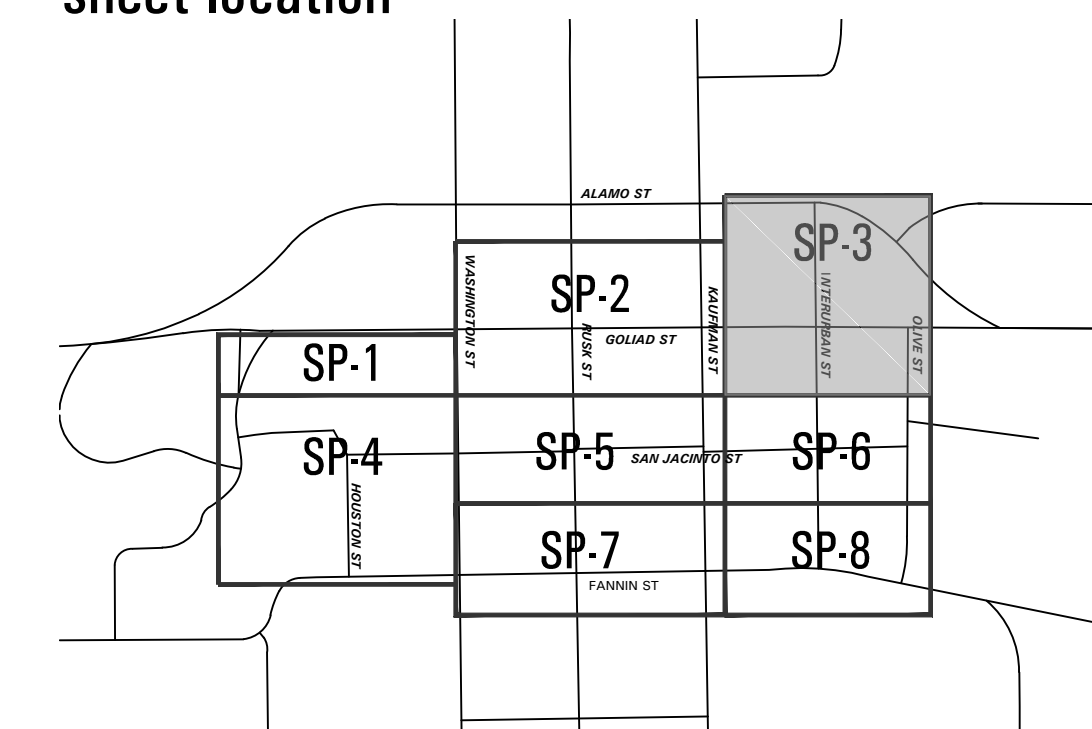

Downtown Rockwall

la terra studio Project #12024

streetscape improvements

PHASE 2

rockwall, texas


submittals / revisions

[illegible]

la terra studio, inc.

12024
Its project number
02.26.2014
date
rac; bhm
drawn by
mtb
checked by

registration

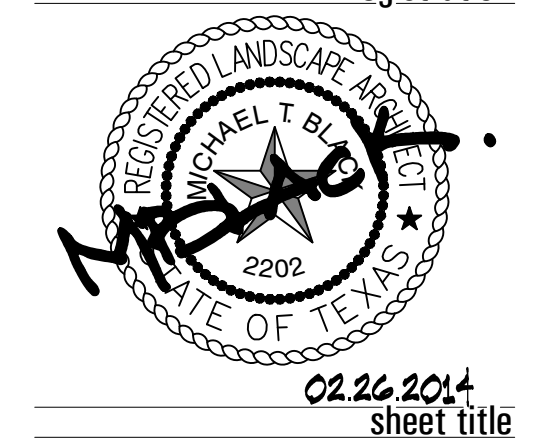

Site Plan

sheet number

SP-3