


SITE PLAN LEGEND:

- EDGE OF PAVEMENT
- CONCRETE SIDEWALK PAVEMENT
- CONCRETE VEHICULAR PAVEMENT
- TYPICAL LIGHT FIXTURE

sheet location

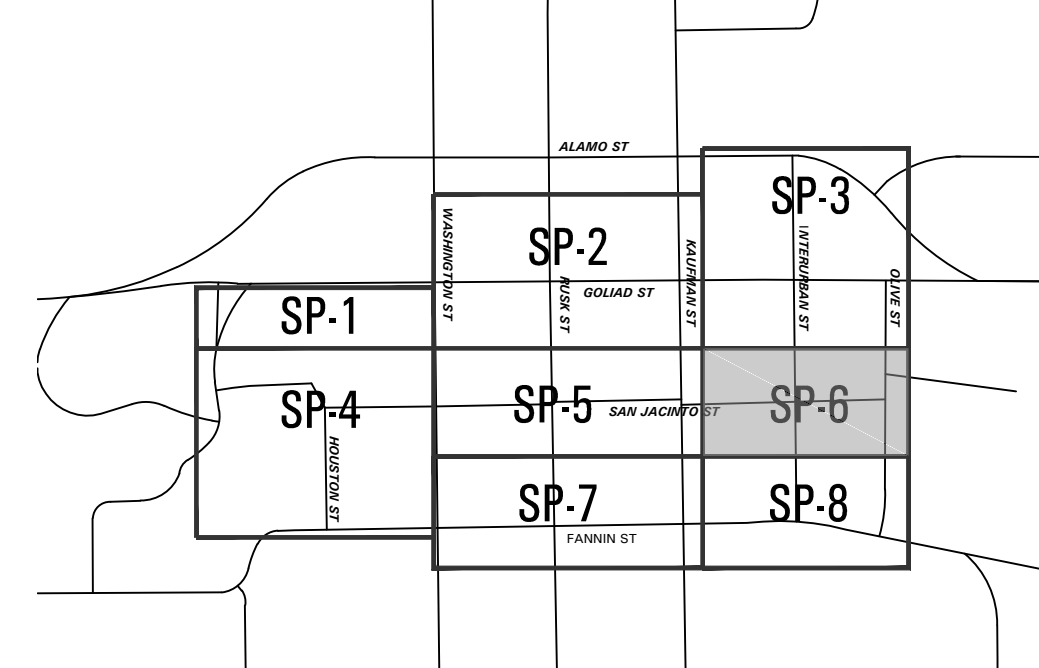

Downtown Rockwall
la terra studio Project #12024
streetscape improvements
PHASE 2
rockwall, texas




submittals / revisions

no.	date	detail
1	12/02/14	LASI #13
2	12/08/14	RFI #151
3	12/22/14	RFI #150
4	02/10/15	RFI #159

la terra studio, inc.

12024
its project number
02.26.2014
date
rac; bhm
drawn by
mtb
checked by

registration

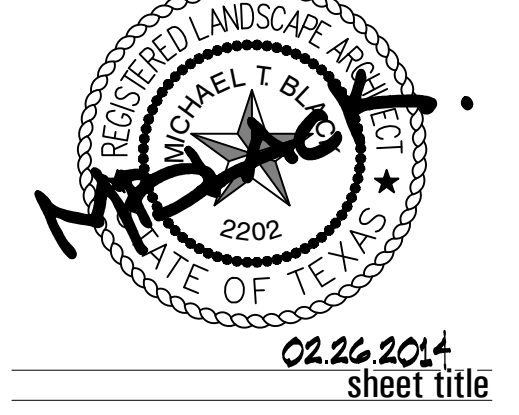

Site Plan
sheet number
SP-6