



sheet location

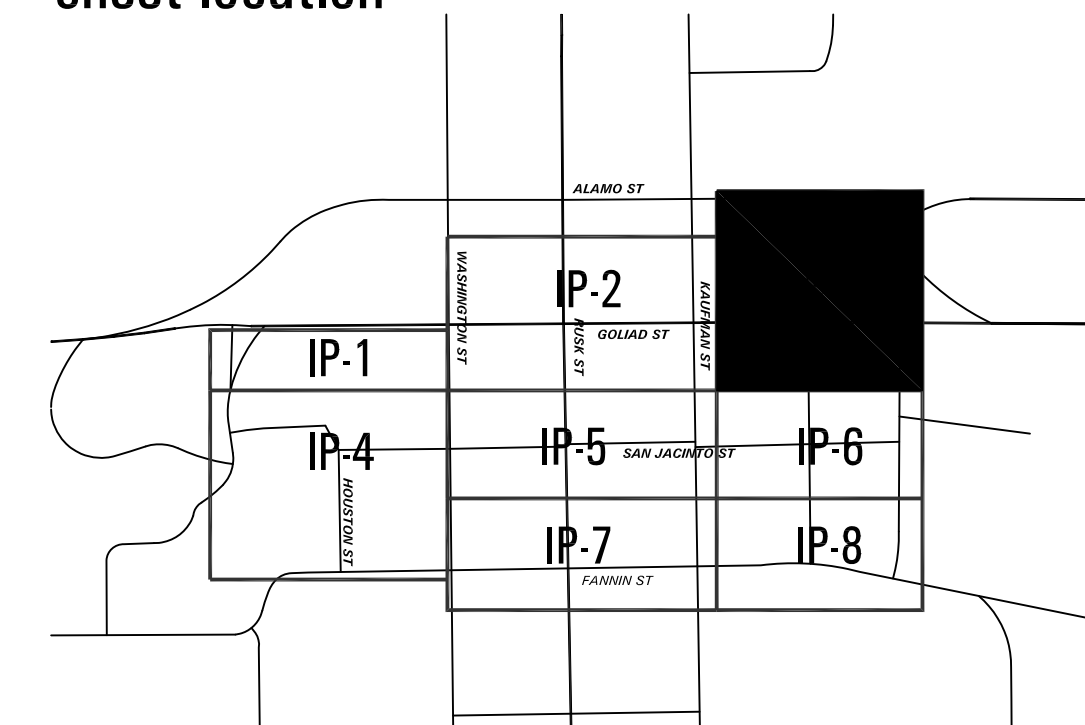

**Downtown Rockwall**  
 Project # T2024 ~ renovation ~  
**streetscape improvements**  
 rockwall, texas

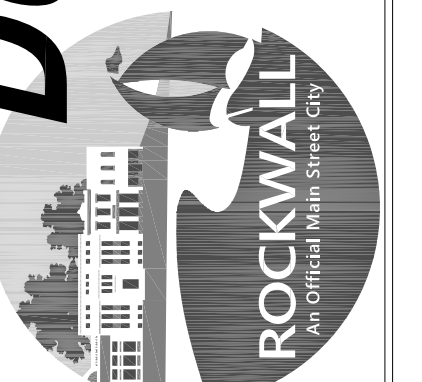

submittals / revisions

no.	date	detail
1	3-19-14	RFI #11
2	6-26-15	RFI #161

la terra studio, inc.

12024  
 Its project number  
 02.26.2014  
 date  
 SAH  
 drawn by  
 SAH  
 checked by

registration



sheet title

**Irrigation Plan**  
 sheet number

2 **IP-3**