



submittals / revisions

no.	date	detail
1	4-15-14	RFI #39
2	7-03-14	RFI #39
3	7-22-14	RFI #109
4	12-30-14	RFI #139
5	3-30-15	RFI #167

la terra studio, inc.

12024
Its project number
4.15.2014
date
bgp
drawn by
bgp
checked by

registration



3-30-15


sheet title
FOUNDATION PLAN
sheet number

FP-2

PIERCE ENGINEERING
STRUCTURAL ENGINEERING


BUS.: (940) 937-8600 132 N. MAIN STREET
FIRM REG #: F-9186 CHILDRESS, TX 79201

RUSK STREET

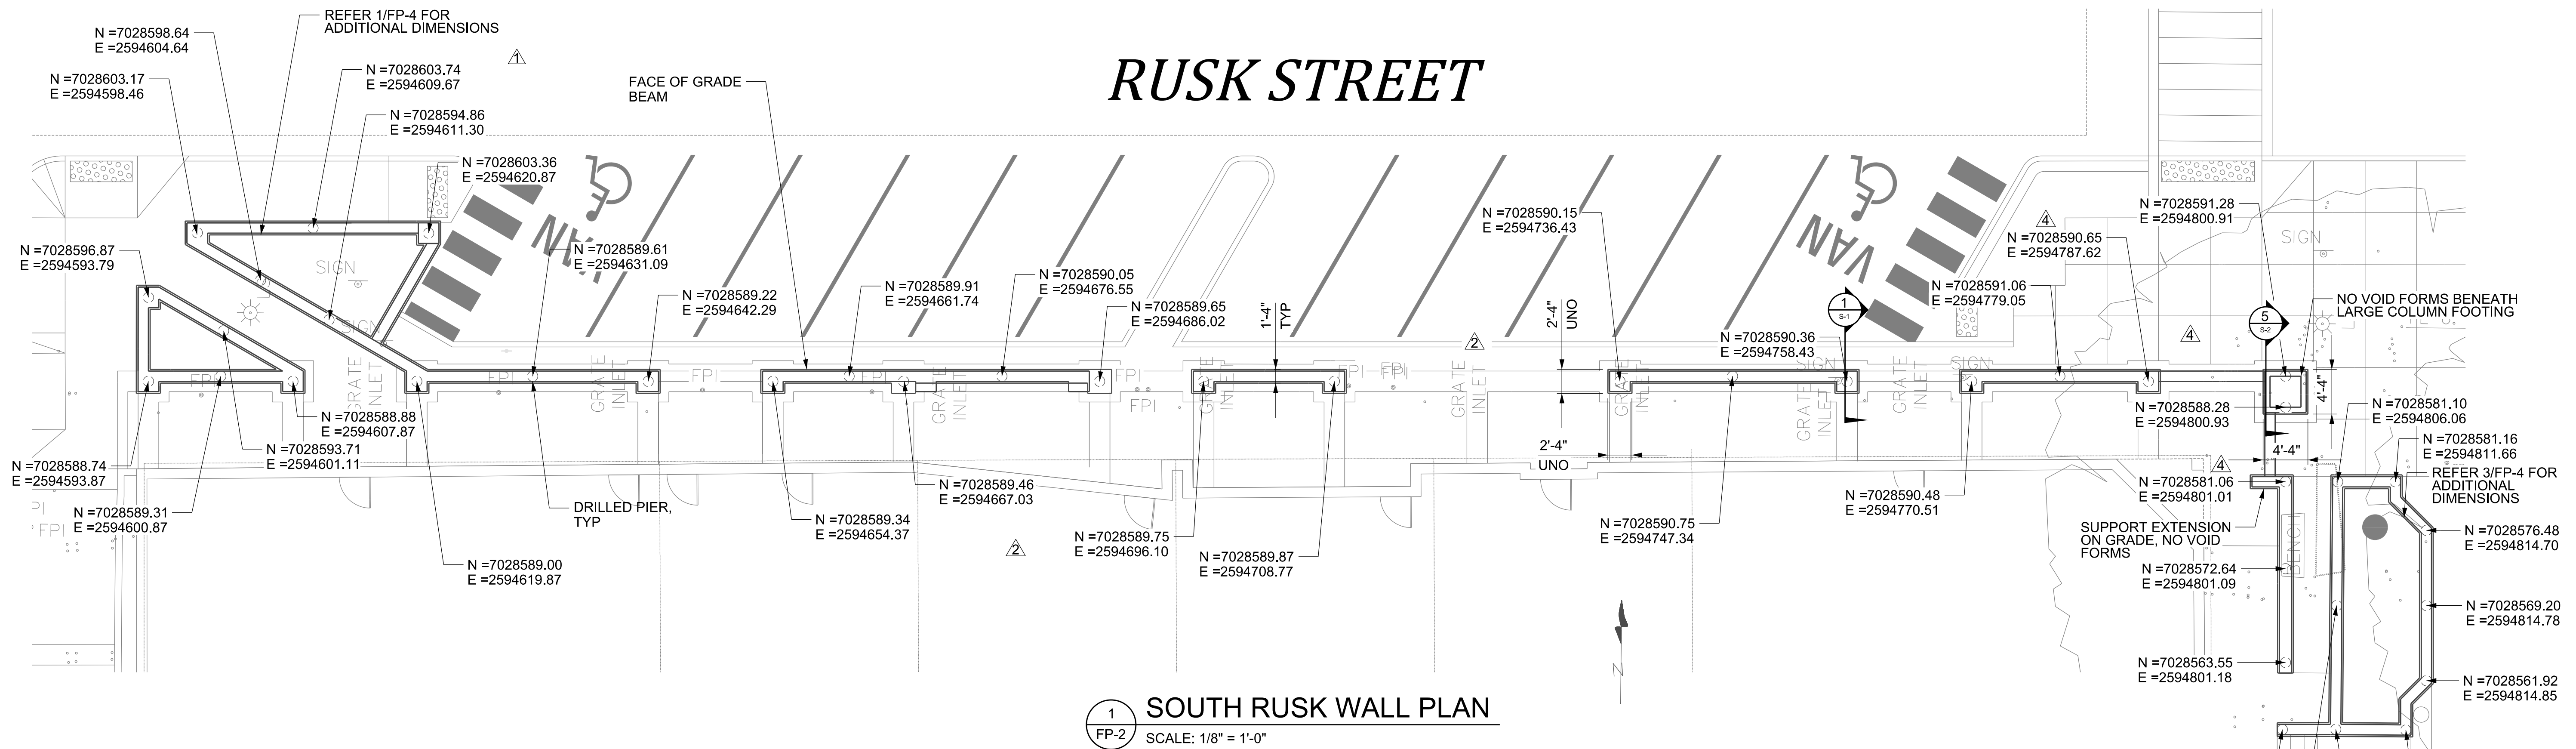

1 SOUTH RUSK WALL PLAN
SCALE: 1/8" = 1'-0"

RUSK STREET

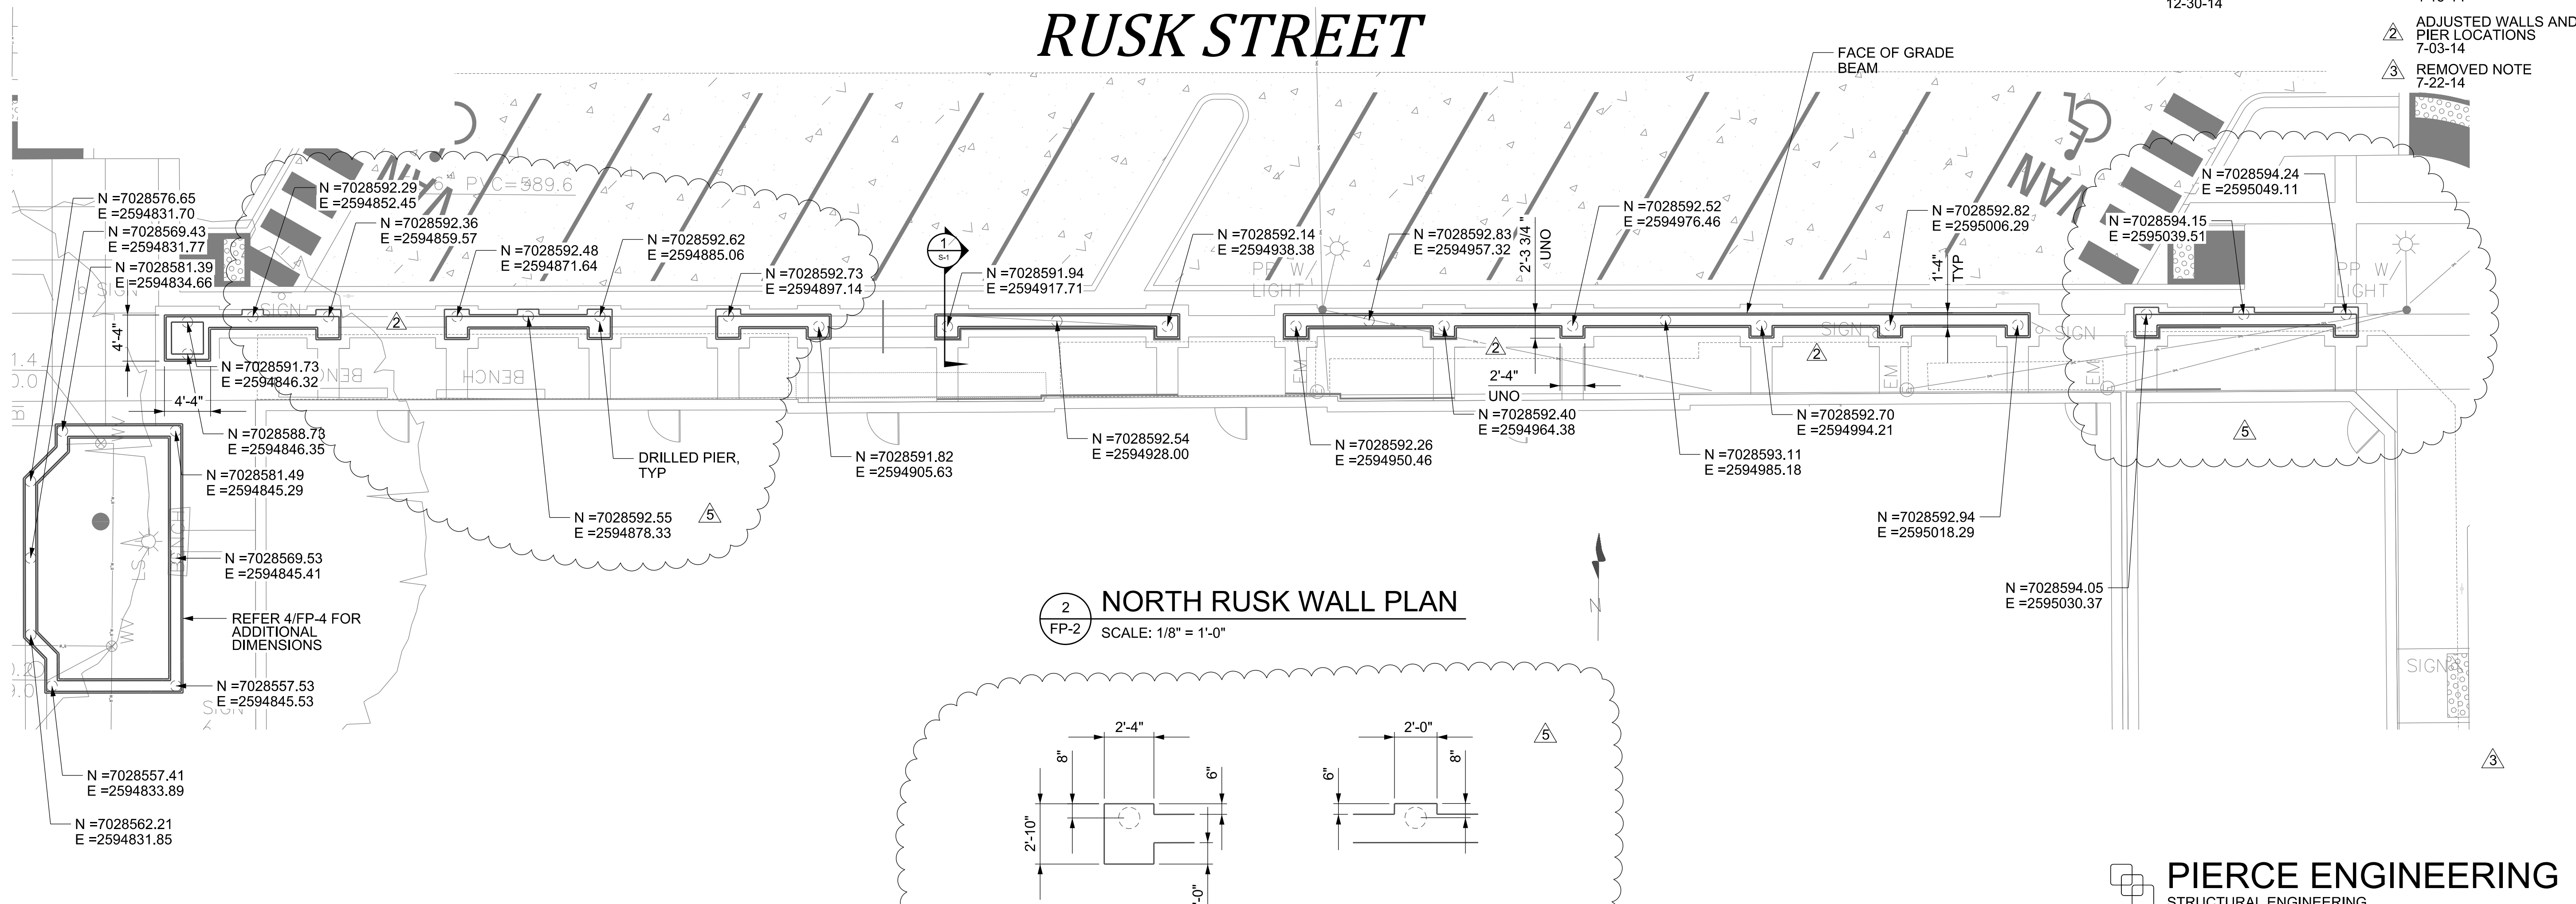

2 NORTH RUSK WALL PLAN
SCALE: 1/8" = 1'-0"

3 TYPICAL WALL BUMPOUT
SCALE: 1/4" = 1'-0"