


© 2013 la terra studio, inc. All Rights Reserved FILE:R:\12024-Downtown Rockwall PS&E - Rockwall\CAD\SHETS\12024_LP1-7.dwg



Downtown Rockwall
 la terra studio Project #12024
streetscape improvements
 PHASE 2
 rockwall, texas

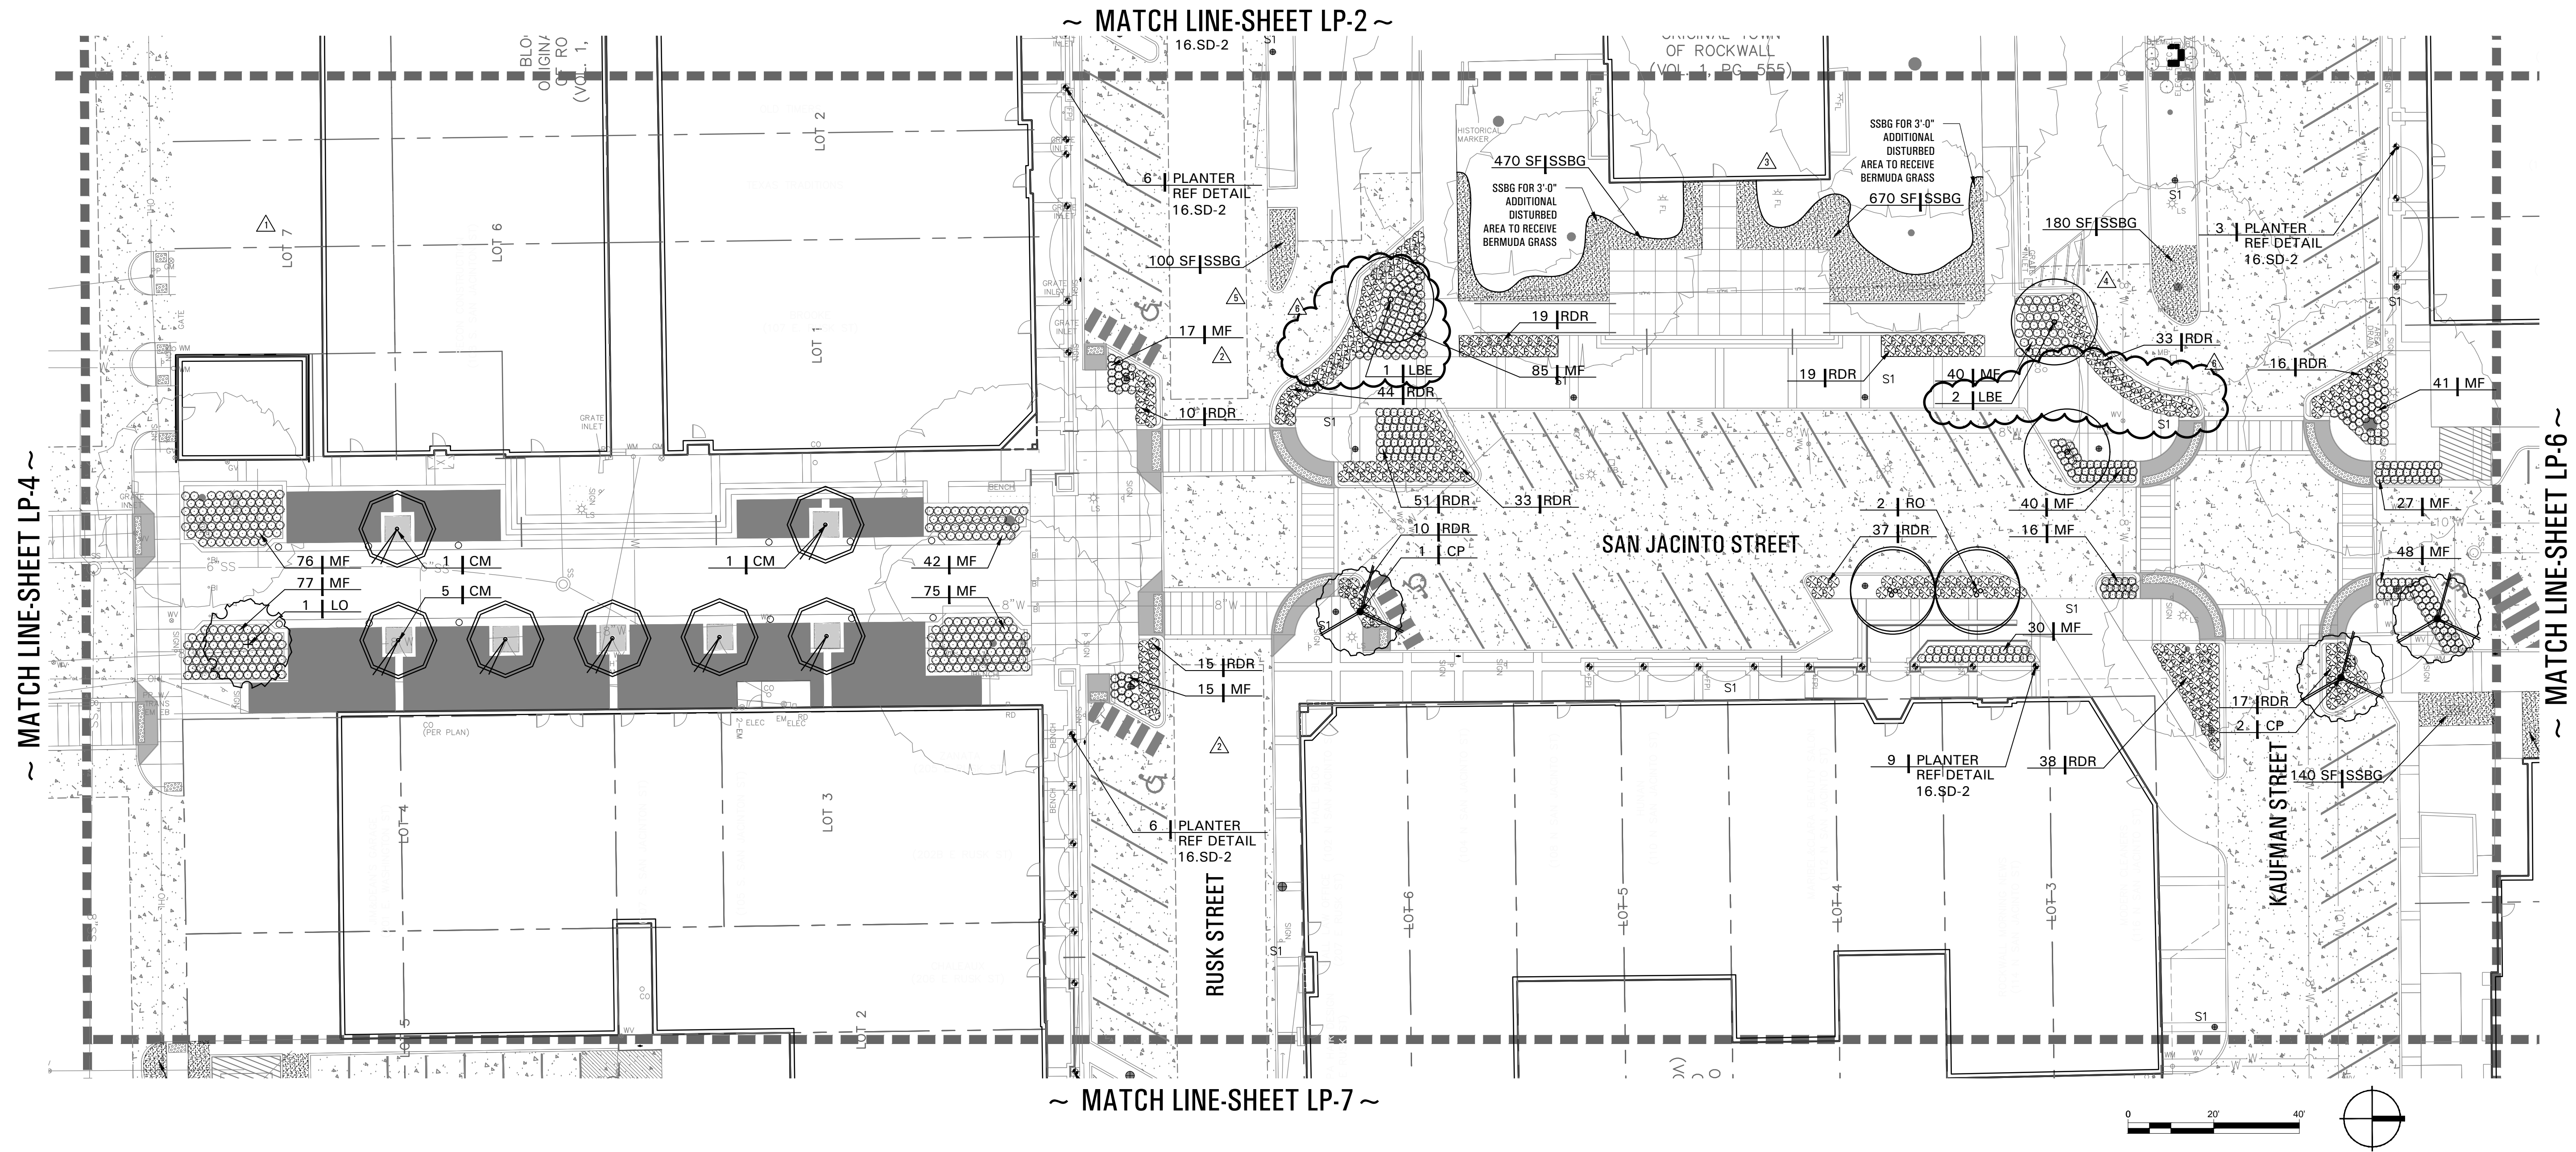

submittals / revisions

no.	date	detail
△	07/14/14	RFI #101
△	07/29/14	RFI #112
△	08/29/14	RFI #120
△	09/16/14	RFI #121, #125
△	02/27/15	RFI #164
△	04/06/15	RFI #171

la terra studio, inc.

12024
 Its project number
 02.26.2014
 date
 rac; bhm
 drawn by
 mtb
 checked by



Landscape Plan
 sheet number
LP-5

PLANT AND MATERIALS LIST: NOTE: CONTRACTOR TO VERIFY QUANTITIES PER PLANS

CANOPY TREES			
QNTY.	SYMBOL	COMMON NAME	BOTANIC NAME
	CP	CHINESE PISTACHE	PISTACHIA CHINENSIS
	LO	LIVE OAK	QUERCUS VIRGINANA
	LBE	LACE BARK ELM	ULMUS PARVIFOLIA
	RO	RED OAK	QUERCUS SHUMARDI
	CM	CADDO MAPLE	ACER SACCHARUM 'CADD0'

SHRUBS			
QNTY.	SYMBOL	COMMON NAME	BOTANIC NAME
	MF	MEXICAN FEATHER GRASS	STIPA TENIOSSIMA
	RDR	RED DRIFT ROSE	ROSA 'MEIGALPIO'

TURF			
QNTY.	SYMBOL	COMMON NAME	BOTANIC NAME
	SSBG	SOLID SOD BERMUDA GRASS	Cynodon dactylon

EXISTING TREE		
QNTY.	SYMBOL	NOTE
	(Symbol)	PER PLAN REFERENCE CIVIL DEMO PLANS FOR TREE PRESERVATION.

