


SITE PLAN LEGEND:

- EDGE OF PAVEMENT
- CONCRETE SIDEWALK PAVEMENT
- CONCRETE VEHICULAR PAVEMENT
- TYPICAL LIGHT FIXTURE

sheet location

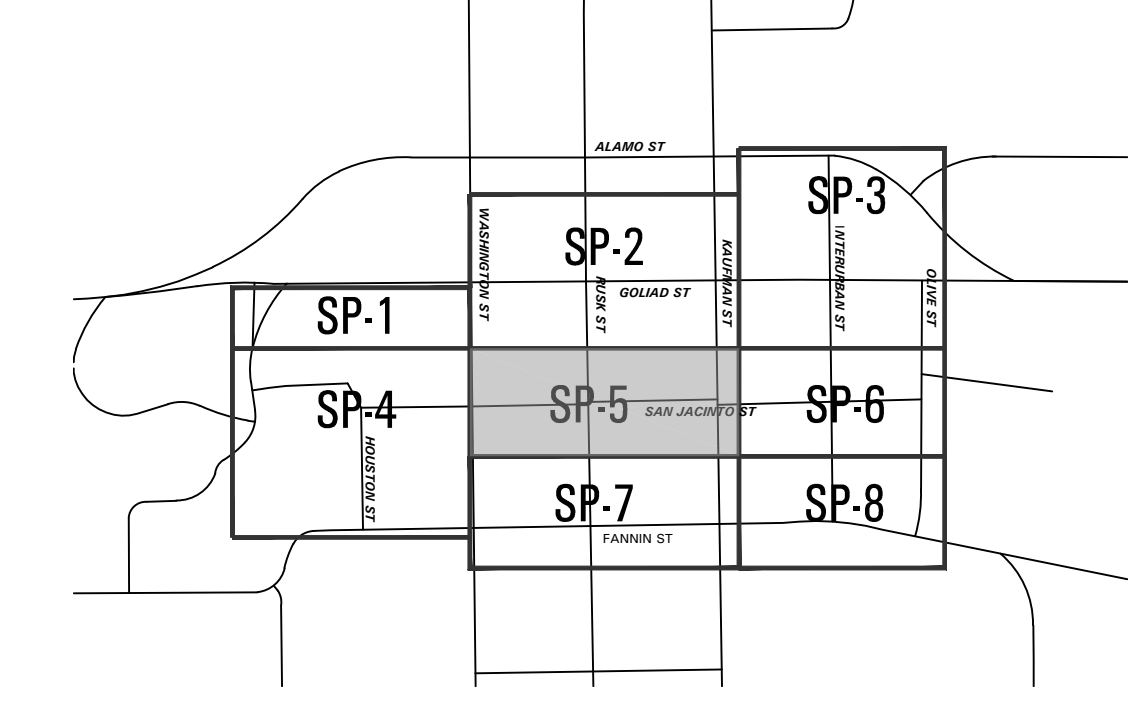

Downtown Rockwall
 la terra studio Project #12024
streetscape improvements
 PHASE 2
 rockwall, texas



submittals / revisions

no.	date	detail
▲	04/03/15	RF# 170
▲	04/06/15	RF# 171

la terra studio, inc.

12024
 lts project number
 02.26.2014
 date
 rac; bhm
 drawn by
 mtb
 checked by



Site Plan
 sheet number
SP-5