

~ MATCH LINE-SHEET SP-4 ~

~ MATCH LINE-SHEET SP-5 ~

~ MATCH LINE-SHEET SP-8 ~


1 NO PARKING SIGN
SCALE: 3/4" = 1'-0"



SITE PLAN LEGEND:

- PHASE 1 PROJECT LIMIT LINE
- EDGE OF PAVEMENT
- CONCRETE SIDEWALK PAVEMENT
- CONCRETE VEHICULAR PAVEMENT
- CONCRETE DUMPSYTER PAD PAVEMENT
- TYPICAL LIGHT FIXTURE

sheet location

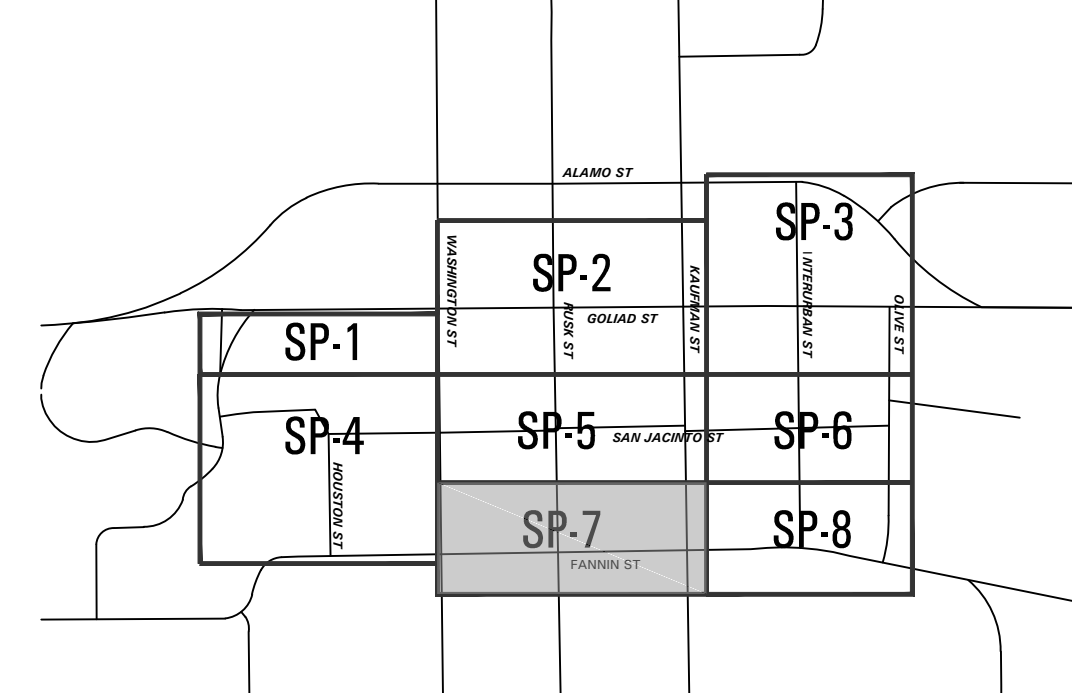

Downtown Rockwall
la terra studio Project #12024
streetscape improvements
PHASE 2
rockwall, texas




submittals / revisions

no.	date	detail
△	05/08/14	RFI #20, #42, #43
△	05/18/14	RFI #37
△	05/27/14	RFI #71
△	07/18/14	RFI #108
△	09/30/14	RFI #123
△	04/06/15	RFI #171

la terra studio, inc.

12024
Its project number
02.26.2014
date
rac; bhm
drawn by
mtb
checked by

registration

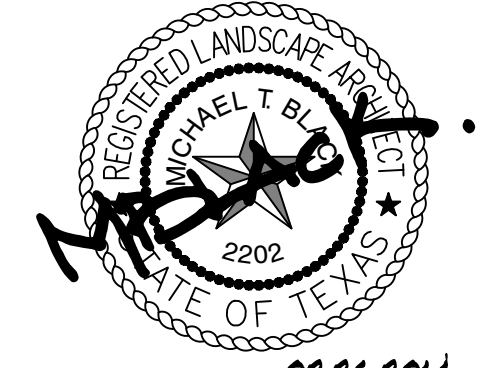

02.26.2014 sheet title

Site Plan
sheet number
SP-7