




© 2013 la terra studio, inc. All Rights Reserved FILE:R:\12024-Downtown Rockwall PS&E - Rockwall\CAD\Sheet\12024-Str Detalls_1.dwg

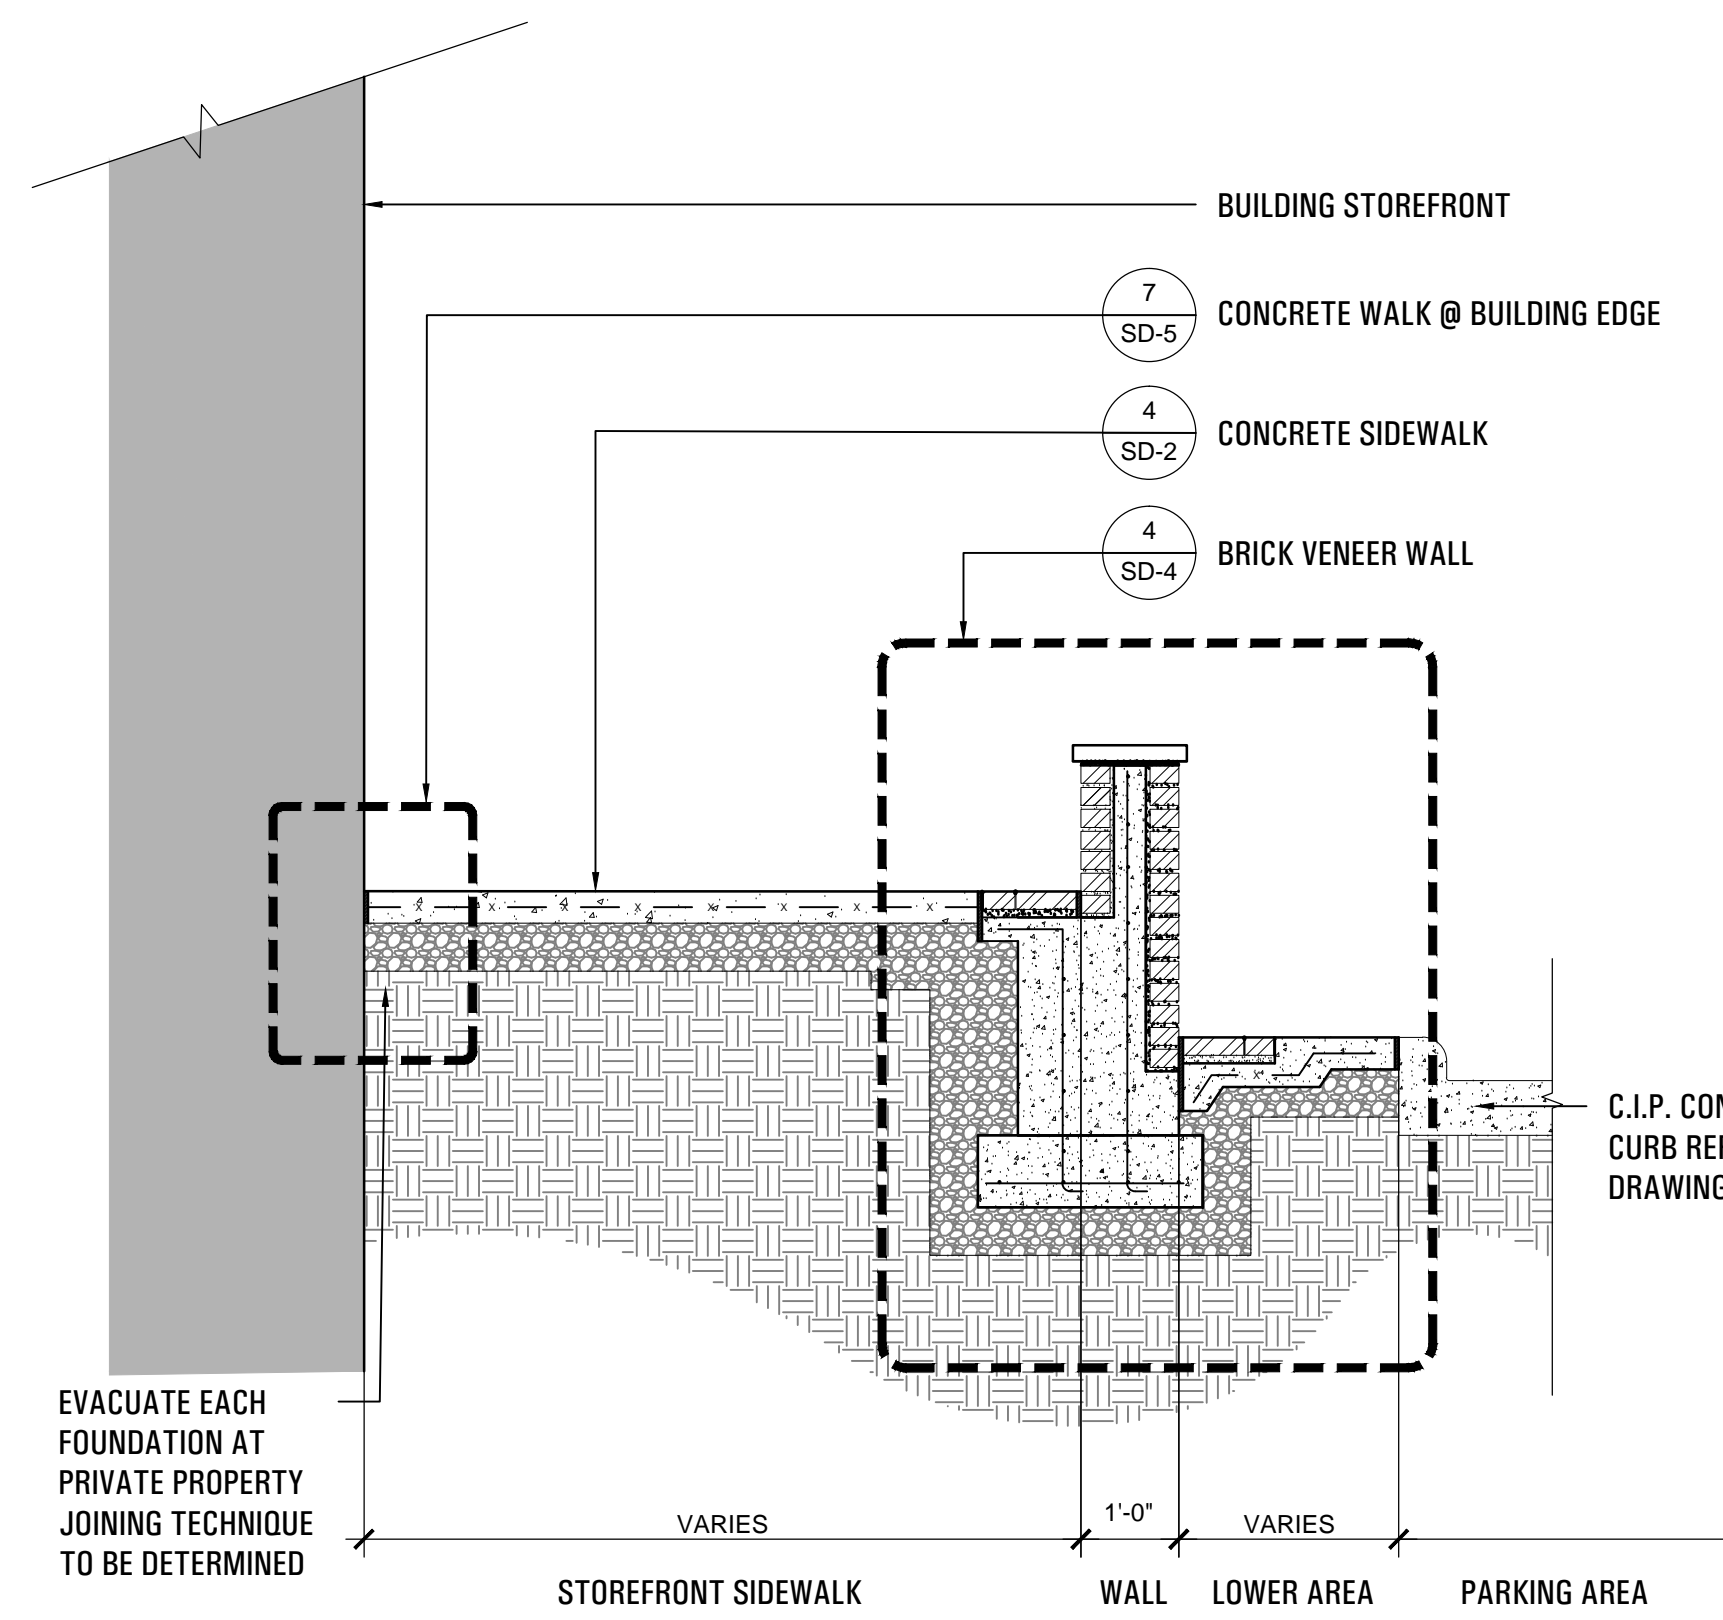


1 WALL SECTION
SCALE: 1/2" = 1'-0"

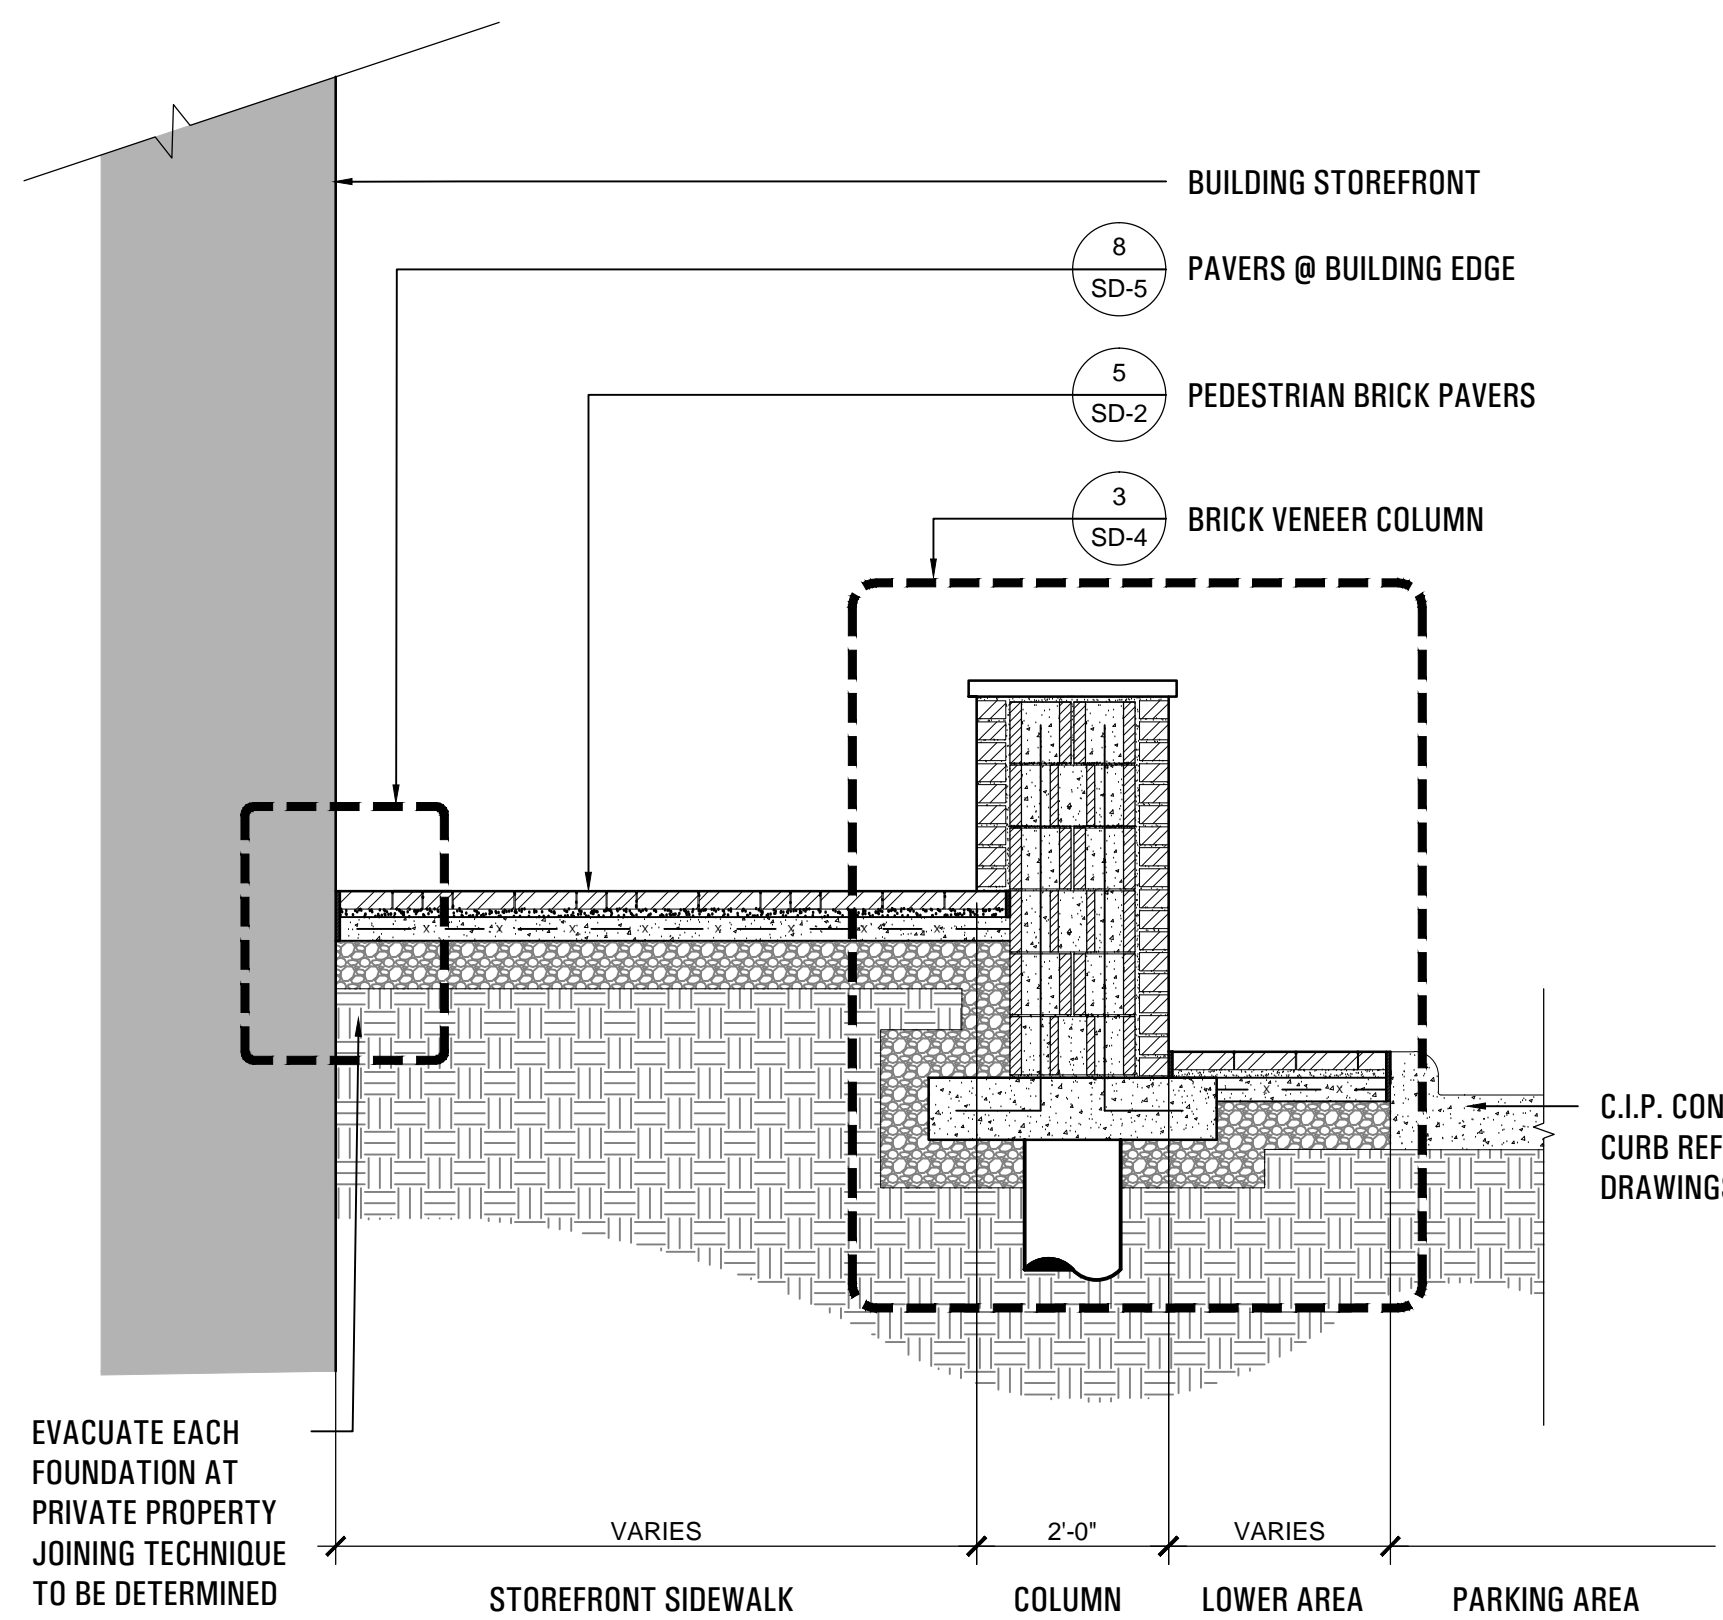


2 2' x 2' COLUMN SECTION
SCALE: 1/2" = 1'-0"

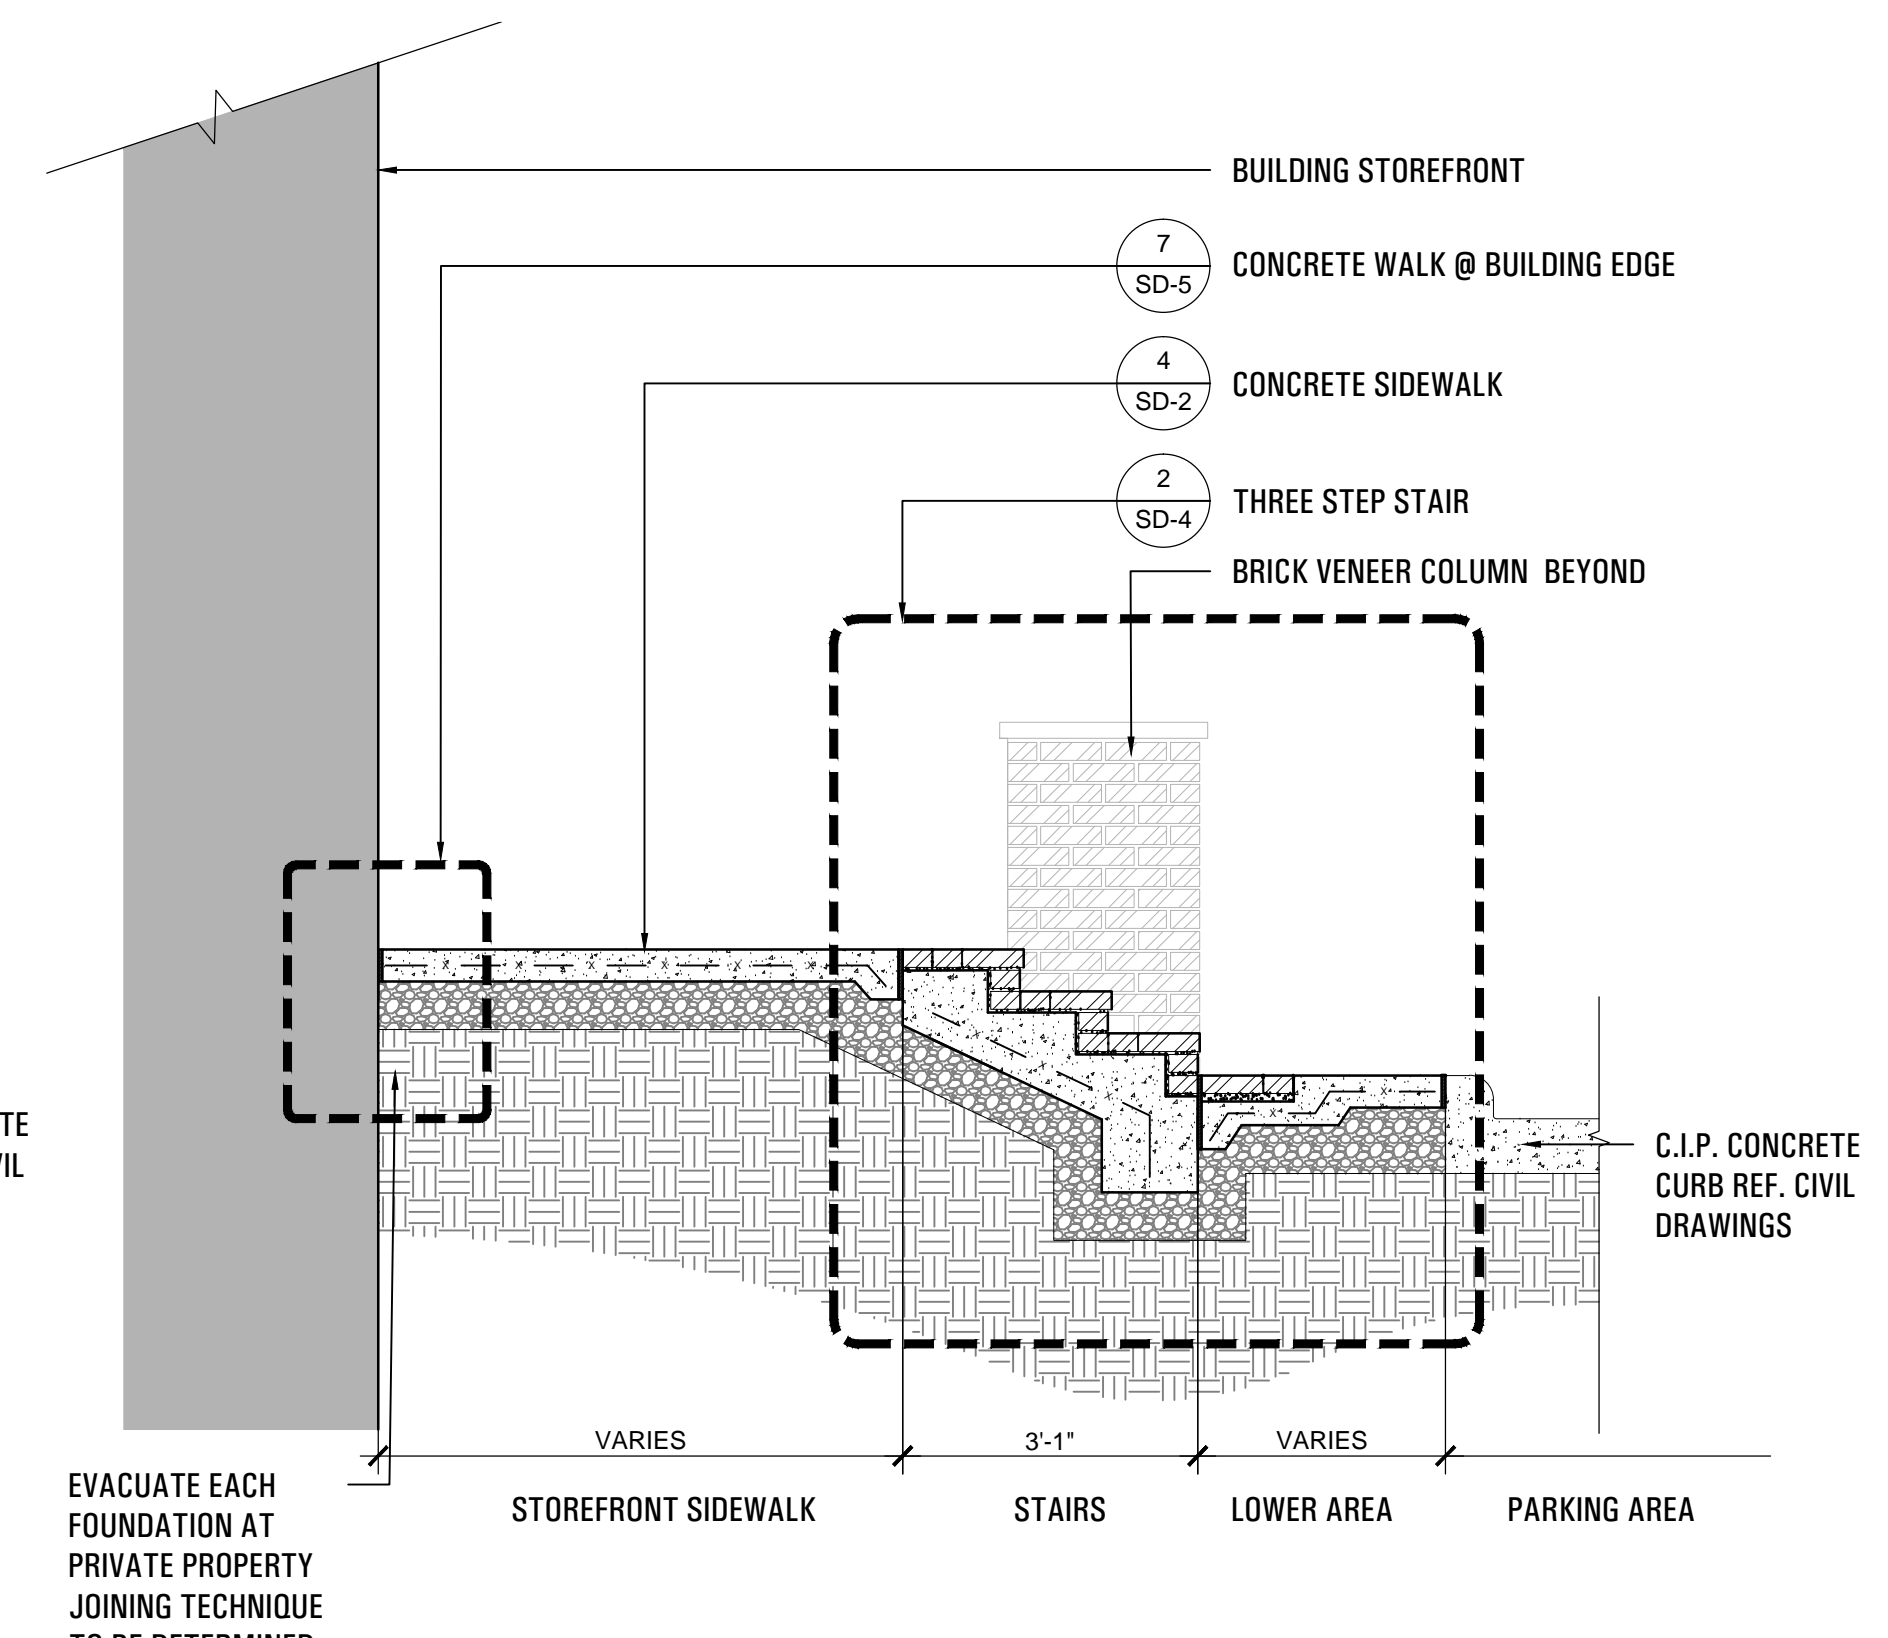


3 TYPICAL STOREFRONT THREE STEP SECTION
SCALE: 1/2" = 1'-0"

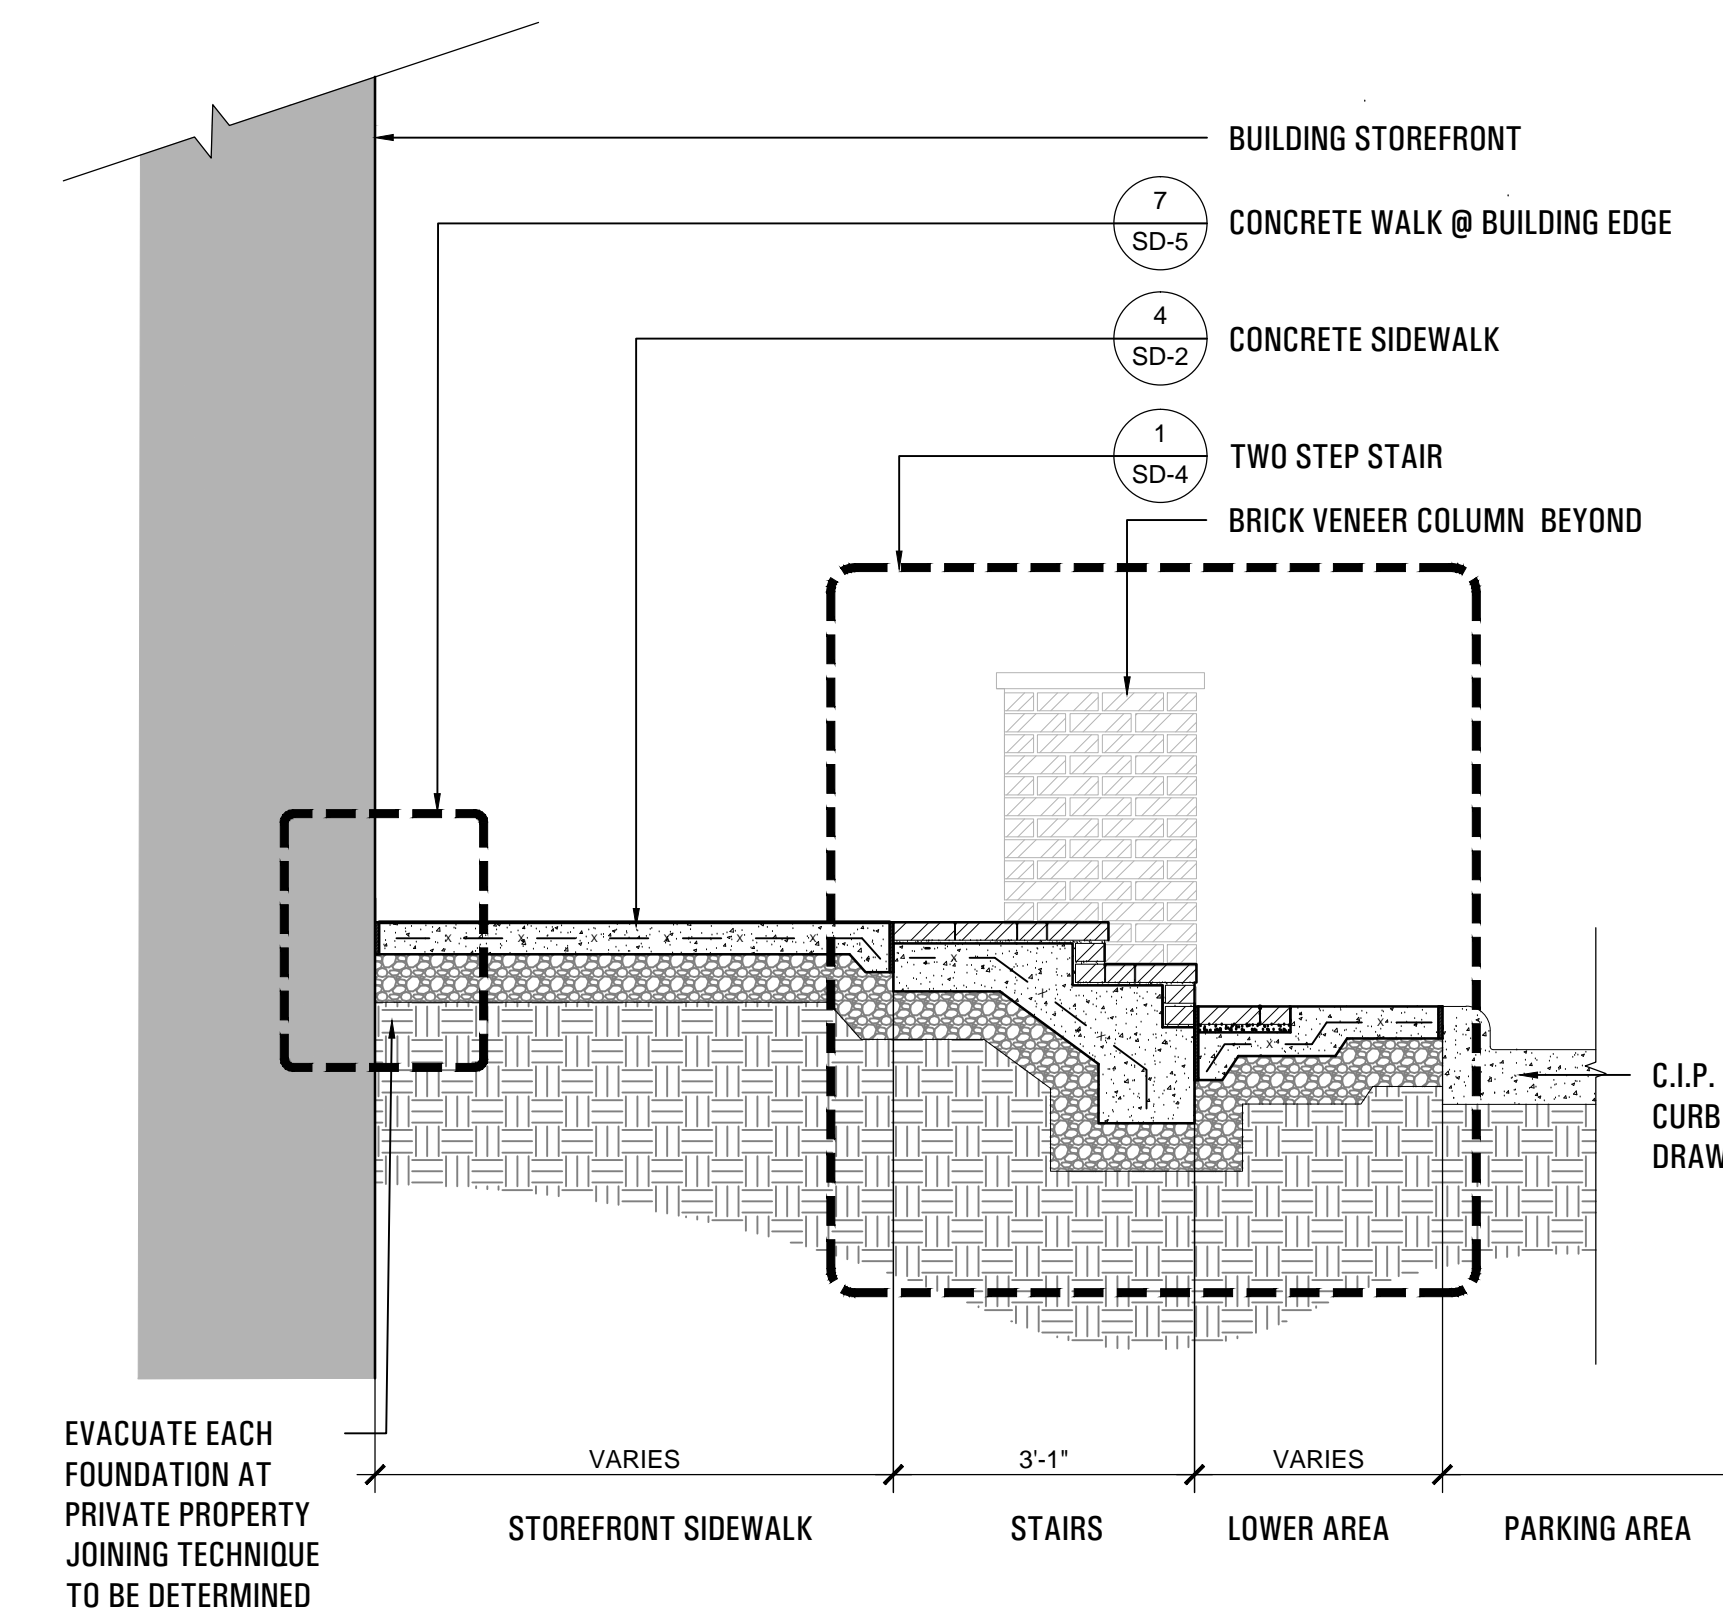


4 TYPICAL STOREFRONT TWO STEP SECTION
SCALE: 1/2" = 1'-0"

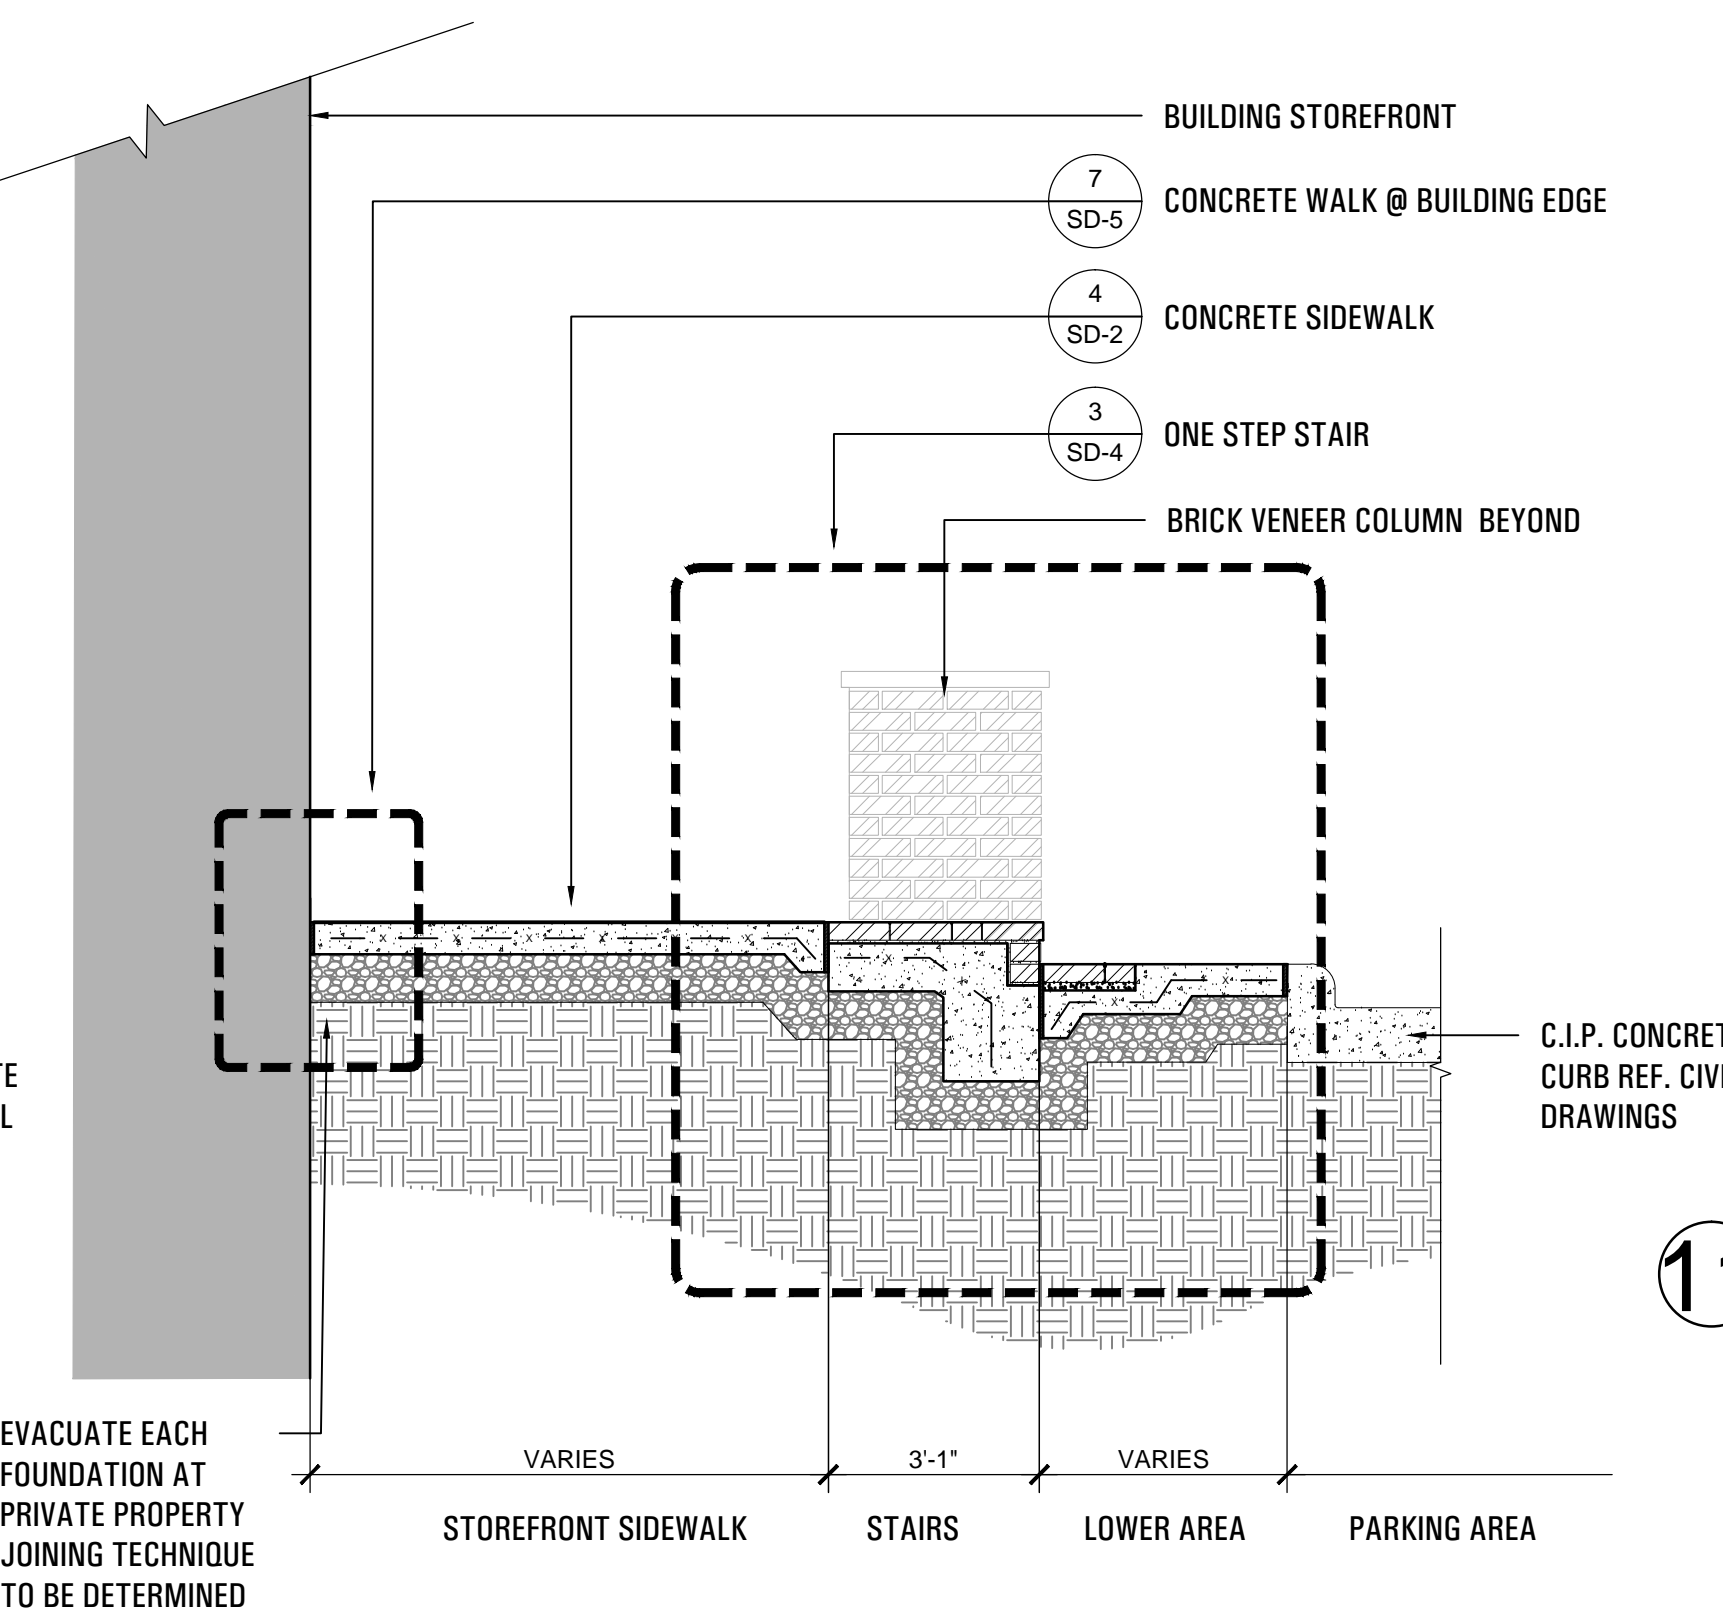


5 TYPICAL STOREFRONT ONE STEP SECTION
SCALE: 1/2" = 1'-0"

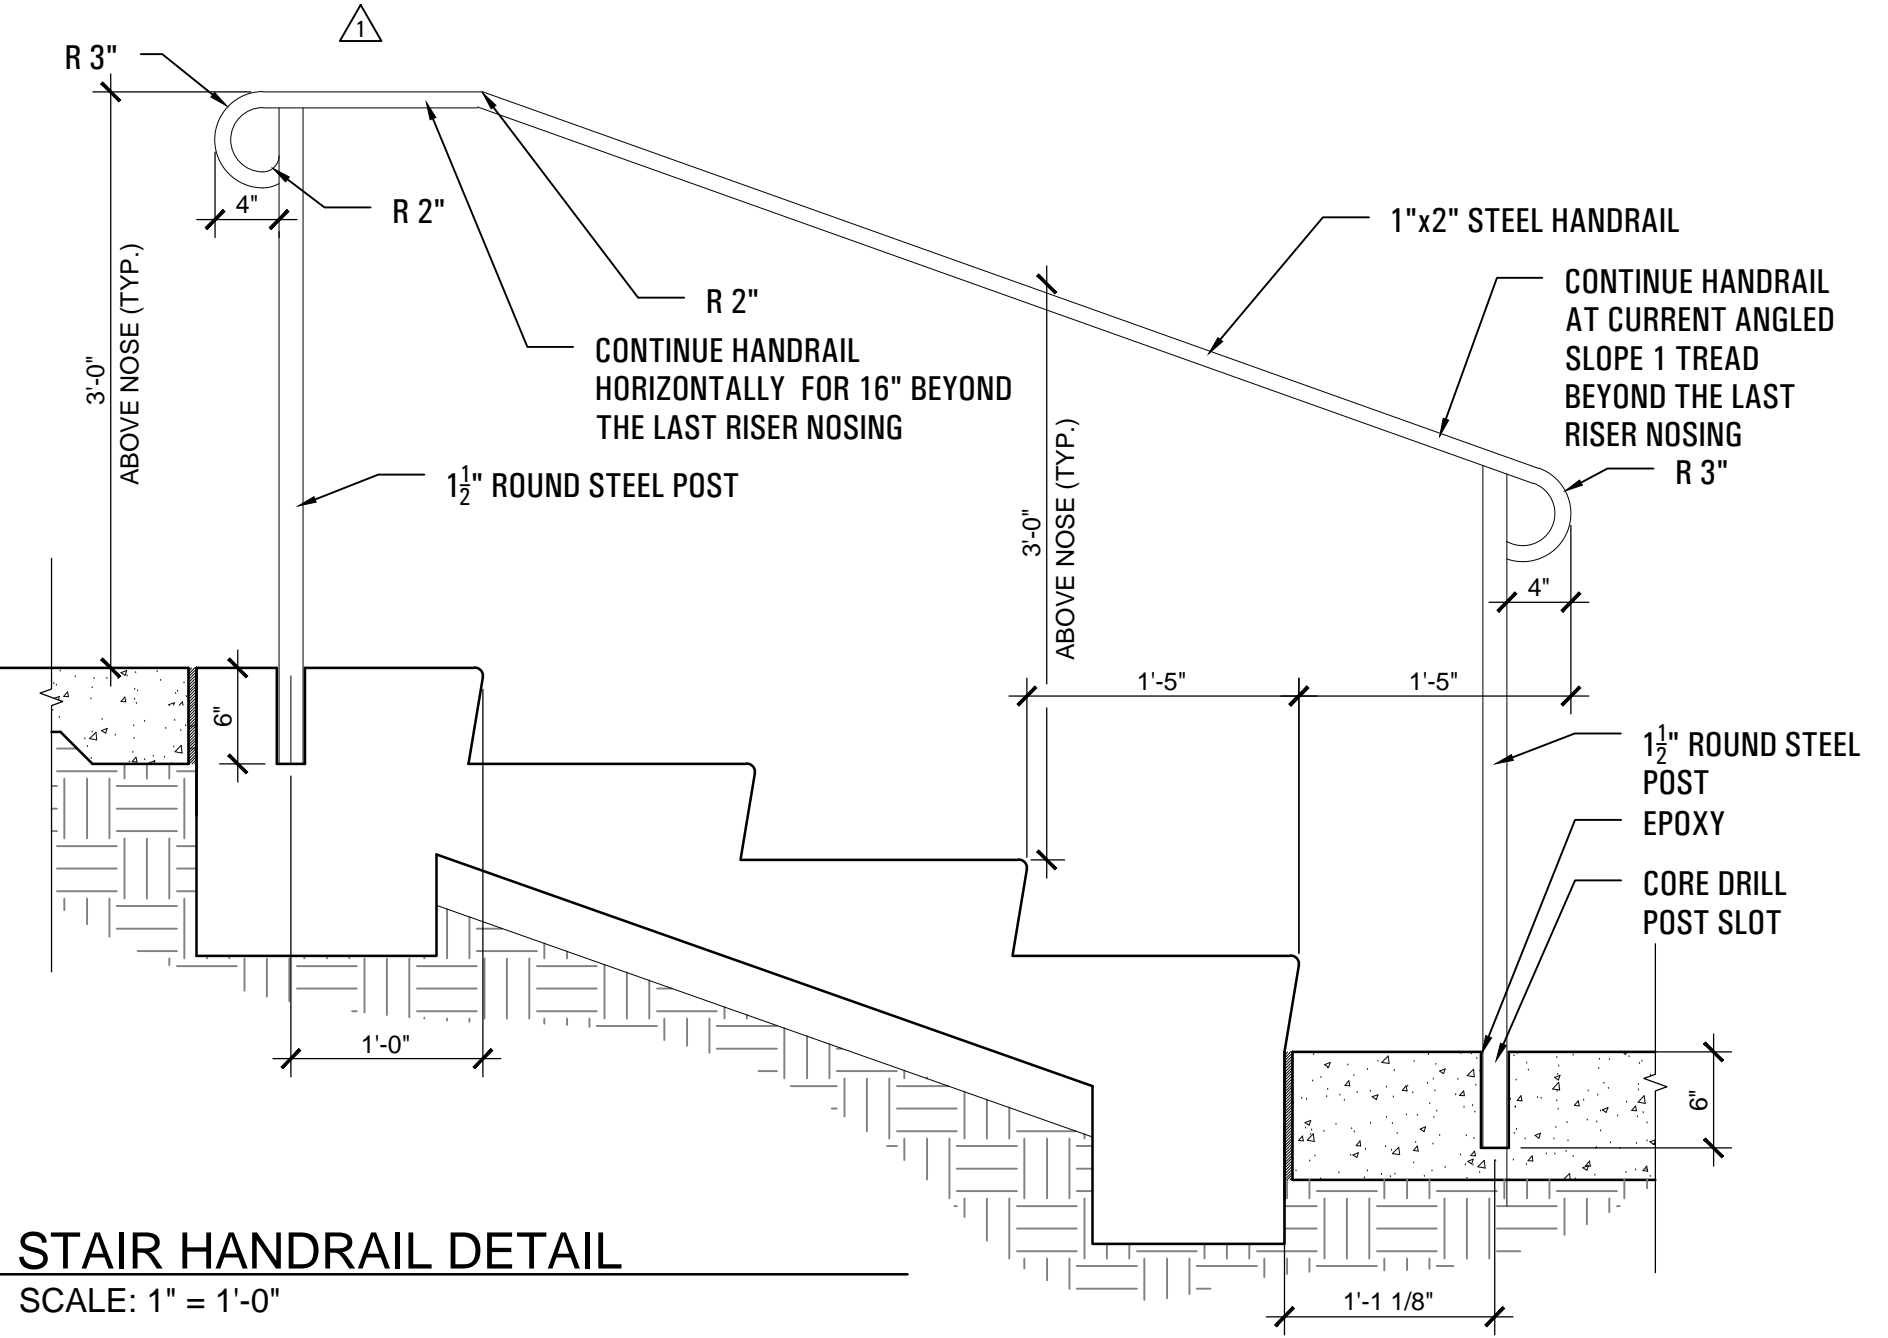


11 STAIR HANDRAIL DETAIL
SCALE: 1" = 1'-0"

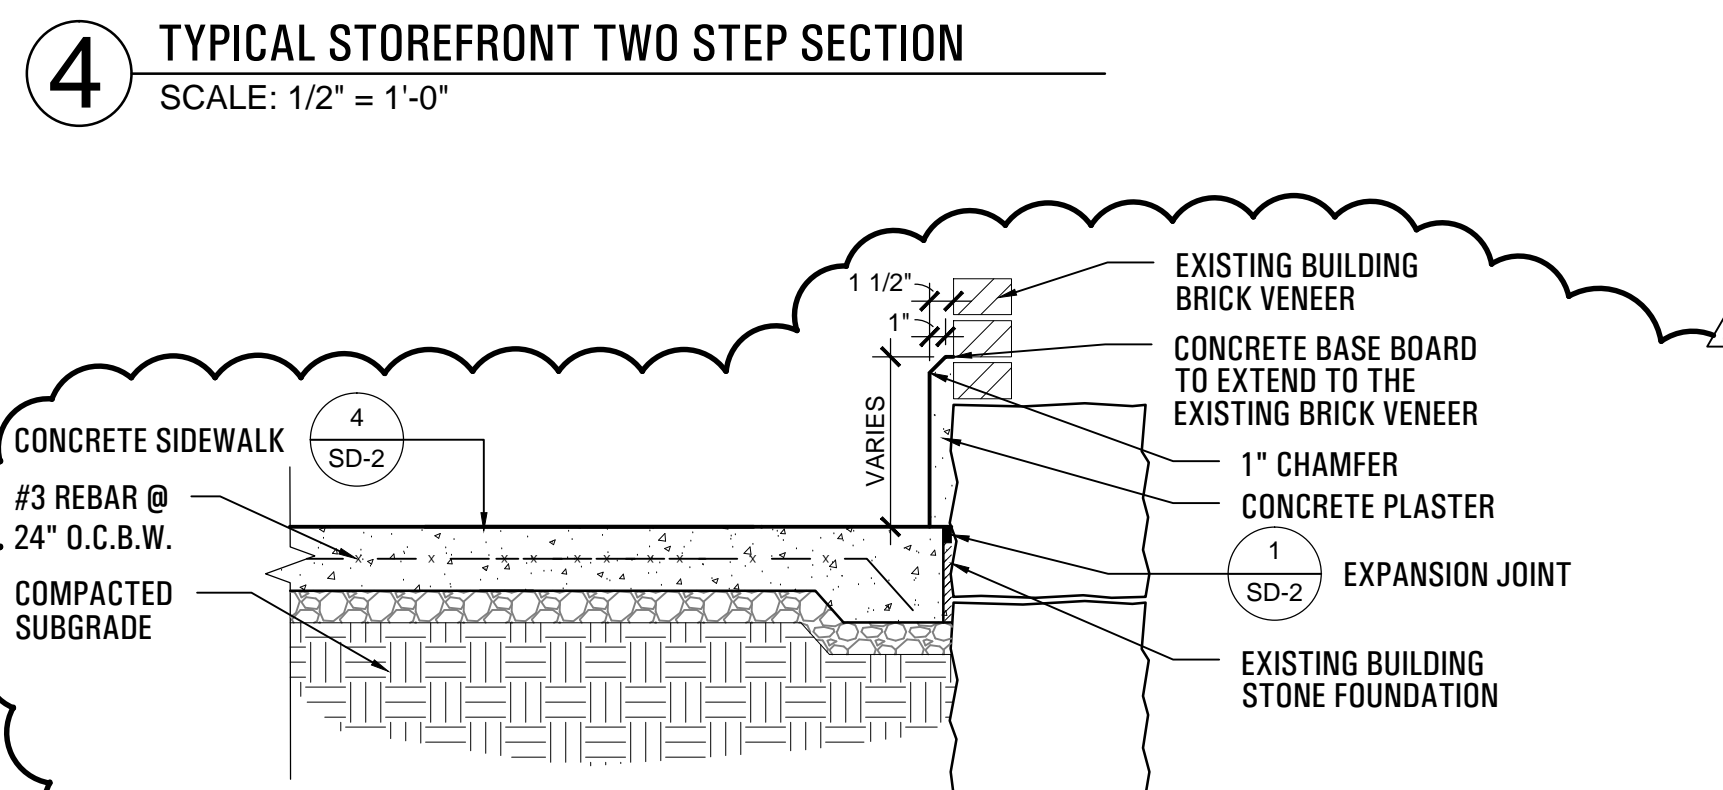

6 CONCRETE BASE BOARD
SCALE: 1" = 1'-0"

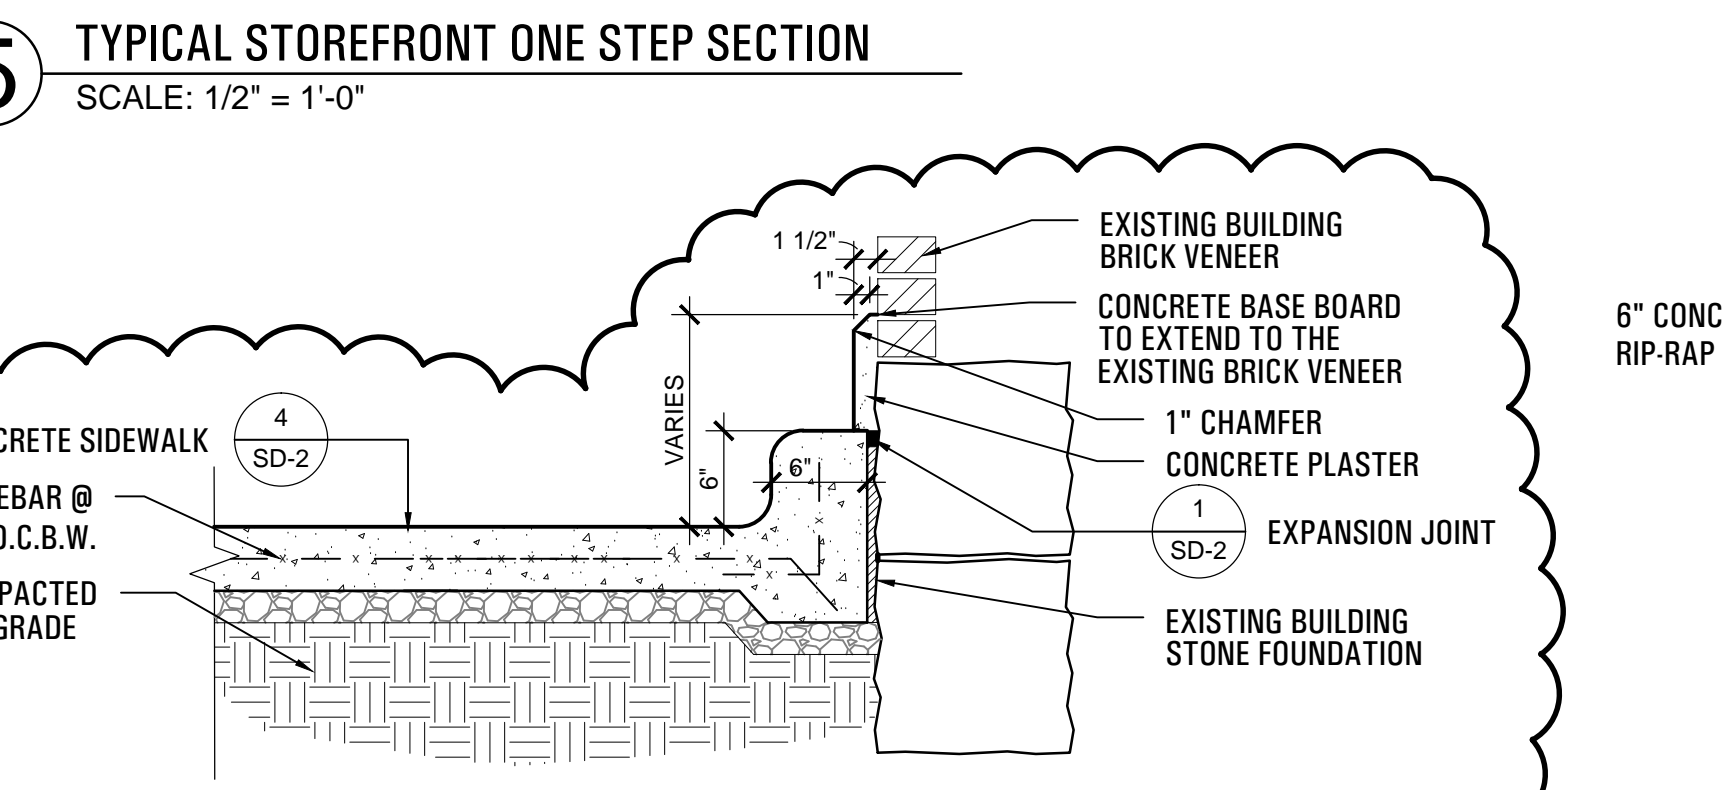

7 CONCRETE BASE BOARD WITH 6\"/>

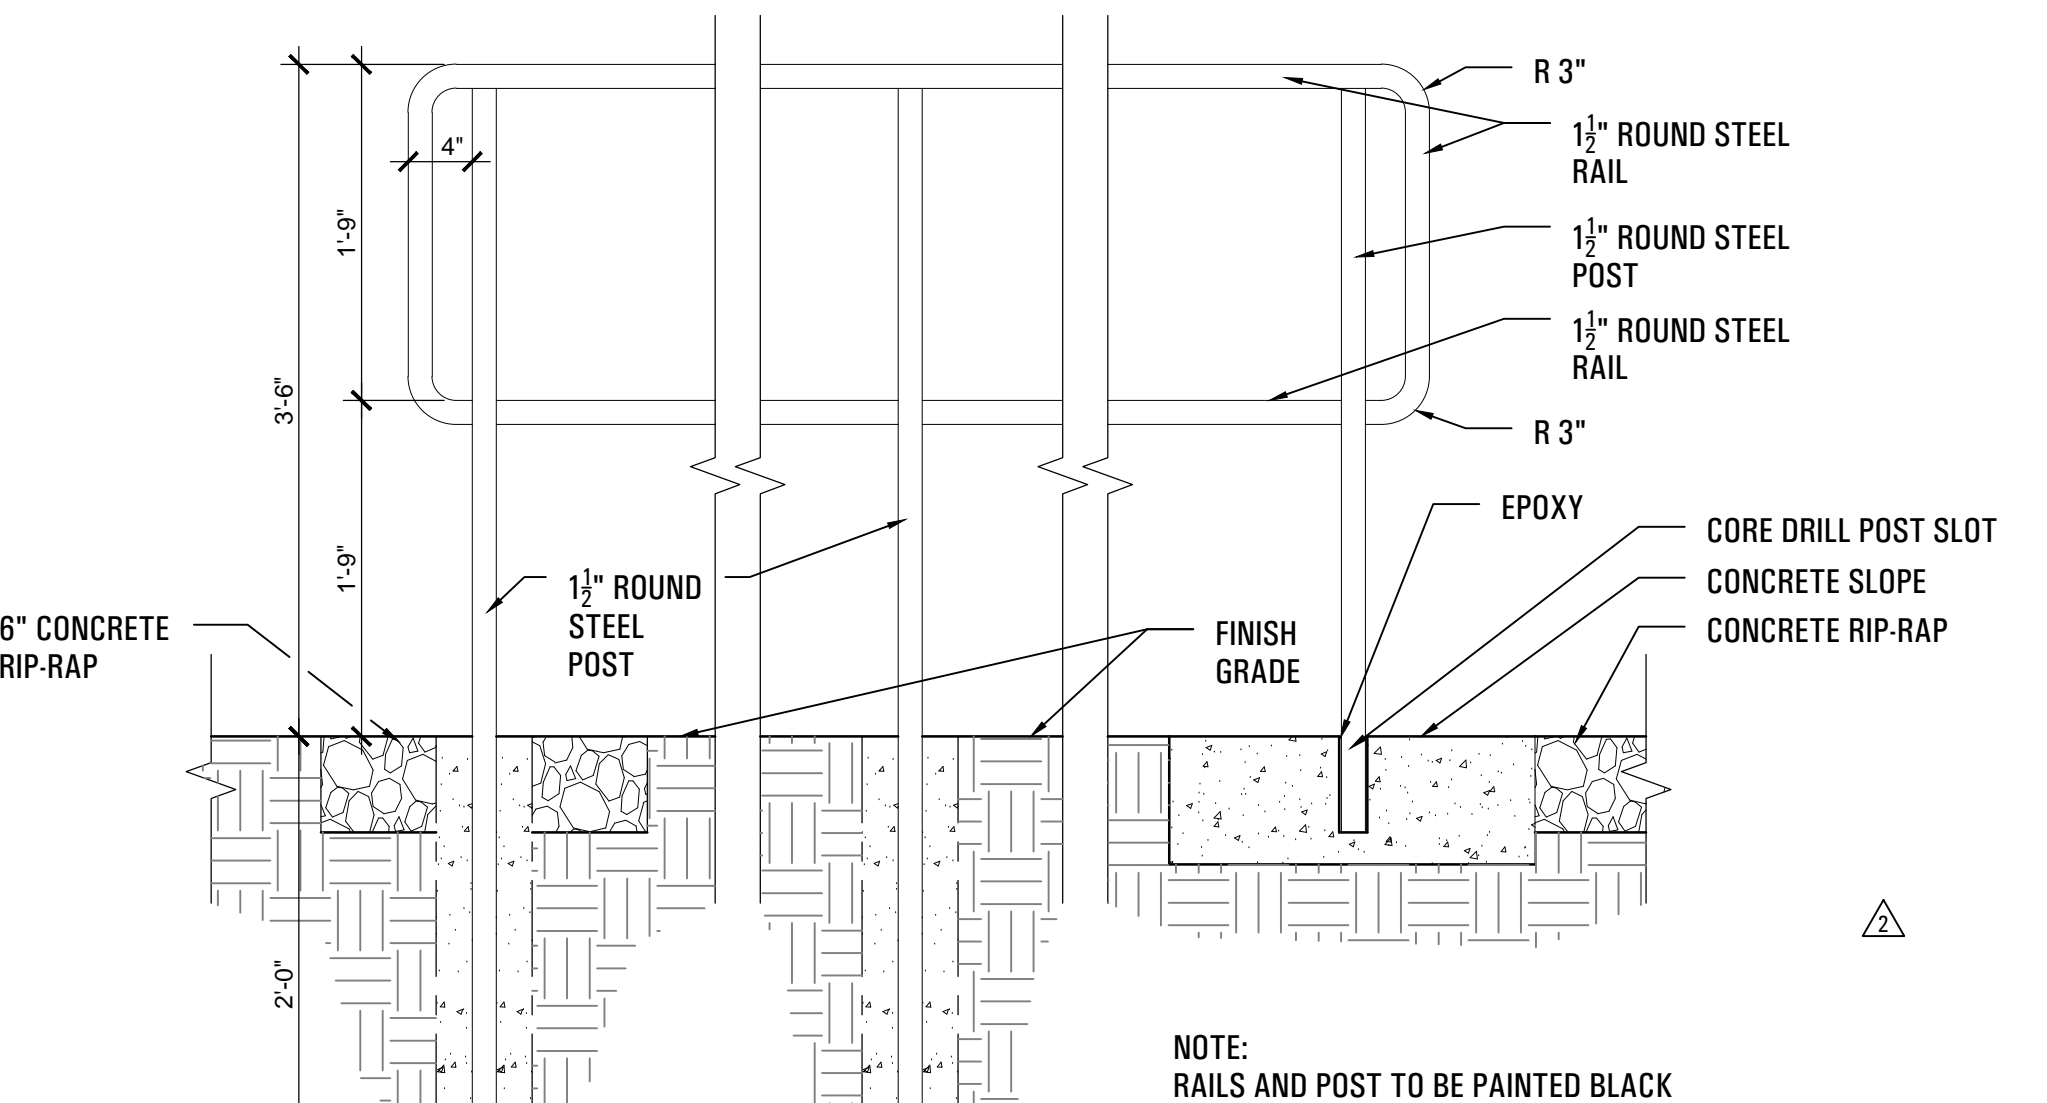


12 HEADWALL RAIL DETAIL
SCALE: 1" = 1'-0"



submittals / revisions

no.	date	detail
△	08/12/14	RFI #117
△	09/03/15	RFI #188
△	10/06/15	RFI #174

la terra studio, inc.
12024
its project number
02.26.2014
date
rac; bhm
drawn by
mtb
checked by

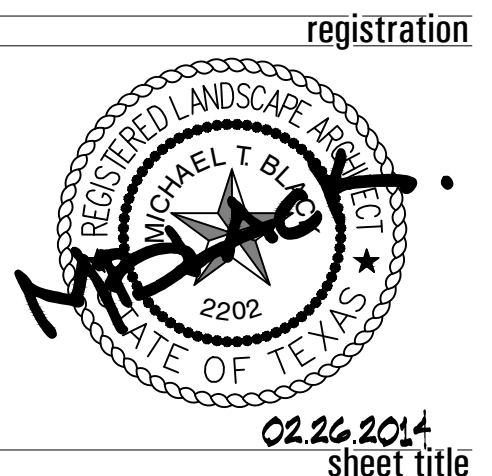

Site Details
sheet number

SD-1