


**1 NO PARKING SIGN**  
SCALE: 3/4" = 1'-0"

**SITE PLAN LEGEND:**

- PHASE 1 PROJECT LIMIT LINE
- EDGE OF PAVEMENT
- CONCRETE SIDEWALK PAVEMENT
- CONCRETE VEHICULAR PAVEMENT
- CONCRETE DUMPSYR PAD PAVEMENT
- TYPICAL LIGHT FIXTURE

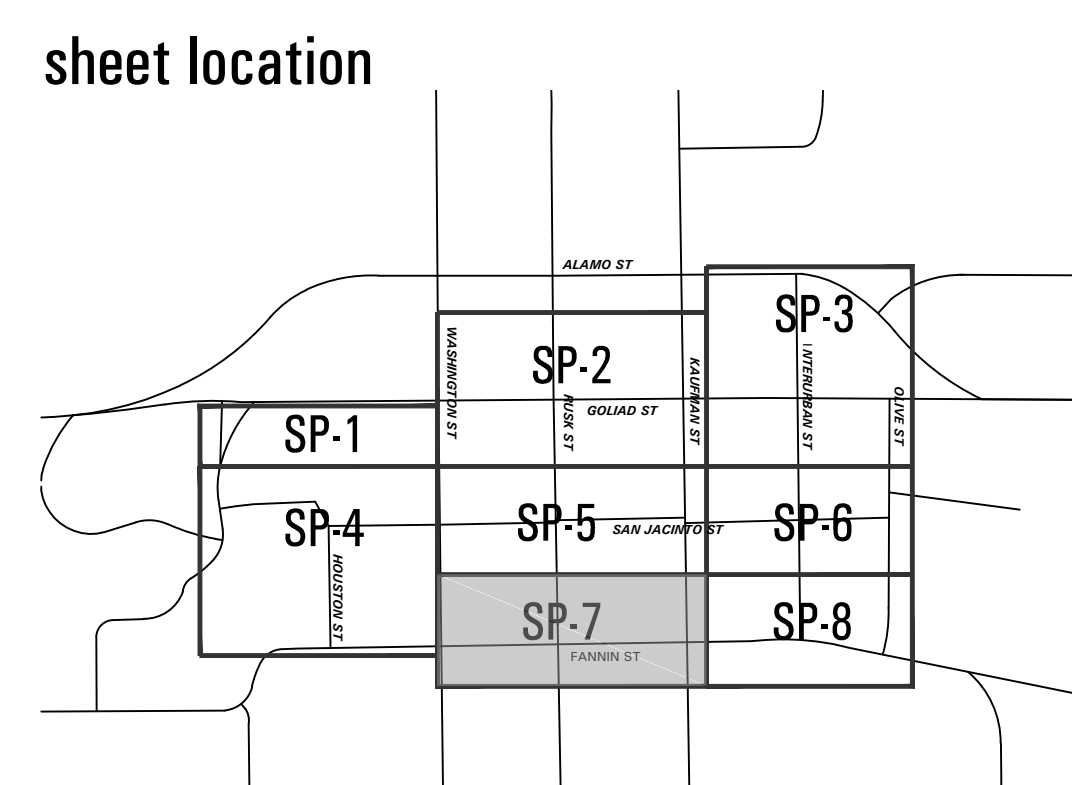

**Downtown Rockwall**  
streetscape improvements  
PHASE 2  
rockwall, texas

submittals / revisions

no.	date	detail
△	05/08/14	RFI #20, #42, #43
△	05/18/14	RFI #37
△	05/27/14	RFI #71
△	07/18/14	RFI #108
△	09/30/14	RFI #123
△	04/06/15	RFI #171
△	04/22/15	LASI #16
△	10/08/15	RFI #174

la terra studio, inc.  
12024  
Its project number  
02.26.2014  
date  
rac; bhm  
drawn by  
mtb  
checked by

