

PLANT AND MATERIALS LIST: NOTE: CONTRACTOR TO VERIFY QUANTITIES PER PLANS

CANOPY TREES

	QNTY.	SYMBOL	COMMON NAME	BOTANIC NAME
		CP	CHINESE PISTACHE	PISTACHIA CHINENSIS
		RO	RED OAK	QUERCUS SHUMARDI

SHRUBS

	QNTY.	SYMBOL	COMMON NAME	BOTANIC NAME
		MF	MEXICAN FEATHER GRASS	STIPA TENIOSSIMA
		RDR	RED DRIFT ROSE	ROSA 'MEIGALPIO'

TURF


	QNTY.	SYMBOL	COMMON NAME	BOTANIC NAME
		SSSAG	SOLID SOD ST. AUGUSTINE GRASS	STENOTAPHRUM SECUNDATUM
		SSBG	SOLID SOD BERMUDA GRASS	Cynodon dactylon

EXISTING TREE

	QNTY.	SYMBOL	NOTE
		PER PLAN	REFERENCE CIVIL DEMO PLANS FOR TREE PRESERVATION.



sheet location

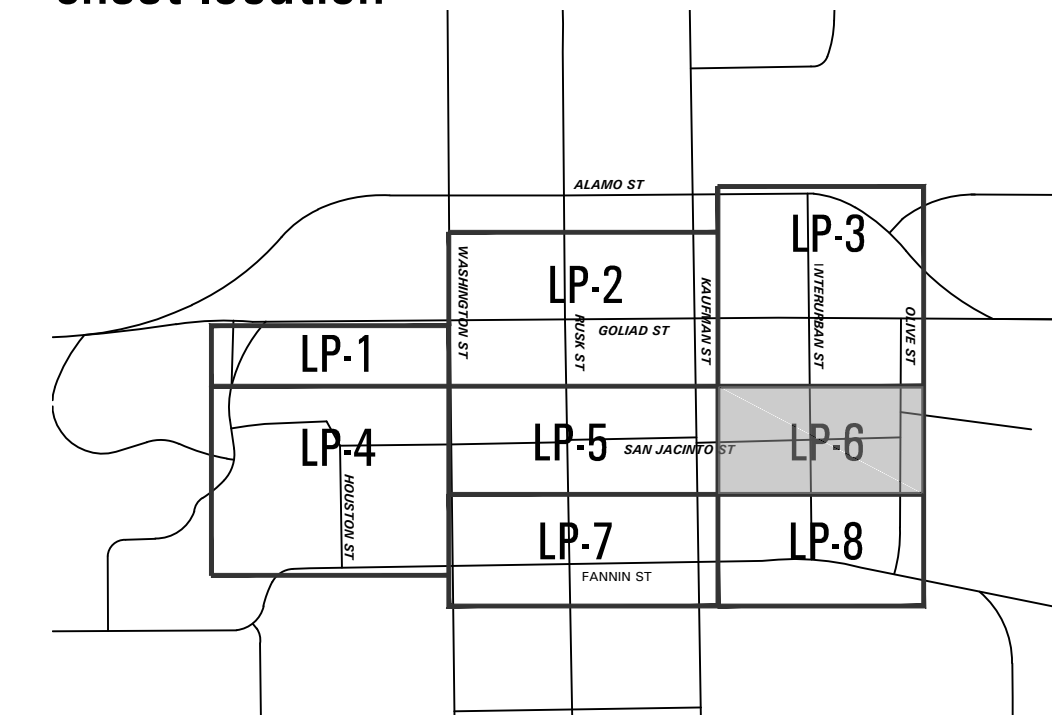

submittals / revisions

no.	date	detail
△	03/11/15	RFI #162
△	05/01/15	RFI #176

la terra studio, inc.
 12024
 lts project number
 02.26.2014
 date
 rac; bhm
 drawn by
 mtb
 checked by

