



© 2013 la terra studio, inc. All Rights Reserved FILE:P:\12024-Downtown Rockwall PSS&E - Rockwall\CAD\18-SHEET\12024_SP1-7.dwg

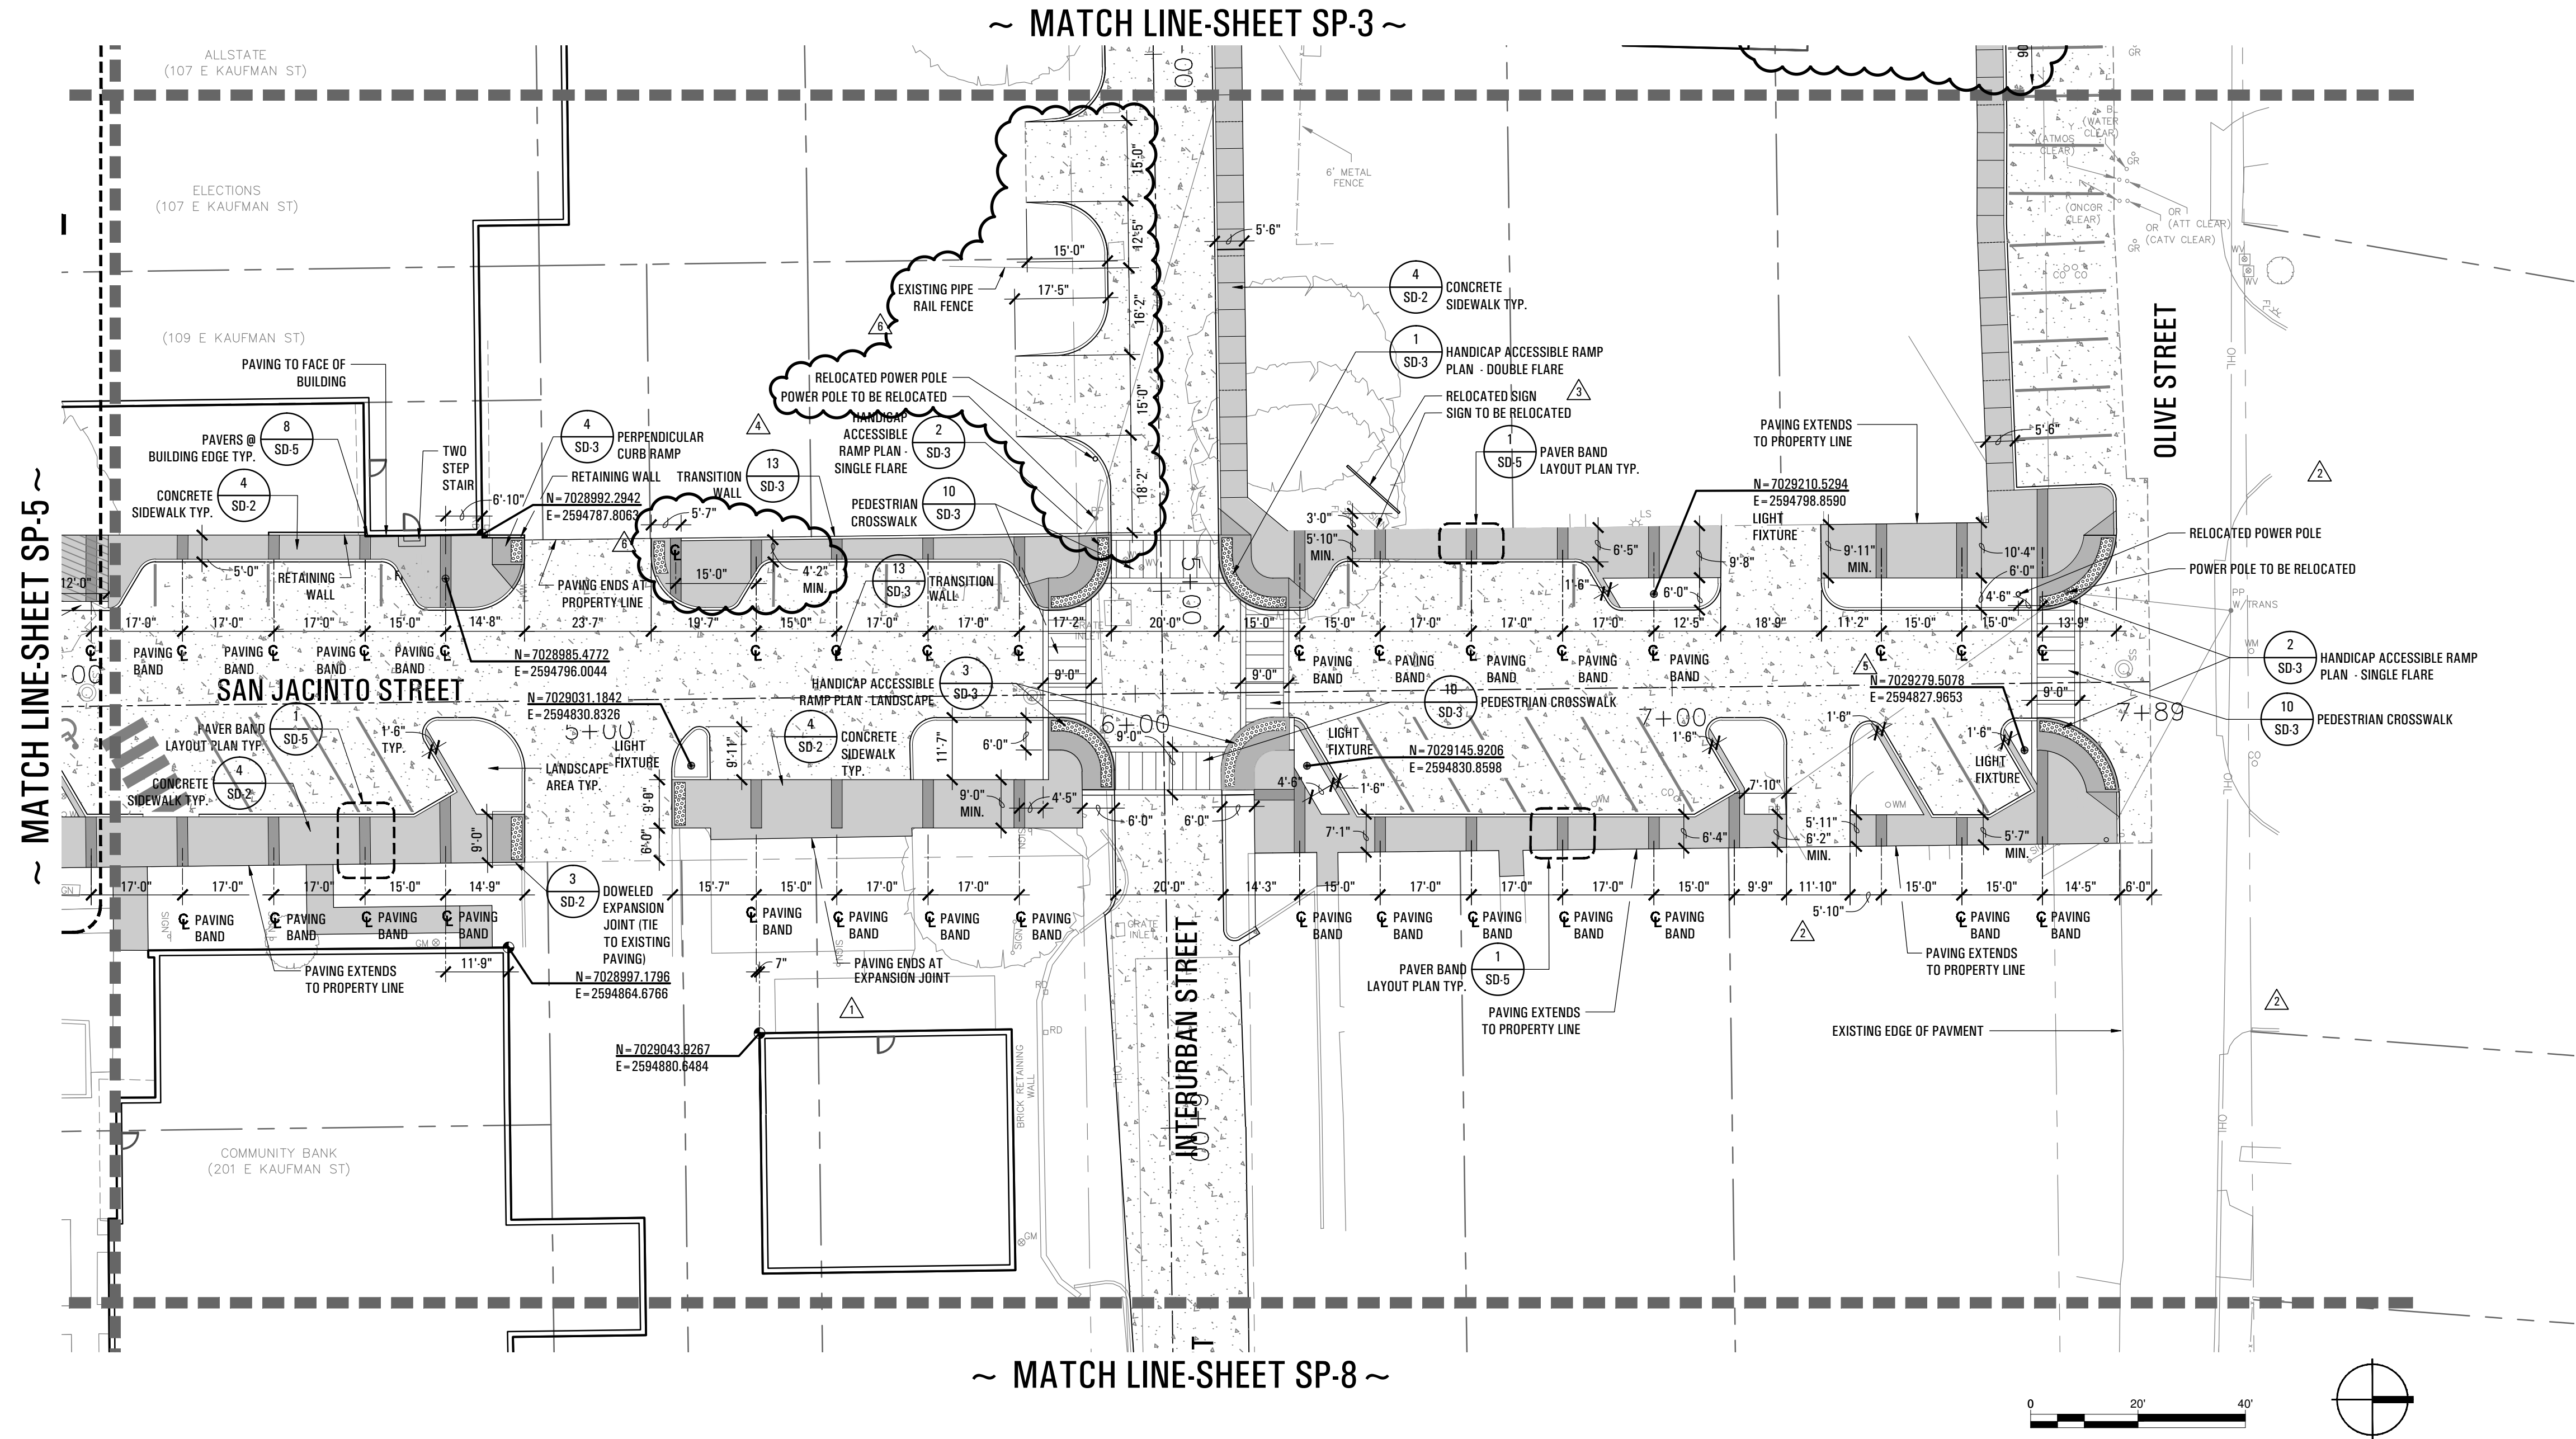

SITE PLAN LEGEND:

- EDGE OF PAVEMENT
- CONCRETE SIDEWALK PAVEMENT
- CONCRETE VEHICULAR PAVEMENT
- TYPICAL LIGHT FIXTURE

sheet location

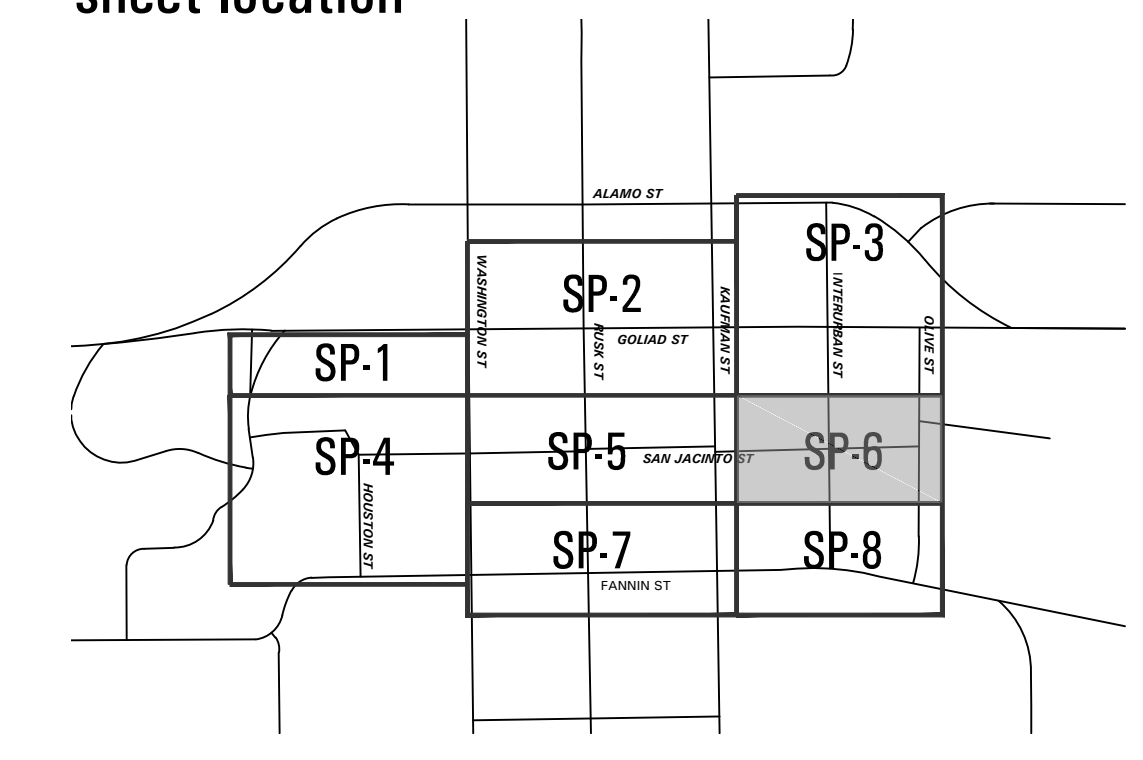

Downtown Rockwall
 la terra studio Project #12024
streetscape improvements
 PHASE 2
 rockwall, texas




submittals / revisions

no.	date	detail
1	12/02/14	LASI #13
2	12/08/14	RFI #151
3	12/22/14	RFI #150
4	02/10/15	RFI #159
5	03/11/15	RFI #162
6	05/01/15	RFI #175, #176

la terra studio, inc.

12024
 Its project number
 02.26.2014
 date
 rac; bhm
 drawn by
 mtb
 checked by

registration

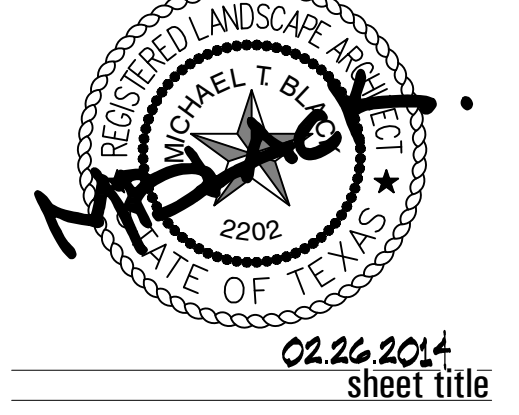

Site Plan
 sheet number
SP-6