



© 2013 la terra studio, inc. All Rights Reserved FILE:P:\12024-Downtown Rockwall PSS&E - Rockwall\CAD\SSHEETS\12024\_Enlargement\_Plan\_key.dwg

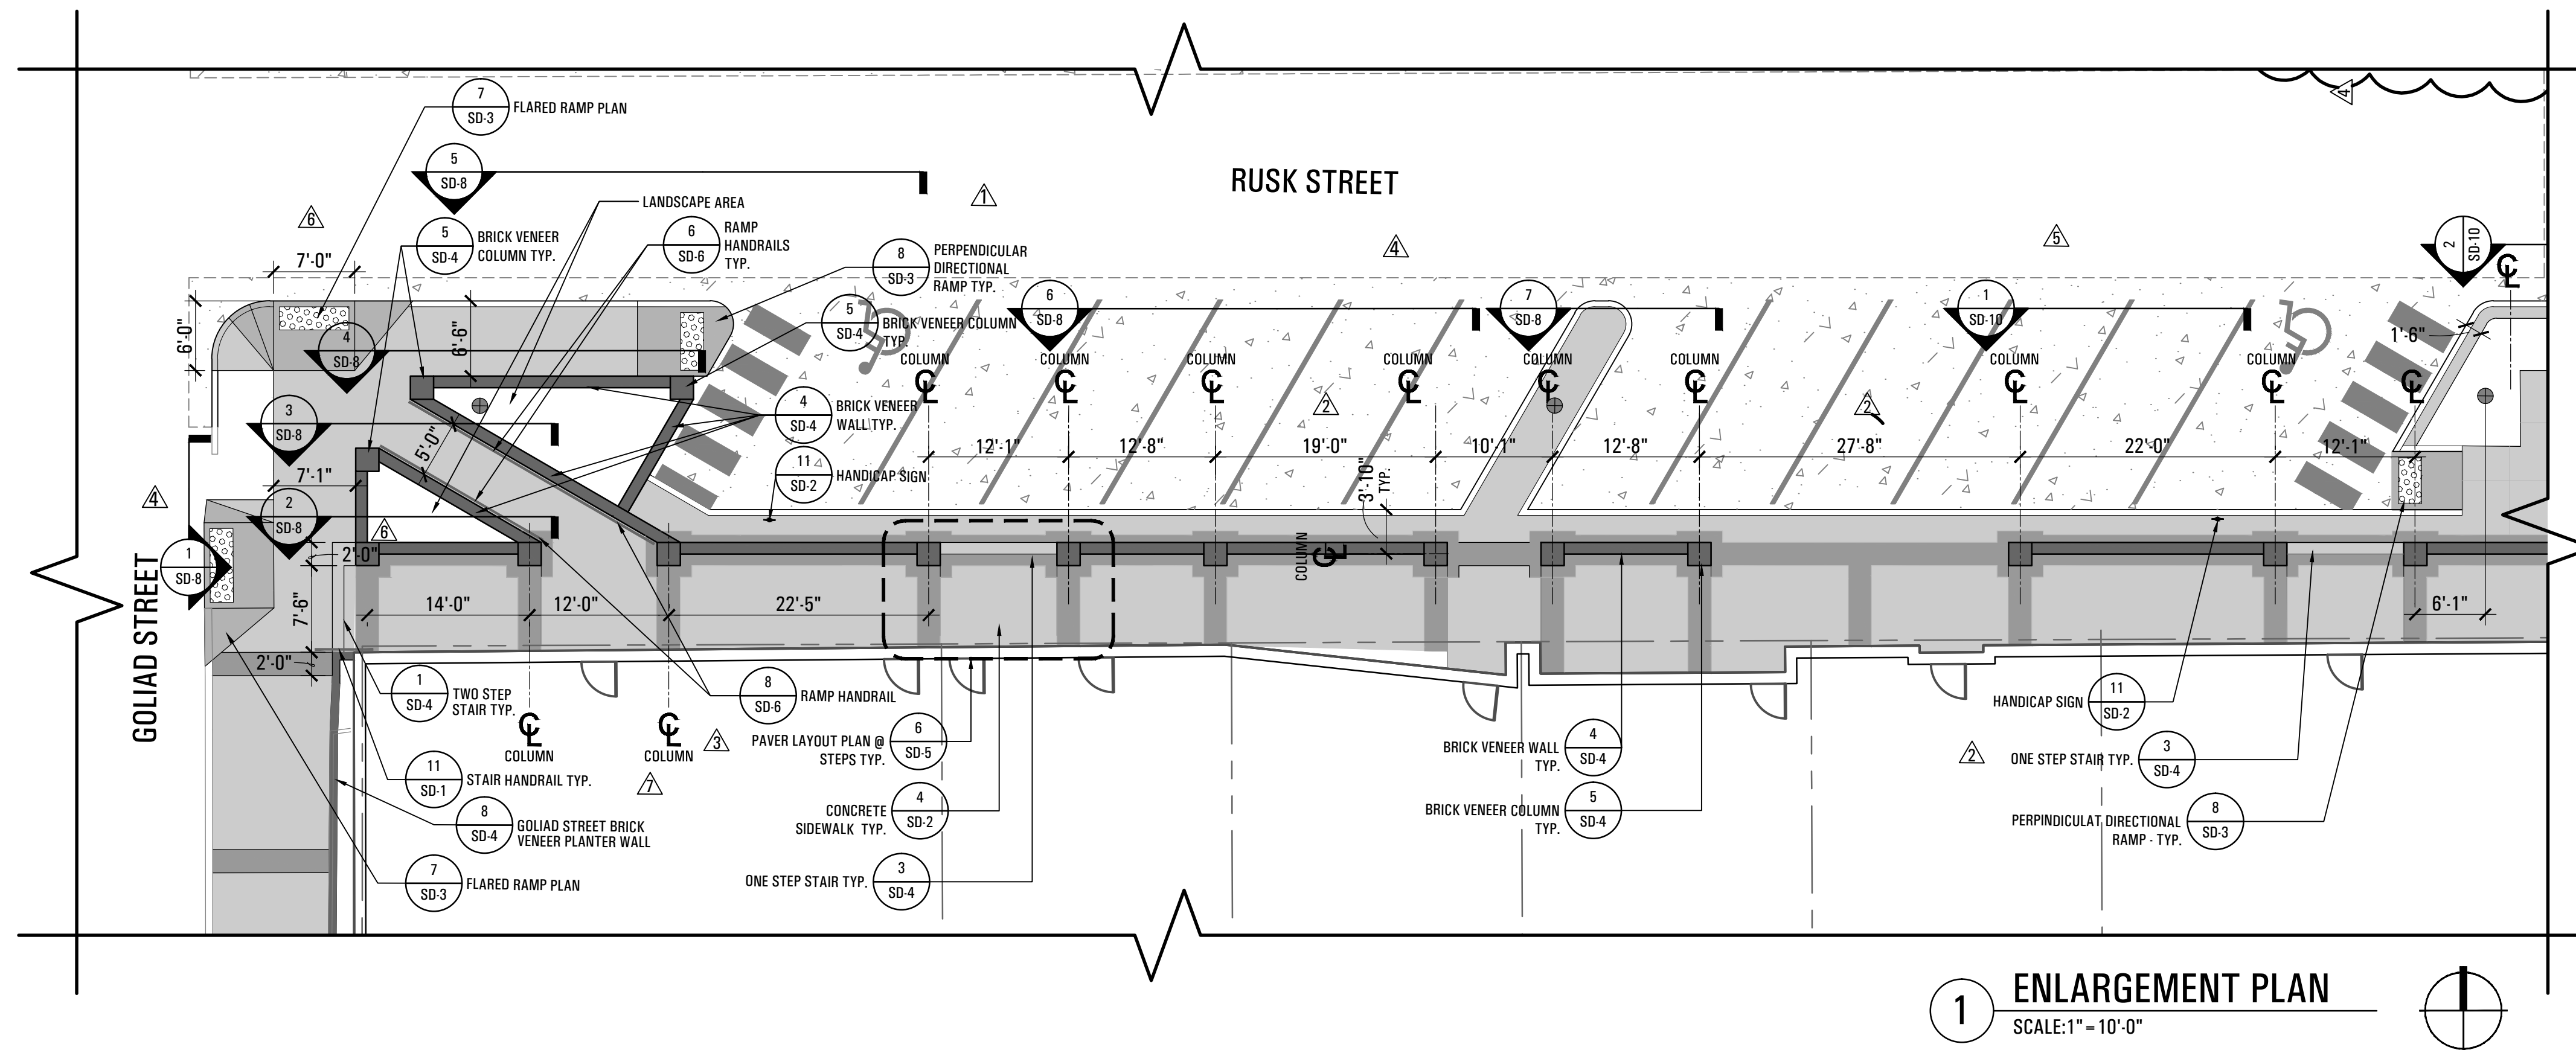

1 ENLARGEMENT PLAN  
SCALE: 1" = 10'-0"

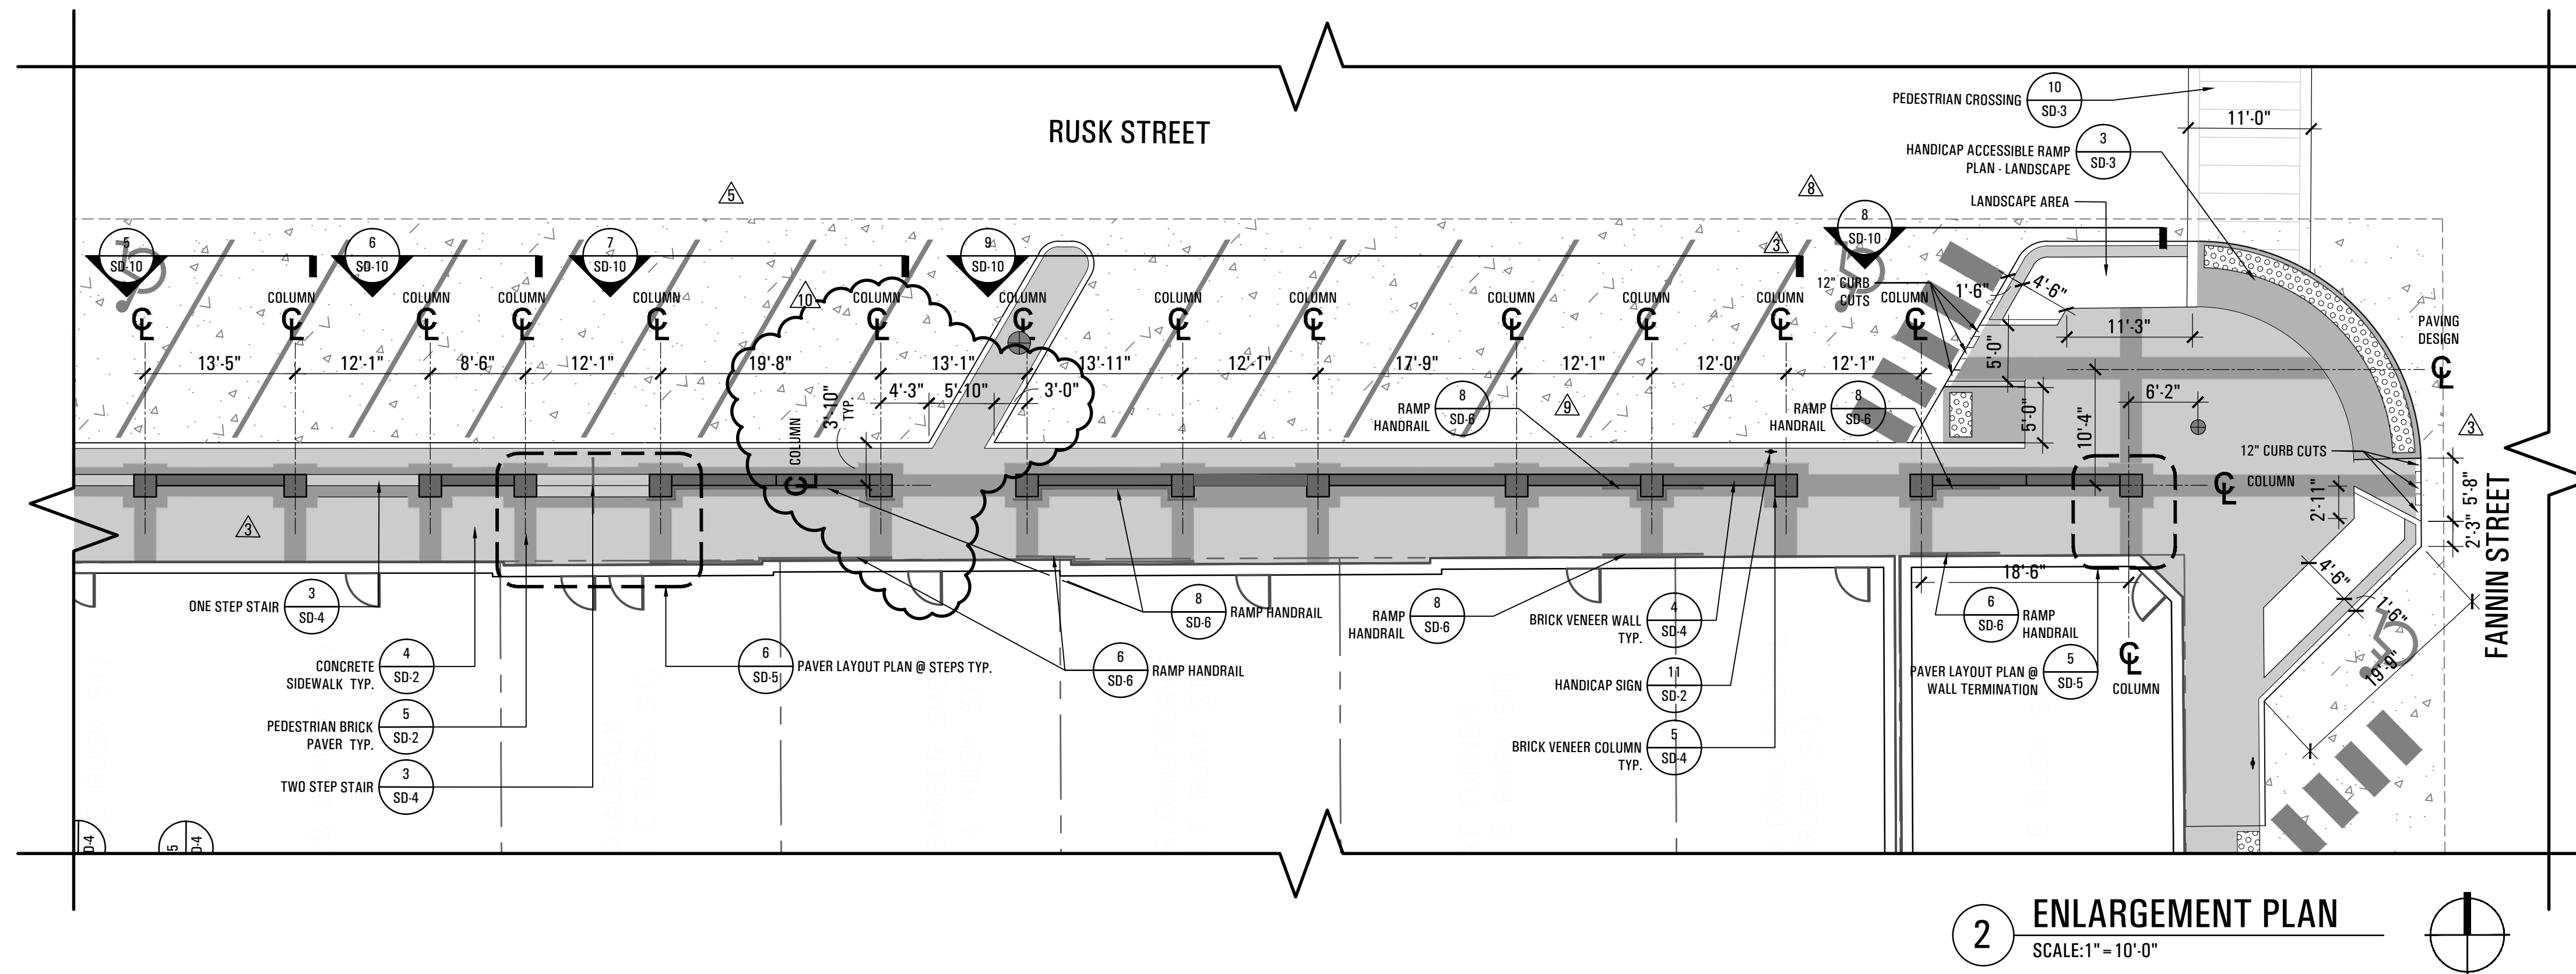

2 ENLARGEMENT PLAN  
SCALE: 1" = 10'-0"

SITE PLAN LEGEND:

- EDGE OF PAVEMENT
- CONCRETE SIDEWALK PAVEMENT
- CONCRETE VEHICULAR PAVEMENT
- TYPICAL LIGHT FIXTURE

04/27/15 RFI #177

**Downtown Rockwall**  
 la terra studio Project #12024  
 streetscape improvements  
 PHASE 2  
 rockwall, texas



submittals / revisions

no.	date	detail
△	04/14/14	RFI #39
△	05/02/14	RFI #77 WEST RUSK GRADING
△	05/08/14	RFI #20, #38, #42, #43, #54
△	06/17/14	RFI #93
△	07/31/14	LASI #10
△	10/27/14	RFI #140
△	11/17/14	RFI #144
△	11/28/14	LASI #12
△	01/13/15	RFI #154

la terra studio, inc.

12024  
 Its project number  
 02.26.2014  
 date  
 rac; bhm  
 drawn by  
 mtb  
 checked by

