


**GRADING PLAN LEGEND:**

580	EXISTING GRADE CONTOUR
581	FINISH GRADE CONTOUR
587.25	FINISH SPOT GRADE
580.00	SEE CIVIL FOR CROSS REFERENCE OF PROPOSED ELEVATION
TS	TOP STEP
BS	BOTTOM STEP
TW	TOP OF WALL
BW	BOTTOM OF WALL
TC	TOP OF CURB
G	GUTTER
FF	FINISH FLOOR
TOL	TOP OF COLUMN

**sheet location**

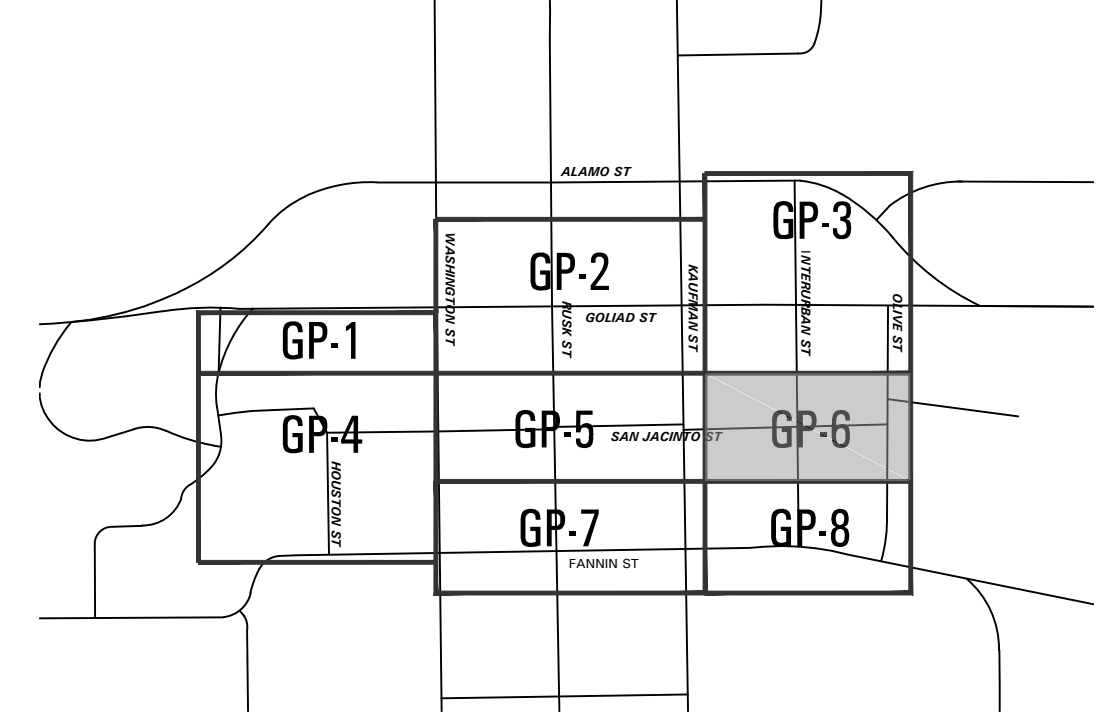

**Downtown Rockwall**  
 la terra studio Project #12024  
**streetscape improvements**  
 PHASE 2  
 rockwall, texas

submittals / revisions

no.	date	detail
△	12/02/14	RFI #62, #63, #64, LASI #13
△	01/19/15	RFI #156
△	02/10/15	RFI #159
△	05/01/15	RFI #175, #176
△	06/04/15	RFI #178

la terra studio, inc.  
 12024  
 Its project number  
 02.26.2014  
 date  
 rac; bhm  
 drawn by  
 mtb  
 checked by

registration

02.26.2014  
 sheet title

**Grading Plan**  
 sheet number  
**GP-6**