


SITE PLAN LEGEND:

- EDGE OF PAVEMENT
- CONCRETE SIDEWALK PAVEMENT
- CONCRETE VEHICULAR PAVEMENT
- TYPICAL LIGHT FIXTURE

sheet location

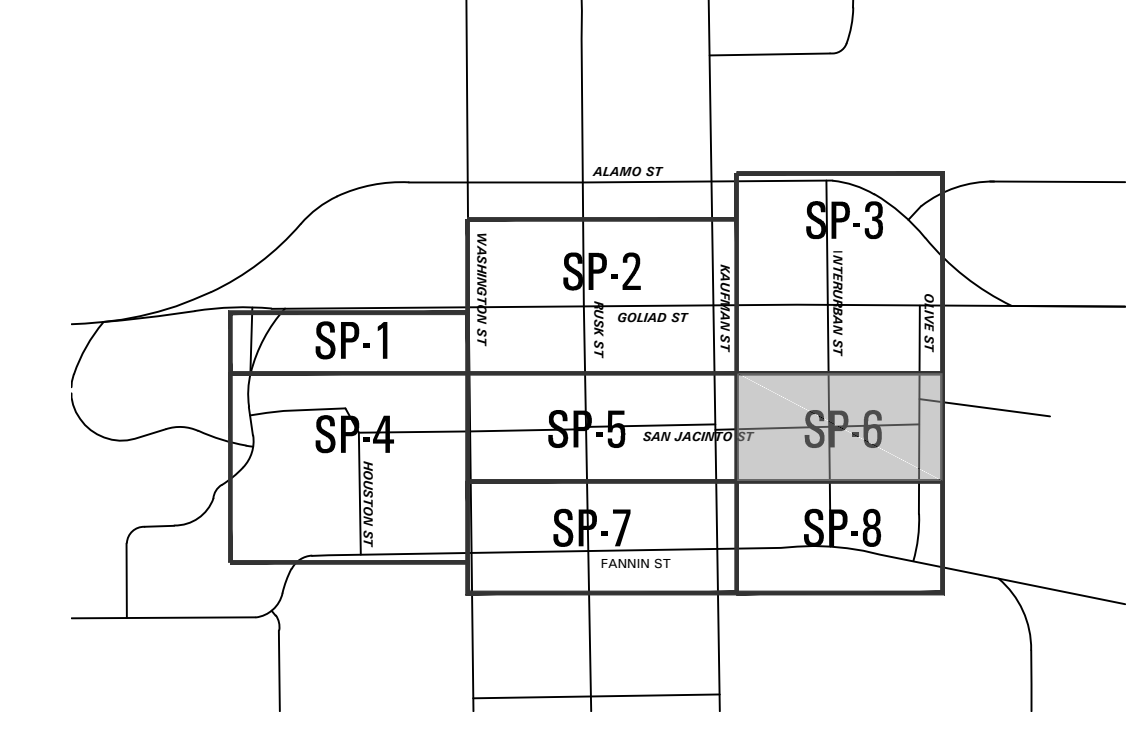

Downtown Rockwall
 la terra studio Project #12024
streetscape improvements
 PHASE 2
 rockwall, texas




submittals / revisions

no.	date	detail
1	12/02/14	LASI #13
2	12/08/14	RFI #151
3	12/22/14	RFI #150
4	02/10/15	RFI #159
5	03/11/15	RFI #162
6	05/01/15	RFI #175, #176
7	07/02/15	RFI #183
8	07/13/15	RFI #181

la terra studio, inc.

12024
 its project number
 02.26.2014
 date
 rac; bhm
 drawn by
 mtb
 checked by

registration

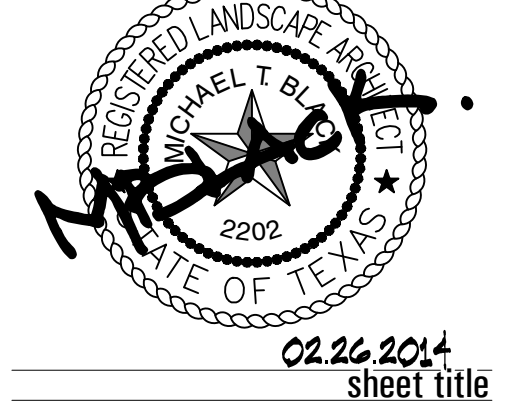

Site Plan
 sheet number
SP-6