


LEGEND:

	PROJECT LIMIT LINE
	TYPICAL LIGHT FIXTURE



Downtown Rockwall
 la terra studio Project #12024
streetscape improvements
 PHASE 2
 rockwall, texas

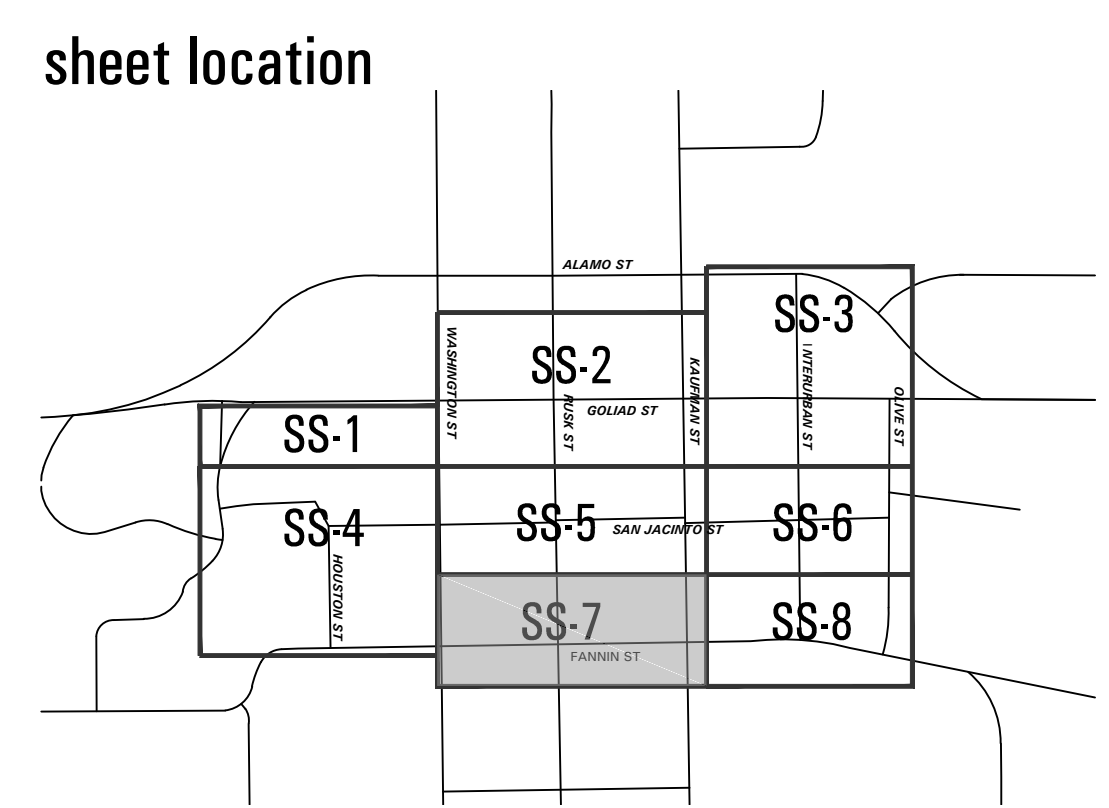

submittals / revisions

no.	date	detail
△	07/07/15	RFI #182

la terra studio, inc.

12024
 lts project number
 02.26.2014
 date
 rac; bhm
 drawn by
 mtb
 checked by



02.26.2014
 sheet title
Subsurface Drainage Plan
 sheet number
SS-7