

**PLANT AND MATERIALS LIST:** NOTE: CONTRACTOR TO VERIFY QUANTITIES PER PLANS

**CANOPY TREES**

	QNTY.	SYMBOL	COMMON NAME	BOTANIC NAME
		CP	CHINESE PISTACHE	PISTACHIA CHINENSIS
		RO	RED OAK	QUERCUS SHUMARDI

**SHRUBS**

	QNTY.	SYMBOL	COMMON NAME	BOTANIC NAME
		MF	MEXICAN FEATHER GRASS	STIPA TENIOSSIMA
		RDR	RED DRIFT ROSE	ROSA 'MEIGALPIO'


**TURF**

	QNTY.	SYMBOL	COMMON NAME	BOTANIC NAME
		SSSAG	SOLID SOD ST. AUGUSTINE GRASS	STENOTAPHRUM SECUNDATUM
		SSBG	SOLID SOD BERMUDA GRASS	Cynodon dactylon

**EXISTING TREE**

	QNTY.	SYMBOL	NOTE
		PER PLAN	REFERENCE CIVIL DEMO PLANS FOR TREE PRESERVATION.

**sheet location**

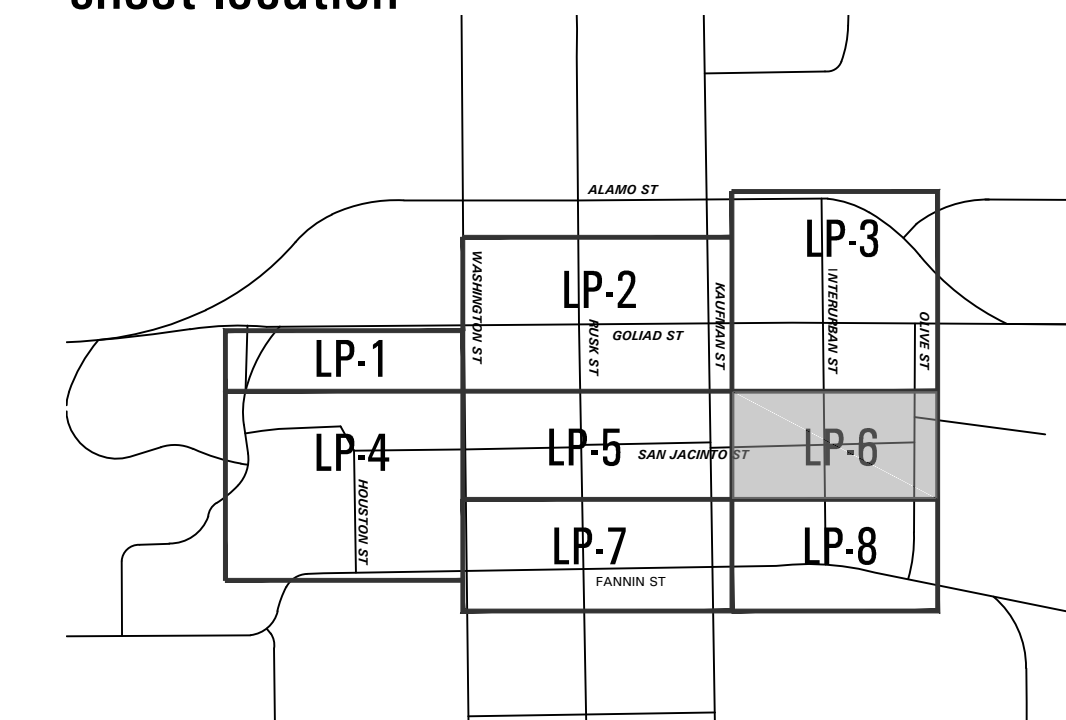

**Downtown Rockwall**  
 la terra studio Project #12024  
**streetscape improvements**  
 PHASE 2  
 rockwall, texas



submittals / revisions

no.	date	detail
△	03/11/15	RFI #162
△	05/01/15	RFI #176
△	07/02/15	RFI #183

la terra studio, inc.

12024  
 lts project number  
 02.26.2014  
 date  
 rac; bhm  
 drawn by  
 mtb  
 checked by

registration



02.26.2014  
 sheet title

**Landscape Plan**  
 sheet number

**LP-6**