


SITE PLAN LEGEND:

- EDGE OF PAVEMENT
- CONCRETE SIDEWALK PAVEMENT
- CONCRETE VEHICULAR PAVEMENT
- TYPICAL LIGHT FIXTURE

sheet location

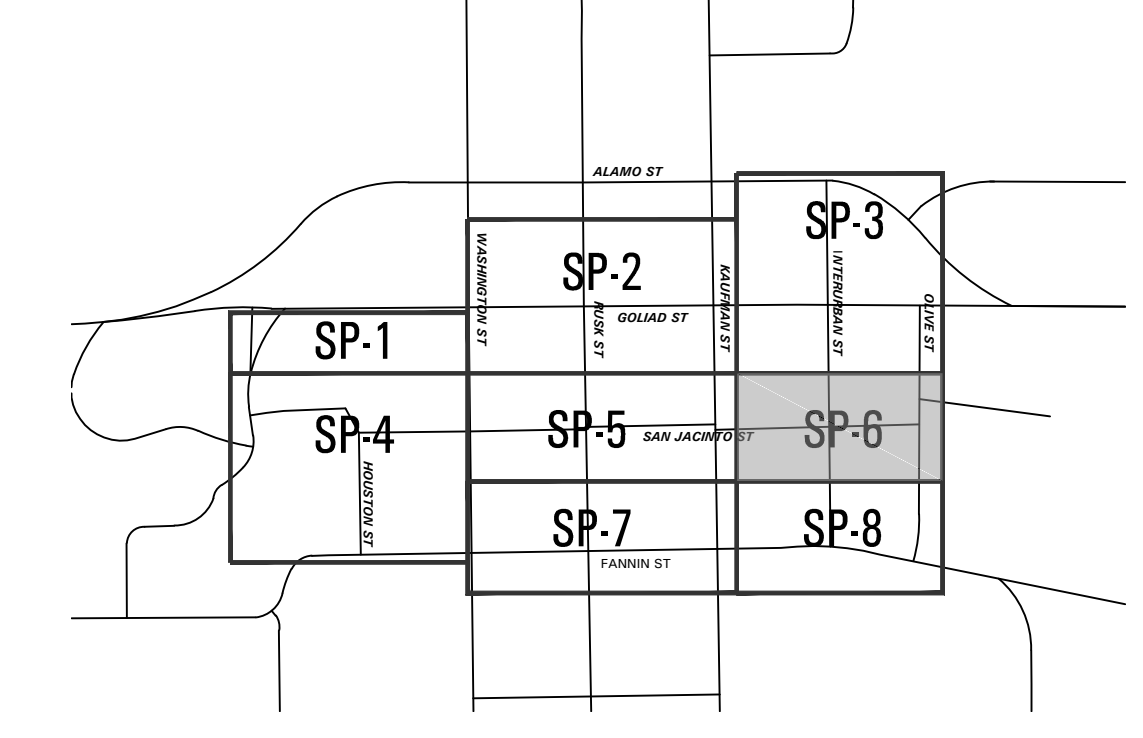

Downtown Rockwall
 la terra studio Project #12024
streetscape improvements
 PHASE 2
 rockwall, texas



submittals / revisions

no.	date	detail
△	12/02/14	LASI #13
△	12/08/14	RFI #151
△	12/22/14	RFI #150
△	02/10/15	RFI #159
△	03/11/15	RFI #162
△	05/01/15	RFI #175, #176
△	07/02/15	RFI #183

la terra studio, inc.

12024
 its project number
 02.26.2014
 date
 rac; bhm
 drawn by
 mtb
 checked by

registration



Site Plan
 sheet number
SP-6