


~ MATCH LINE-SHEET GP-7 ~

GRADING PLAN LEGEND:

- 580 ——— EXISTING GRADE CONTOUR
- 581 ——— FINISH GRADE CONTOUR
- 587.25 ——— FINISH SPOT GRADE
- 580.00 ——— SEE CIVIL FOR CROSS REFERENCE OF PROPOSED ELEVATION
- TS ——— TOP STEP
- BS ——— BOTTOM STEP
- TW ——— TOP OF WALL
- BW ——— BOTTOM OF WALL
- TC ——— TOP OF CURB
- G ——— GUTTER
- FF ——— FINISH FLOOR
- TCOL ——— TOP OF COLUMN

DATE	DESCRIPTION	BY
08/29/14	RFI #120	
09/03/14	RFI #122	
09/16/14	RFI #121, #125	
10/16/14	RFI #137	
11/26/14	LASI #12	
12/02/14	RFI #63	
12/09/14	RFI #152	
12/30/14	RFI #139	
01/13/15	LASI #14	
04/15/15	RFI #173	
08/25/15	RFI #187	

sheet location

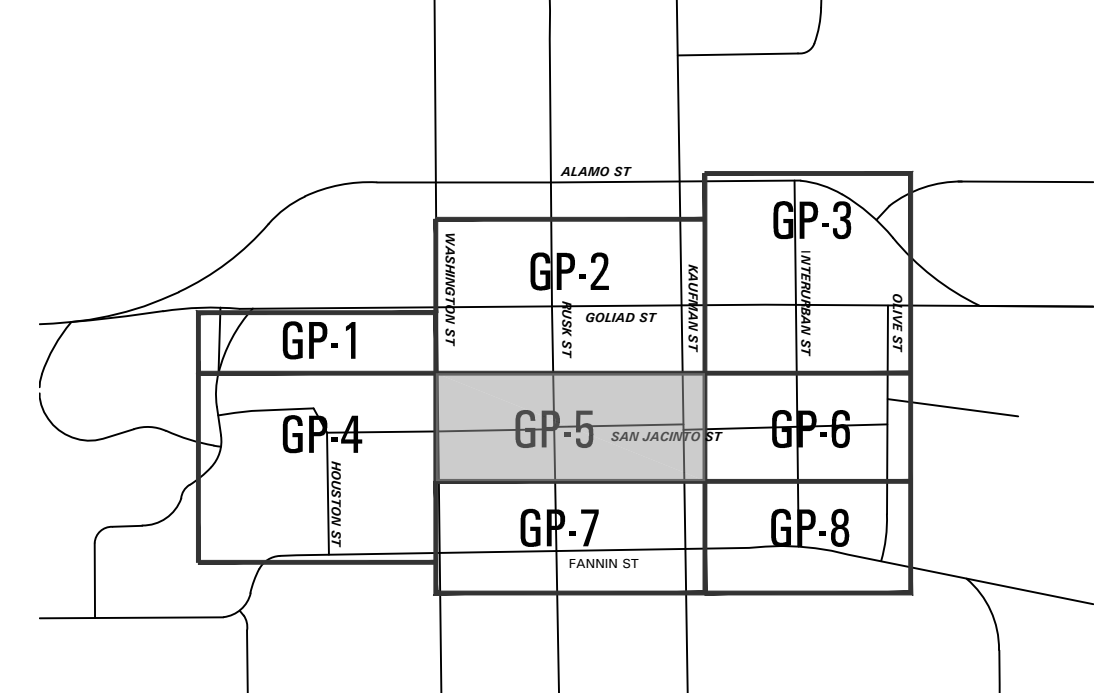

Downtown Rockwall
 la terra studio Project #12024
streetscape improvements
 PHASE 2
 rockwall, texas



submittals / revisions

no.	date	detail
△	04/02/14	RFI #29
△	05/02/14	RFI #77 WEST RUSK GRADING
△	05/08/14	RFI #20, #42, #43, #54
△	05/12/14	LASI #5
△	05/13/14	RFI #52
△	05/30/14	RFI #40
△	07/25/14	RFI #104
△	08/14/14	LASI #9
△	07/31/14	LASI #10

la terra studio, inc.

12024
 its project number
 02.26.2014
 date
 rac; bhm
 drawn by
 mth
 checked by



Grading Plan
 sheet number
GP-5