


SITE PLAN LEGEND:

- EDGE OF PAVEMENT
- CONCRETE SIDEWALK PAVEMENT
- CONCRETE VEHICULAR PAVEMENT
- TYPICAL LIGHT FIXTURE

sheet location

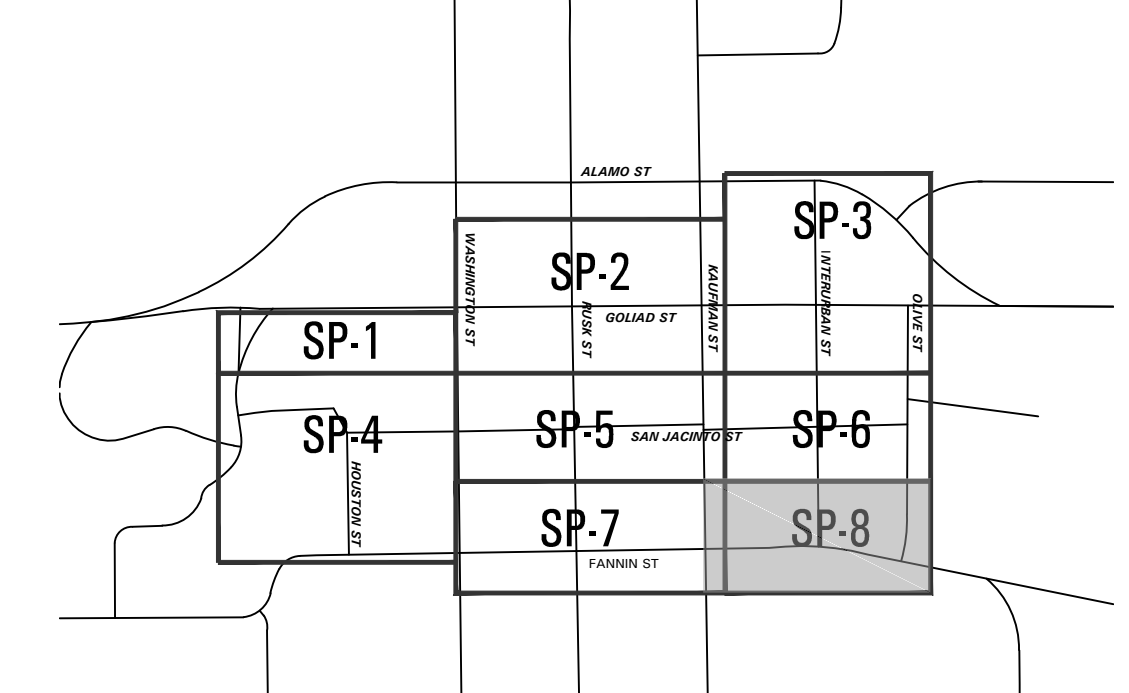

Downtown Rockwall
 la terra studio Project #12024
streetscape improvements
 PHASE 2
 rockwall, texas

submittals / revisions

no.	date	detail
△	07/10/15	LASI #21
△	09/03/15	LASI #188

la terra studio, inc.
 12024
 lts project number
 02.26.2014
 date
 rac; bhm
 drawn by
 mtb
 checked by



Site Plan
 sheet number
SP-8