



© 2013 la terra studio, inc. All Rights Reserved FILE:R:\12024-Downtown Rockwall PS&E - Rockwall\CAD\12024_Enlargement_Plan_key.dwg

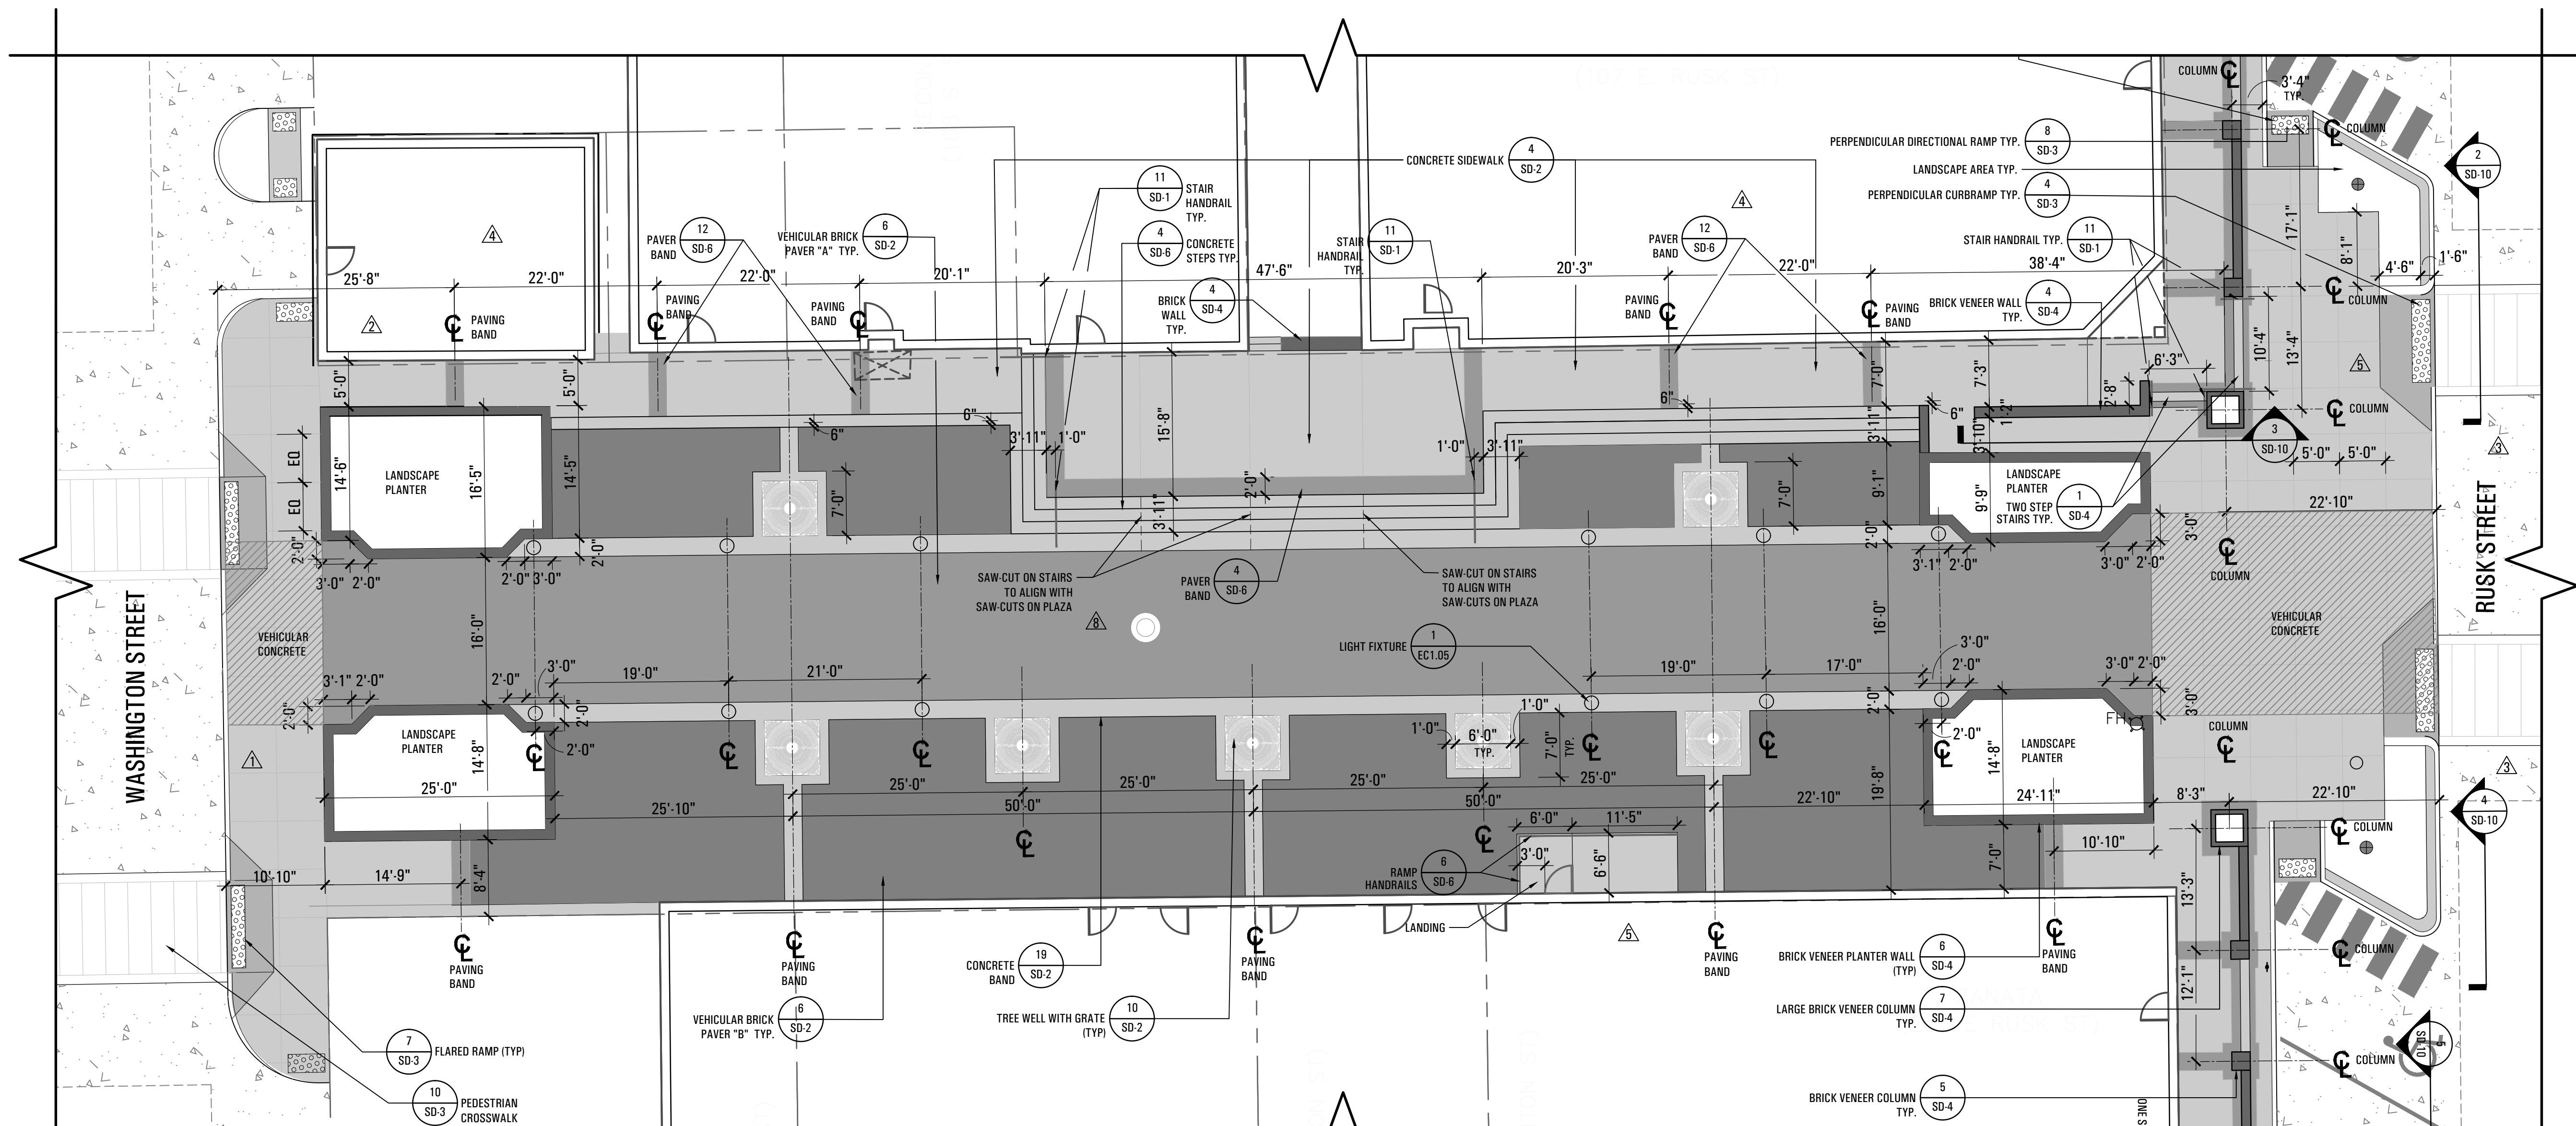

1 ENLARGEMENT PLAN
SCALE: 1" = 10'-0"

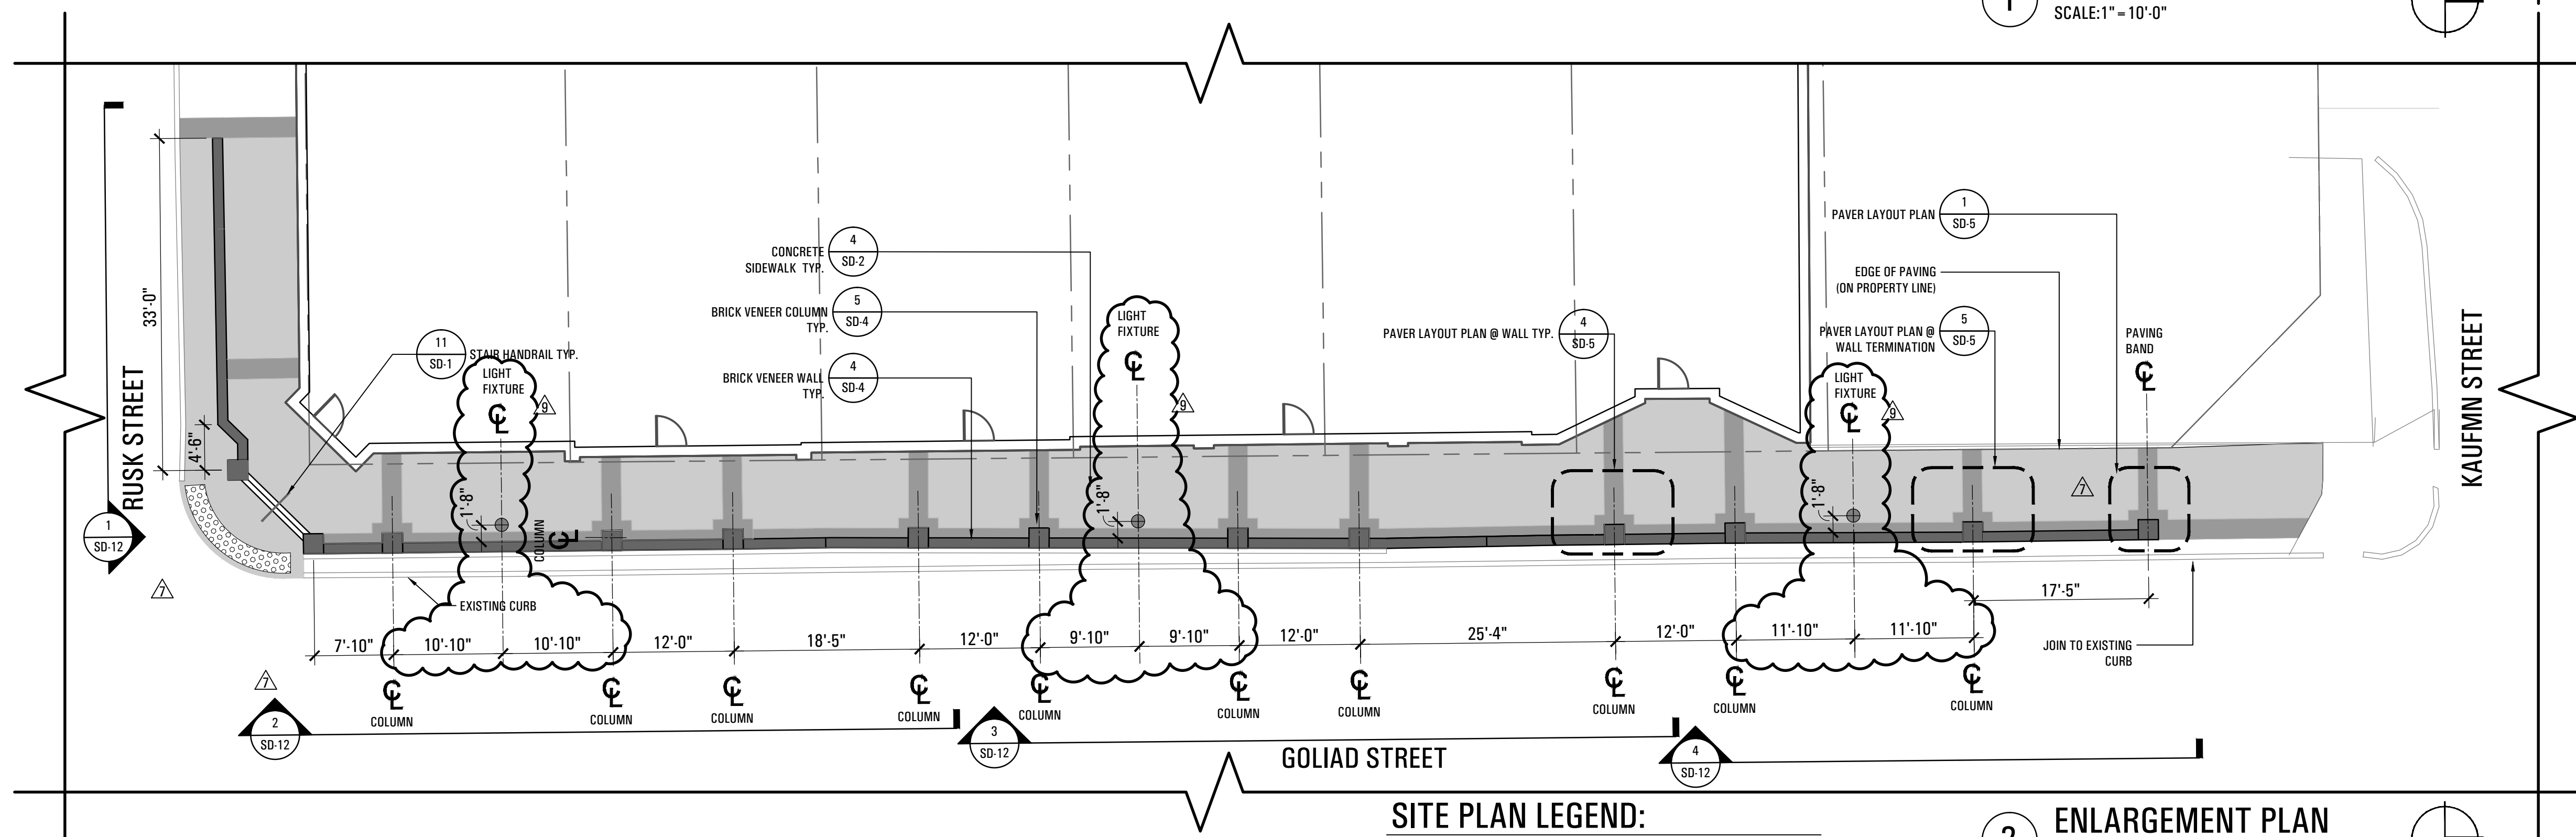

SITE PLAN LEGEND:

- EDGE OF PAVEMENT
- CONCRETE SIDEWALK PAVEMENT
- CONCRETE VEHICULAR PAVEMENT
- TYPICAL LIGHT FIXTURE

2 ENLARGEMENT PLAN
SCALE: 1" = 10'-0"

Downtown Rockwall
 la terra studio Project #12024
streetscape improvements
 PHASE 2
 rockwall, texas

submittals / revisions

no.	date	detail
△	05/13/14	RFI #71
△	08/14/14	LASI #9
△	07/31/14	LASI #10
△	09/26/14	RFI #131
△	10/16/14	RFI #137
△	12/30/14	RFI #139
△	06/04/15	LASI #18
△	06/08/15	LASI #19
△	09/28/15	RFI #196

la terra studio, inc.

12024
 its project number
 02.26.2014
 date
 rac; bhm
 drawn by
 mtb
 checked by

