


**SITE PLAN LEGEND:**

- PROJECT LIMIT LINE
- EDGE OF PAVEMENT
- CONCRETE SIDEWALK PAVEMENT
- CONCRETE VEHICULAR PAVEMENT
- TYPICAL LIGHT FIXTURE

**sheet location**

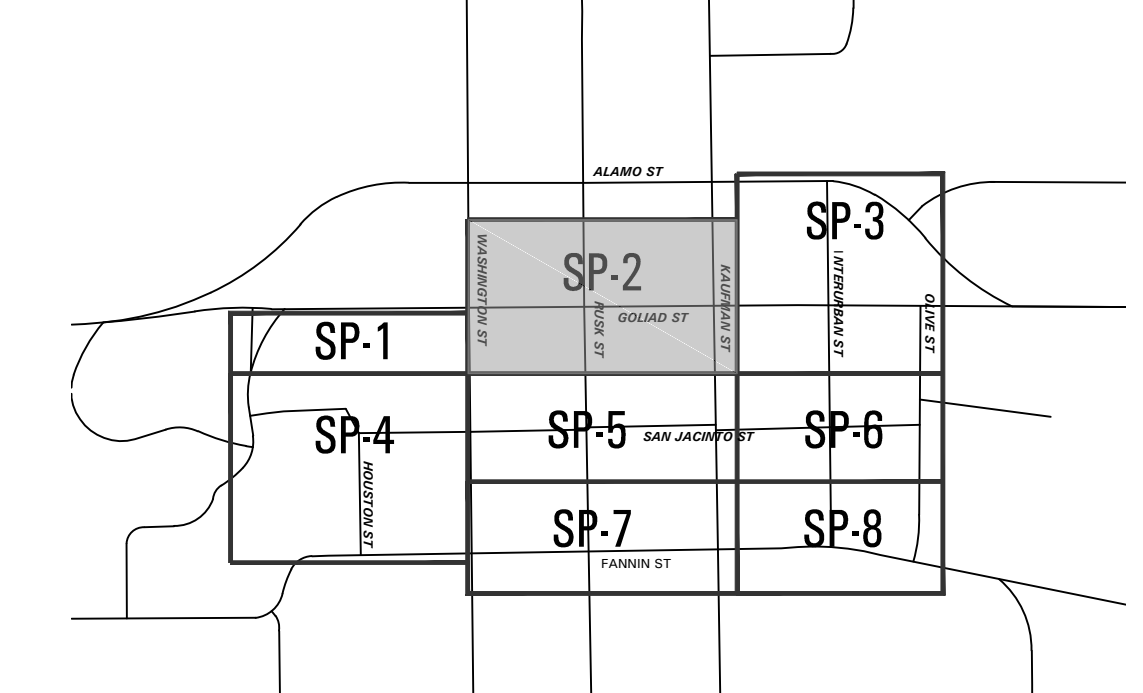


**Downtown Rockwall**  
 la terra studio Project #12024  
**streetscape improvements**  
 PHASE 2  
 rockwall, texas

submittals / revisions

no.	date	detail
1	04/10/14	RFI #23
2	09/10/14	RFI #124
3	09/10/15	RFI #38
4	09/28/15	RFI #196

la terra studio, inc.  
 12024  
 its project number  
 02.26.2014  
 date  
 rac; bhm  
 drawn by  
 mtb  
 checked by

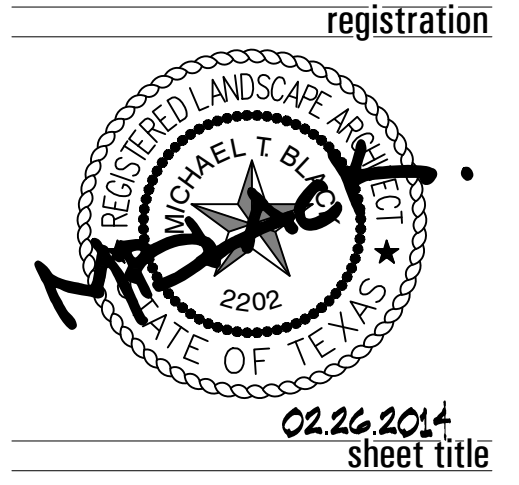

02.26.2014  
 sheet title  
**Site Plan**  
 sheet number  
**SP-2**