

~ MATCH LINE-SHEET GP-1 ~


~ MATCH LINE-SHEET GP-5 ~

~ MATCH LINE-SHEET GP-3 ~

**GRADING PLAN LEGEND:**

- 580 — EXISTING GRADE CONTOUR
- 581 — FINISH GRADE CONTOUR
- 587.25 — FINISH SPOT GRADE
- 580.00 — SEE CIVIL FOR CROSS REFERENCE OF PROPOSED ELEVATION
- TS TOP STEP
- BS BOTTOM STEP
- TW TOP OF WALL
- BW BOTTOM OF WALL
- TC TOP OF CURB
- G GUTTER
- FF FINISH FLOOR
- TCOL TOP OF COLUMN

**sheet location**

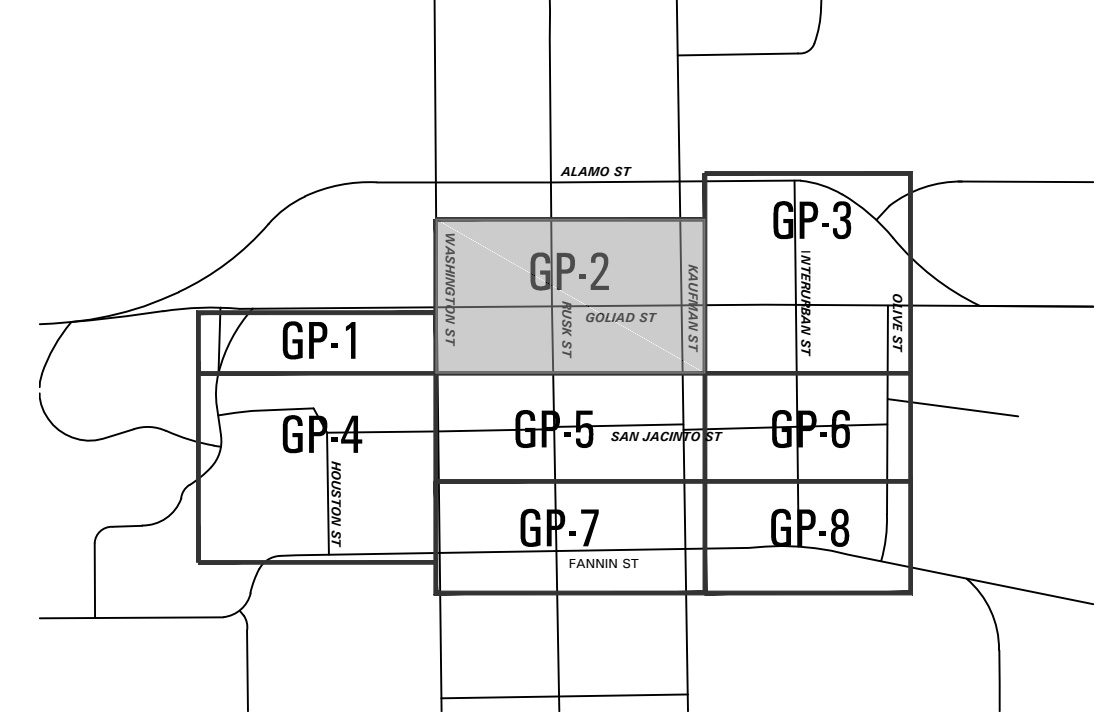

06/04/15	LASI #18
09/10/15	RFI #38
10/09/15	RFI #200, #202

**Downtown Rockwall**  
 la terra studio Project #12024  
**streetscape improvements**  
 PHASE 2  
 rockwall, texas

submittals / revisions

no.	date	detail
▲	04/11/14	RFI #39,56
▲	05/02/14	RFI #77 WEST RUSK GRADING
▲	06/17/14	RFI #93
▲	07/11/14	LASI #7
▲	07/25/14	RFI #104
▲	09/10/14	RFI #124
▲	10/27/14	RFI #140
▲	01/13/15	LASI #14
▲	02/09/15	RFI #160

la terra studio, inc.

12024  
 Its project number  
 02.26.2014  
 date  
 rac; bhm  
 drawn by  
 mtb  
 checked by

