


**SITE PLAN LEGEND:**

- EDGE OF PAVEMENT
- CONCRETE SIDEWALK PAVEMENT
- CONCRETE VEHICULAR PAVEMENT
- TYPICAL LIGHT FIXTURE

**1 ENLARGEMENT PLAN**  
SCALE: 1" = 10'-0"

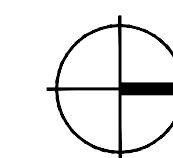

**Downtown Rockwall**  
*la terra studio Project #12024*  
**streetscape improvements**  
PHASE 2  
rockwall, texas



submittals / revisions

no.	date	detail
△	05/13/14	RFI #51
△	09/18/14	RFI #121, #125
△	11/26/14	LASI #12
△	02/27/15	RFI #164
△	06/09/15	LASI #19
△	09/28/15	RFI #194
△	10/05/15	RFI #204
△	10/13/15	RFI #206

la terra studio, inc.

12024  
Its project number  
02.26.2014  
date  
rac; bhm  
drawn by  
mtb  
checked by



Enlargement Plan  
sheet number

**EP-2**