

**Downtown Rockwall**  
 la terra studio Project #12024  
**streetscape improvements**  
 PHASE 2  
 rockwall, texas




submittals / revisions

no.	date	detail
△	07/14/14	RFI #101
△	07/29/14	RFI #112
△	08/29/14	RFI #120
△	09/16/14	RFI #121, #125
△	02/27/15	RFI #164
△	04/06/15	RFI #171
△	09/17/15	LASI #22
△	10/13/15	RFI #206

la terra studio, inc.

12024  
 Its project number  
 02.26.2014  
 date  
 rac; bhm  
 drawn by  
 mtb  
 checked by

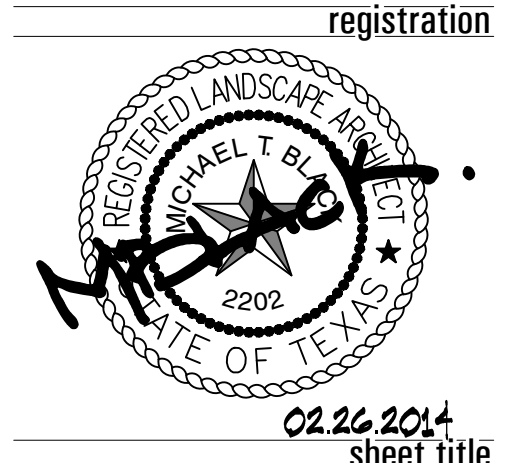

**Landscape Plan**  
 sheet number  
**LP-5**

**PLANT AND MATERIALS LIST:** NOTE: CONTRACTOR TO VERIFY QUANTITIES PER PLANS

**CANOPY TREES**

QNTY.	SYMBOL	COMMON NAME	BOTANIC NAME
	CP	CHINESE PISTACHE	PISTACHIA CHINENSIS
	LO	LIVE OAK	QUERCUS VIRGINANA
	LBE	LACE BARK ELM	ULMUS PARVIFOLIA
	RO	RED OAK	QUERCUS SHUMARDI
	CM	CADDO MAPLE	ACER SACCHARUM 'CADDO'

**SHRUBS**

QNTY.	SYMBOL	COMMON NAME	BOTANIC NAME
	CFF	CHINESE FRINGE FLOWER 'PURPLE DIAMOND'	LOROPETALUM CHINENSIS 'PURPLE DIAMOND'
	CH	CARISSA HOLLY	ILEX CORNUTA 'CARISSA'
	CR	CARPET ROSEMARY	ROSMARINUS OFFICINALIS 'HUNTINGTON CARPET'
	GL	GIANT LIRIOPE	LIRIOPE GIGANTEA
	IH	INDIAN HAWTHORN	RHAPHIOLEPIS INDICA 'CLARA'
	MF	MEXICAN FEATHER GRASS	STIPA TENIOSSIMA

**TURF**

QNTY.	SYMBOL	COMMON NAME	BOTANIC NAME
	SSBG	SOLID SOD BERMUDA GRASS	Cynodon dactylon

**EXISTING TREE**

QNTY.	SYMBOL	NOTE
	PER PLAN	REFERENCE CIVIL DEMO PLANS FOR TREE PRESERVATION.



**sheet location**

