



© 2013 la terra studio, inc. All Rights Reserved FILE:R:\12024-Downtown Rockwall PS&E - Rockwall\CAD\12024_Enlargement_Plan_key.dwg

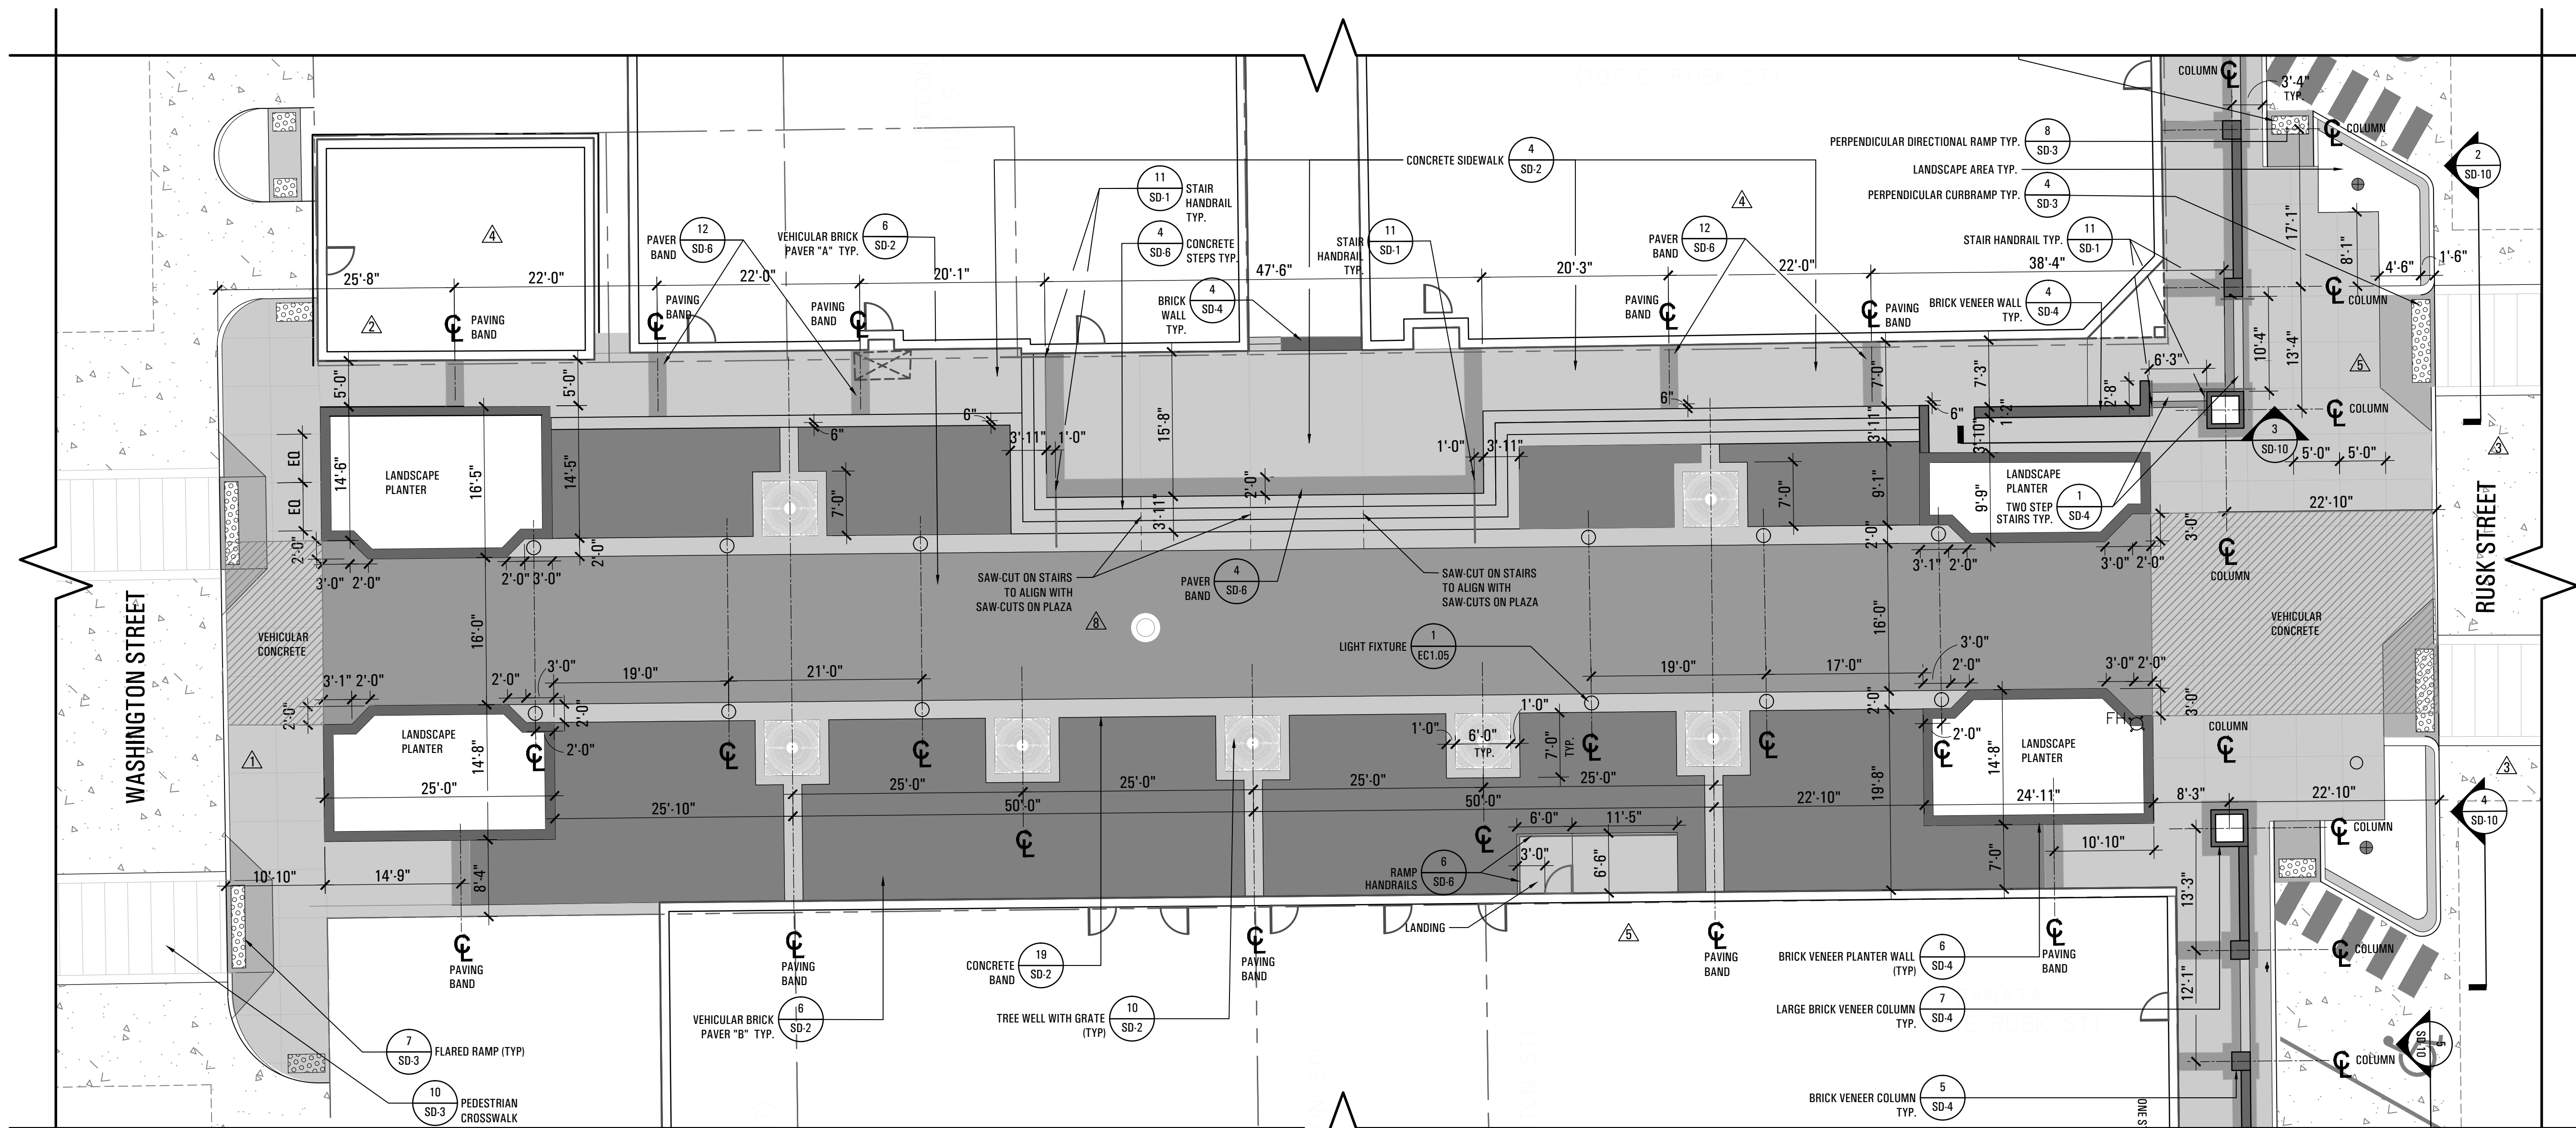

1 ENLARGEMENT PLAN
SCALE: 1" = 10'-0"

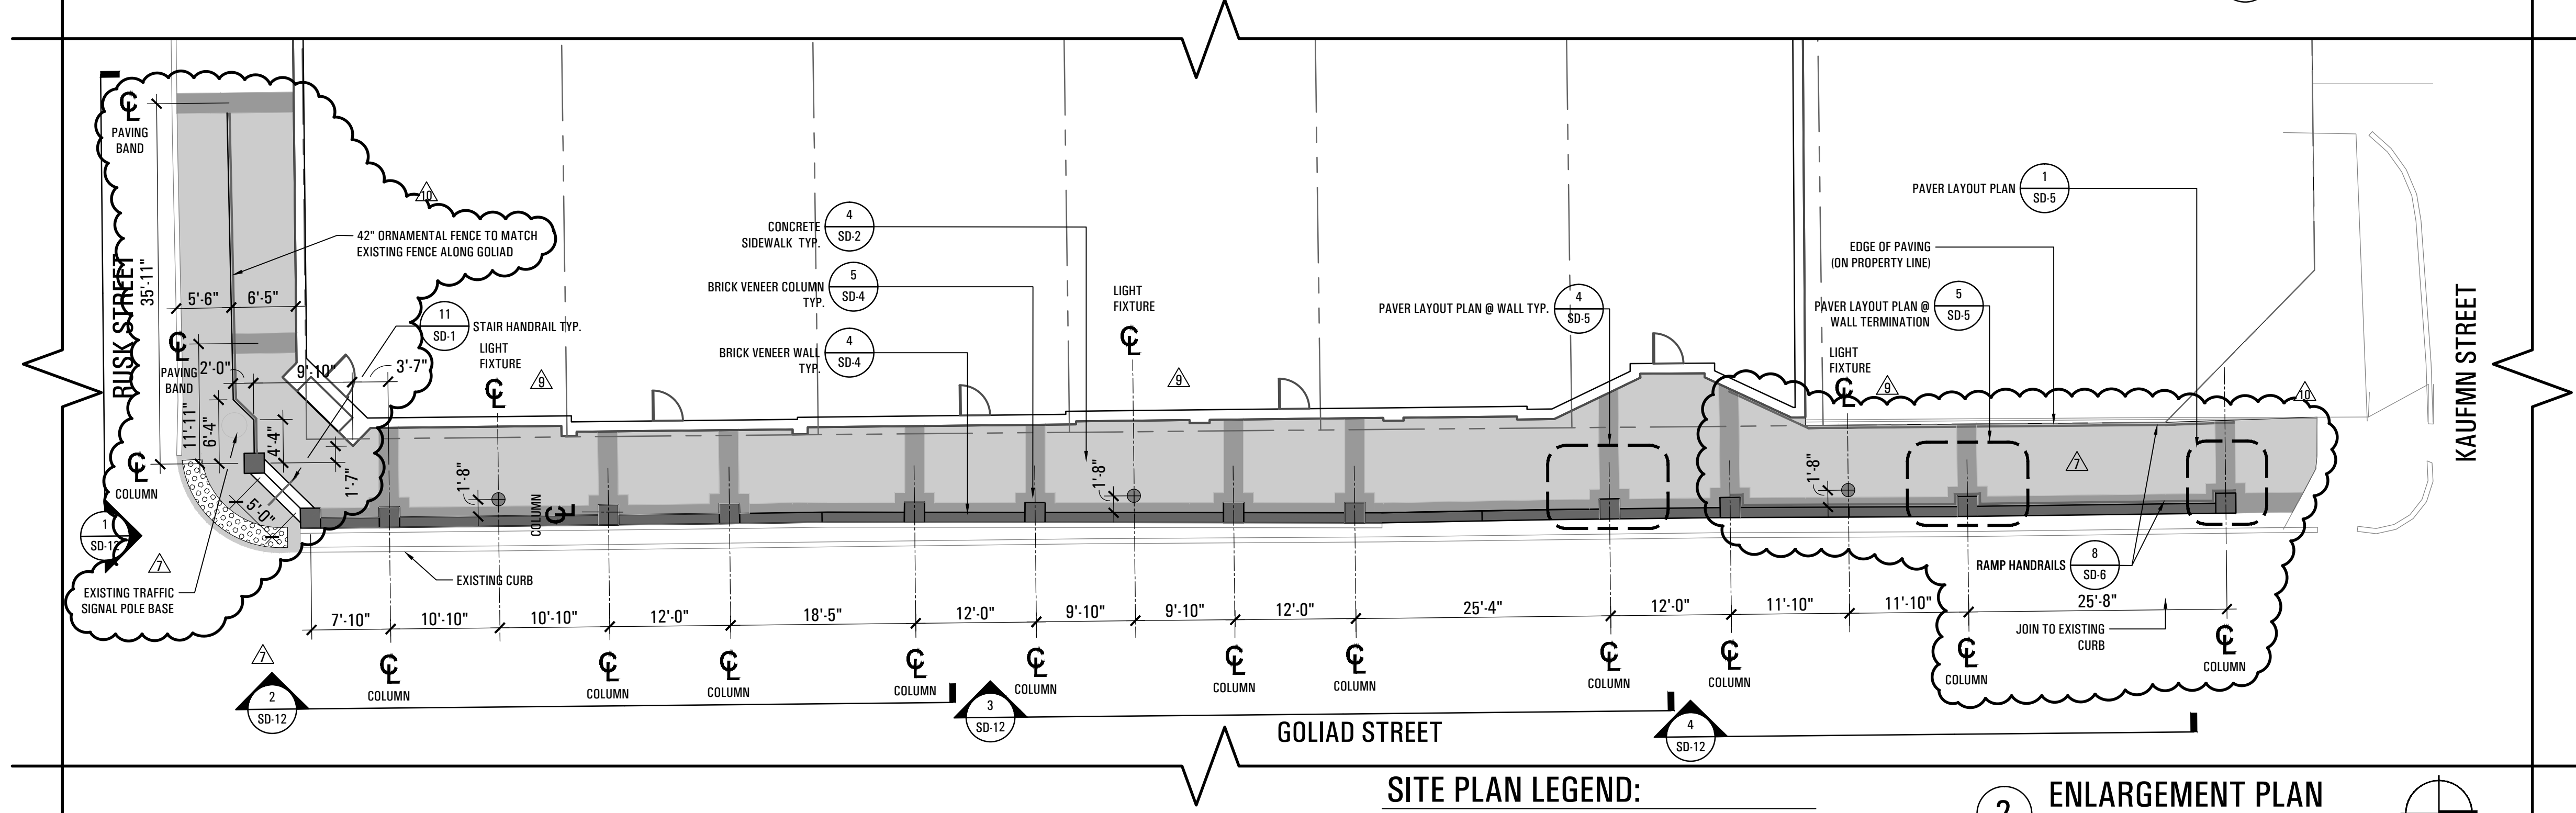

2 ENLARGEMENT PLAN
SCALE: 1" = 10'-0"

SITE PLAN LEGEND:

- EDGE OF PAVEMENT
- ▬ CONCRETE SIDEWALK PAVEMENT
- ▬ CONCRETE VEHICULAR PAVEMENT
- TYPICAL LIGHT FIXTURE

Downtown Rockwall
 la terra studio Project #12024
streetscape improvements
 PHASE 2
 rockwall, texas



submittals / revisions

| no. | date | detail |
|-----|----------|----------|
| △ | 05/13/14 | RFI #71 |
| △ | 08/14/14 | LASI #9 |
| △ | 07/31/14 | LASI #10 |
| △ | 09/26/14 | RFI #131 |
| △ | 10/16/14 | RFI #137 |
| △ | 12/30/14 | RFI #139 |
| △ | 06/04/15 | LASI #18 |
| △ | 06/08/15 | LASI #19 |
| △ | 09/28/15 | RFI #196 |

la terra studio, inc.

12024
 its project number
 02.26.2014
 date
 rac; bhm
 drawn by
 mtb
 checked by

