


GRADING PLAN LEGEND:

580	EXISTING GRADE CONTOUR
581	FINISH GRADE CONTOUR
587.25	FINISH SPOT GRADE
580.00	SEE CIVIL FOR CROSS REFERENCE OF PROPOSED ELEVATION
TS	TOP STEP
BS	BOTTOM STEP
TW	TOP OF WALL
BW	BOTTOM OF WALL
TC	TOP OF CURB
G	GUTTER
FF	FINISH FLOOR
TCOL	TOP OF COLUMN

08/29/14	RFI #120
09/03/14	RFI #122
09/16/14	RFI #121, #125
10/16/14	RFI #137
11/26/14	LASI #5
12/02/14	RFI #63
12/09/14	RFI #152
12/30/14	RFI #139
01/13/15	LASI #14
04/15/15	RFI #173
08/25/15	RFI #187
10/13/15	RFI #206
10/29/15	RFI #208, #209

sheet location

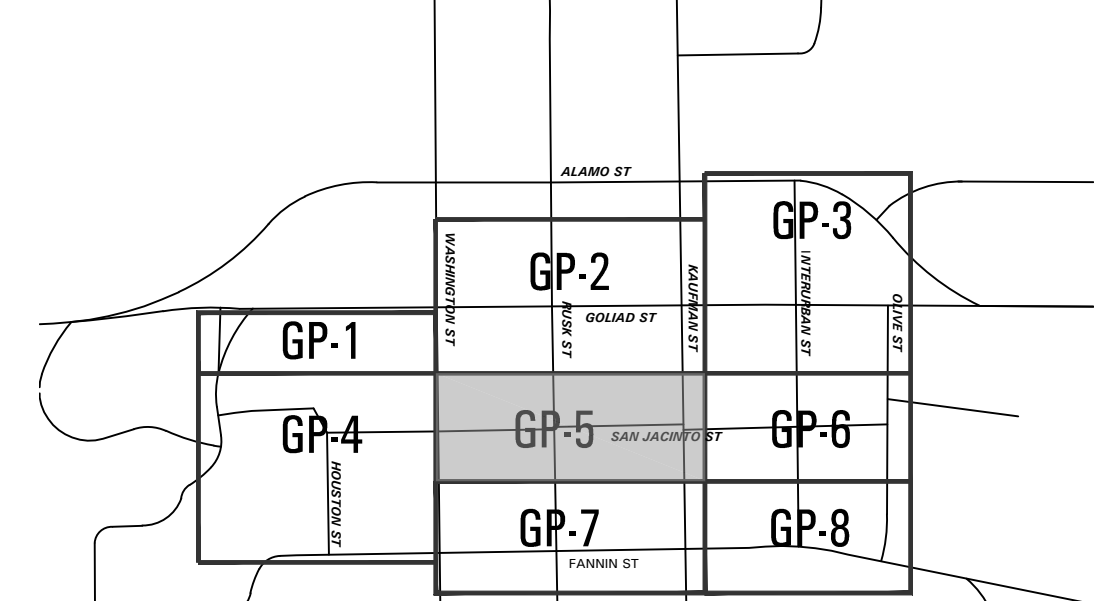

Downtown Rockwall
 la terra studio Project #12024
streetscape improvements
 PHASE 2
 rockwall, texas



submittals / revisions

no.	date	detail
△	04/02/14	RFI #29
△	05/02/14	RFI #77 WEST RUSK GRADING
△	05/08/14	RFI #20, #42, #43, #54
△	05/12/14	LASI #5
△	05/13/14	RFI #52
△	05/30/14	RFI #40
△	07/25/14	RFI #104
△	08/14/14	LASI #9
△	07/31/14	LASI #10

la terra studio, inc.

12024
 its project number
 02.26.2014
 date
 rac; bhm
 drawn by
 mth
 checked by



Grading Plan
 sheet number
GP-5