


GRADING PLAN LEGEND:

- PHASE 1 PROJECT LIMIT LINE
- EXISTING GRADE CONTOUR
- FINISH GRADE CONTOUR
- FINISH SPOT GRADE
- SEE CIVIL FOR CROSS REFERENCE OF PROPOSED ELEVATION
- TOP STEP
- BOTTOM STEP
- TOP OF WALL
- BOTTOM OF WALL
- TOP OF CURB
- GUTTER
- FINISH FLOOR
- TOP OF COLUMN

	04/27/15	RFI #177
	07/08/15	LASI #20
	10/29/15	RFI #208, #209, #210

sheet location

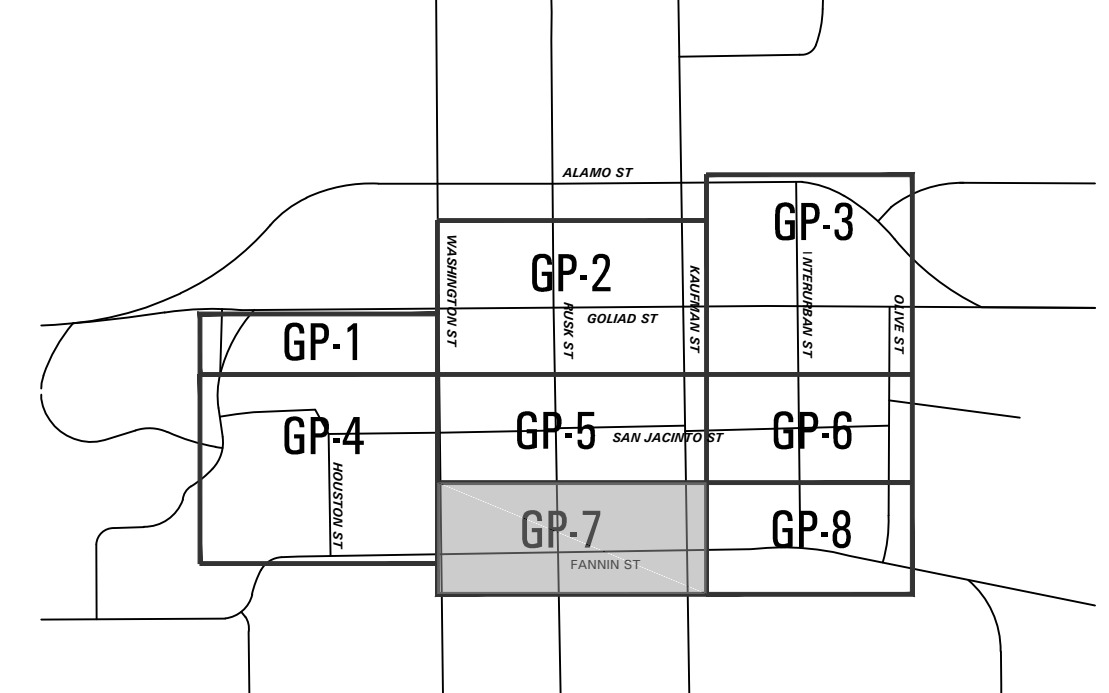

Downtown Rockwall
 streetscape improvements
 PHASE 2
 rockwall, texas



submittals / revisions

no.	date	detail
	05/08/14	RFI #20, #42, #43, #54
	05/16/14	RFI #37
	07/15/14	RFI #108
	09/30/14	RFI #123
	11/26/14	LASI #12
	12/16/14	RFI #145
	01/13/15	RFI #153
	04/15/15	RFI #146
	04/22/15	LASI #16

la terra studio, inc.

12024
 its project number
 02.26.2014
 date
 rac; bhm
 drawn by
 mtb
 checked by



Grading Plan
 sheet number
GP-7