


© 2013 la terra studio, inc. All Rights Reserved FILE:R:\12024-Downtown Rockwall PSS&E - Rockwall\CAD\Sheet\12024_LP1-7.dwg

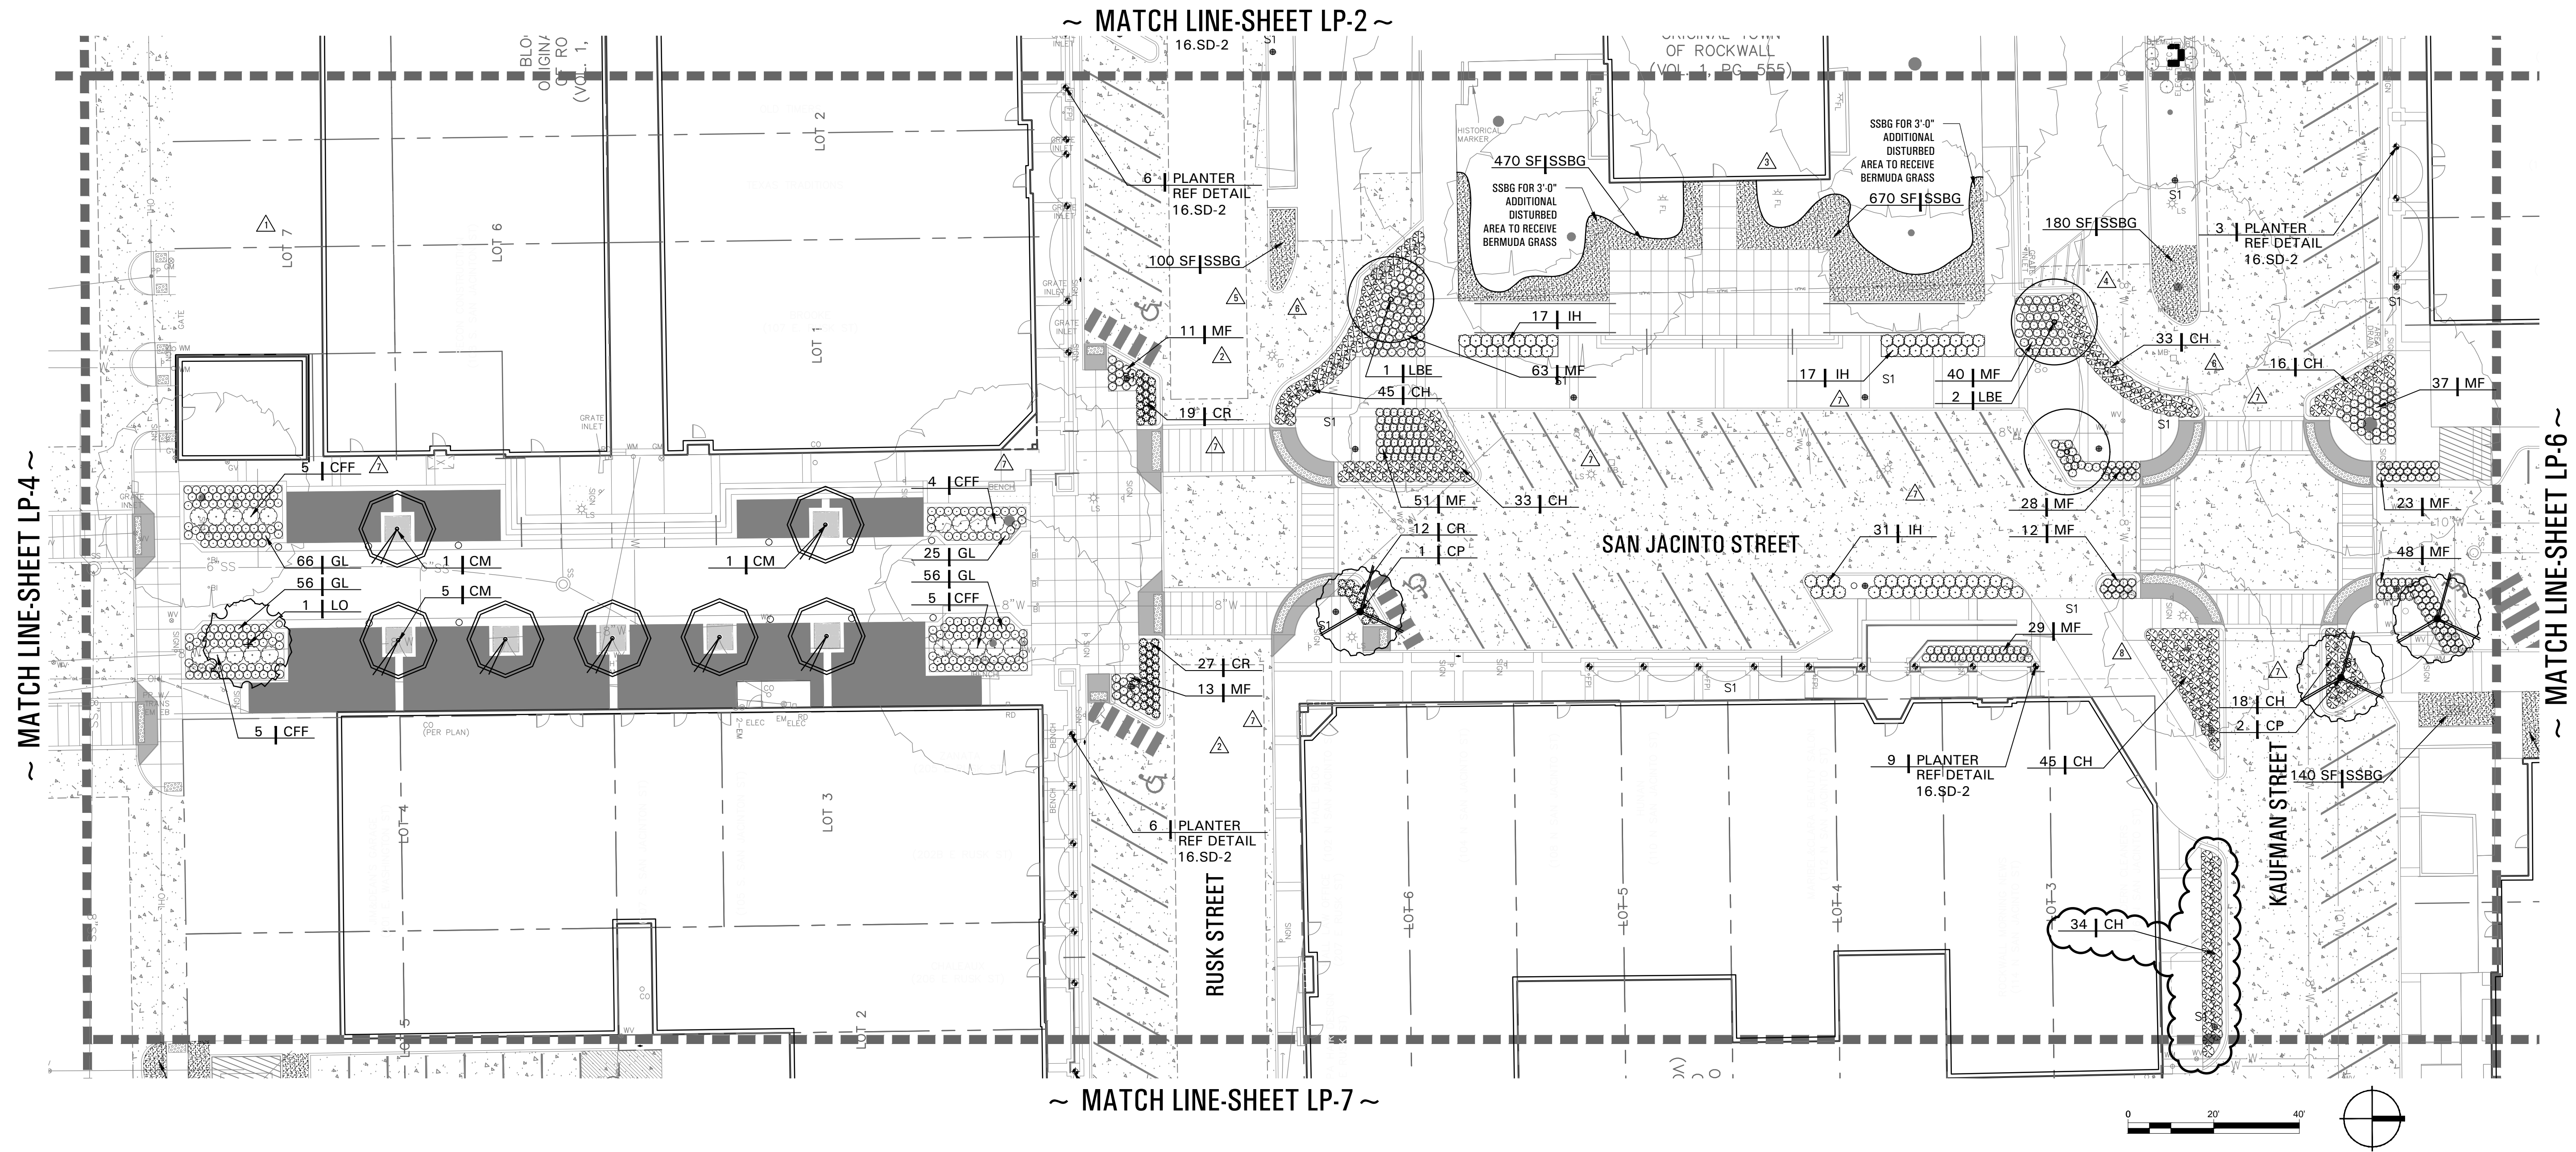

PLANT AND MATERIALS LIST: NOTE: CONTRACTOR TO VERIFY QUANTITIES PER PLANS

CANOPY TREES

| QNTY. | SYMBOL | COMMON NAME | BOTANIC NAME |
|-------|--------|------------------|------------------------|
| | CP | CHINESE PISTACHE | PISTACHIA CHINENSIS |
| | LO | LIVE OAK | QUERCUS VIRGINANA |
| | LBE | LACE BARK ELM | ULMUS PARVIFOLIA |
| | RO | RED OAK | QUERCUS SHUMARDI |
| | CM | CADDO MAPLE | ACER SACCHARUM 'CADDO' |

SHRUBS

| QNTY. | SYMBOL | COMMON NAME | BOTANIC NAME |
|-------|--------|--|--|
| | CFF | CHINESE FRINGE FLOWER 'PURPLE DIAMOND' | LOROPETALUM CHINENSIS 'PURPLE DIAMOND' |
| | CH | CARISSA HOLLY | ILEX CORNUTA 'CARISSA' |
| | CR | CARPET ROSEMARY | ROSMARINUS OFFICINALIS 'HUNTINGTON CARPET' |
| | GL | GIANT LIRIOPE | LIRIOPE GIGANTEA |
| | IH | INDIAN HAWTHORN | RHAPHIOLEPIS INDICA 'CLARA' |
| | MF | MEXICAN FEATHER GRASS | STIPA TENIOSSIMA |

TURF


| QNTY. | SYMBOL | COMMON NAME | BOTANIC NAME |
|-------|--------|-------------------------|------------------|
| | SSBG | SOLID SOD BERMUDA GRASS | Cynodon dactylon |

EXISTING TREE

| QNTY. | SYMBOL | NOTE |
|-------|----------|---|
| | PER PLAN | REFERENCE CIVIL DEMO PLANS FOR TREE PRESERVATION. |



sheet location

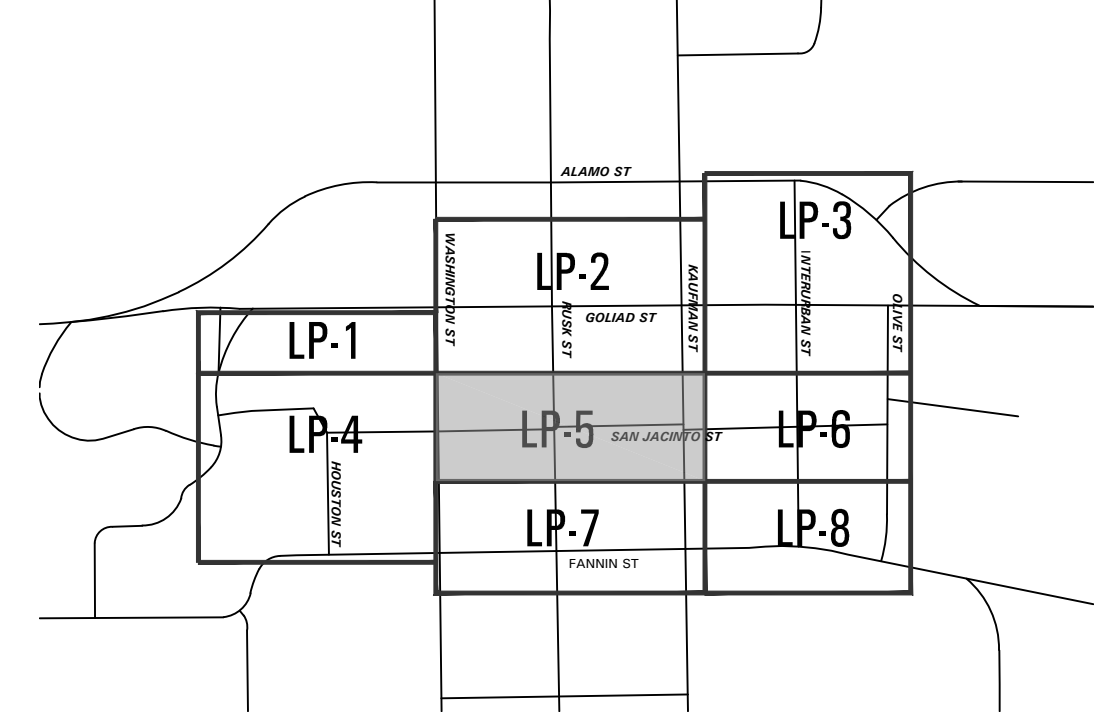

Downtown Rockwall
 la terra studio Project #12024
streetscape improvements
 PHASE 2
 rockwall, texas



submittals / revisions

| no. | date | detail |
|-----|----------|----------------|
| △ | 07/14/14 | RFI #101 |
| △ | 07/29/14 | RFI #112 |
| △ | 08/29/14 | RFI #120 |
| △ | 09/16/14 | RFI #121, #125 |
| △ | 02/27/15 | RFI #164 |
| △ | 04/06/15 | RFI #171 |
| △ | 09/17/15 | LASI #22 |
| △ | 10/13/15 | RFI #206 |
| △ | 10/29/15 | RFI #209 |

la terra studio, inc.

12024
 Its project number
 02.26.2014
 date
 rac; bhm
 drawn by
 mtb
 checked by



Landscape Plan
 sheet number
LP-5