



© 2013 la terra studio, inc. All Rights Reserved FILE:R:\12024-Downtown Rockwall PS&E - Rockwall\CAD\12024\_Enlargement\_Plan\_key.dwg

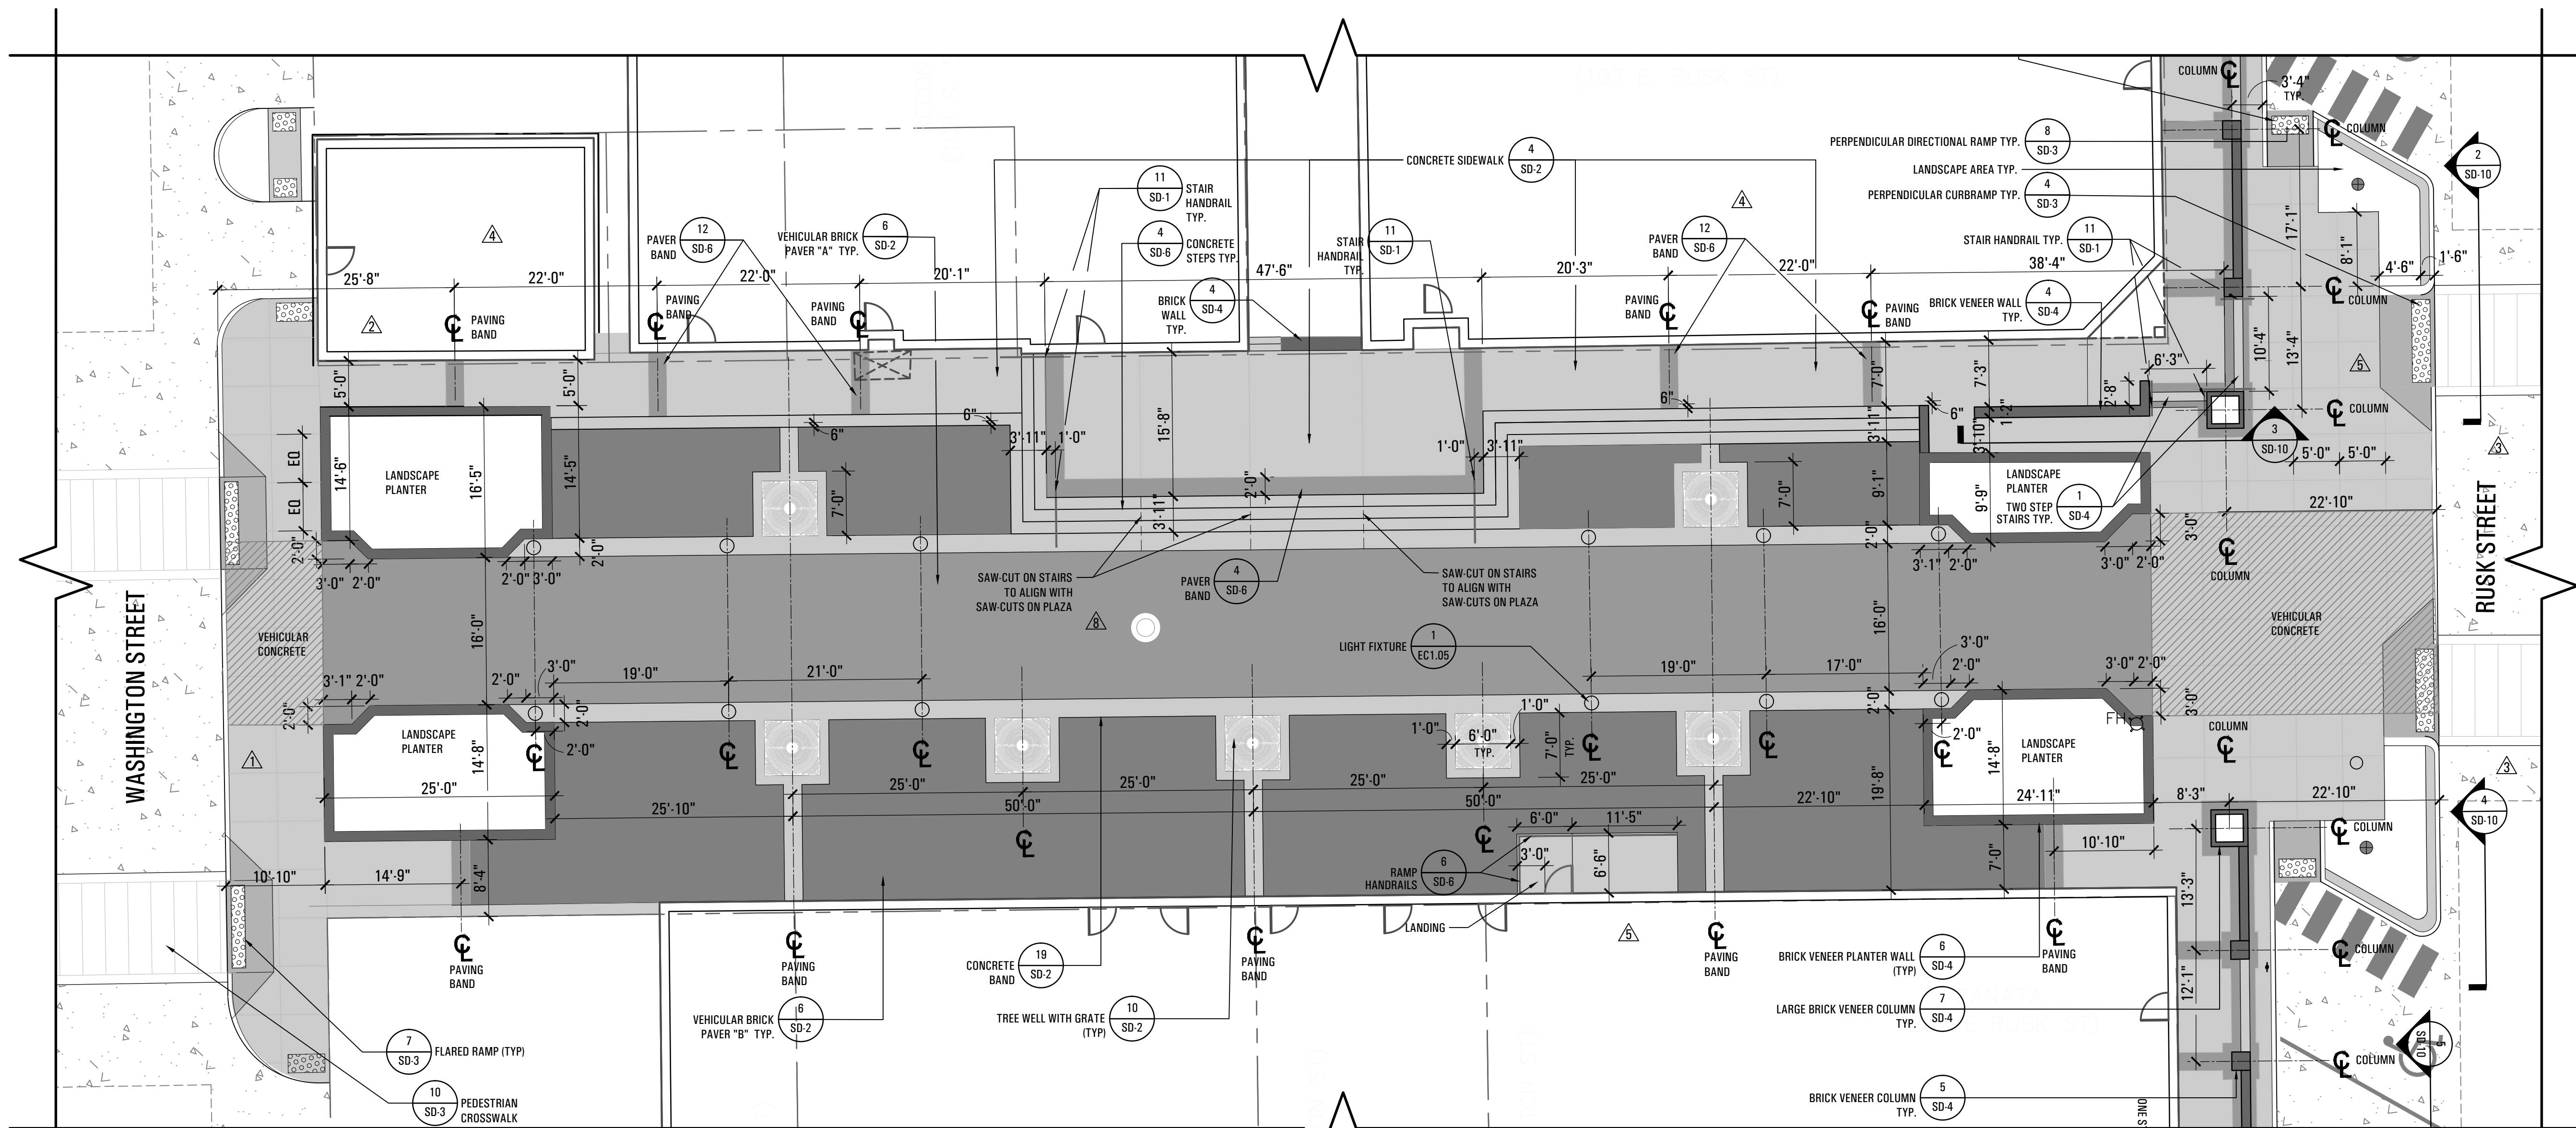

**1 ENLARGEMENT PLAN**  
SCALE: 1" = 10'-0"

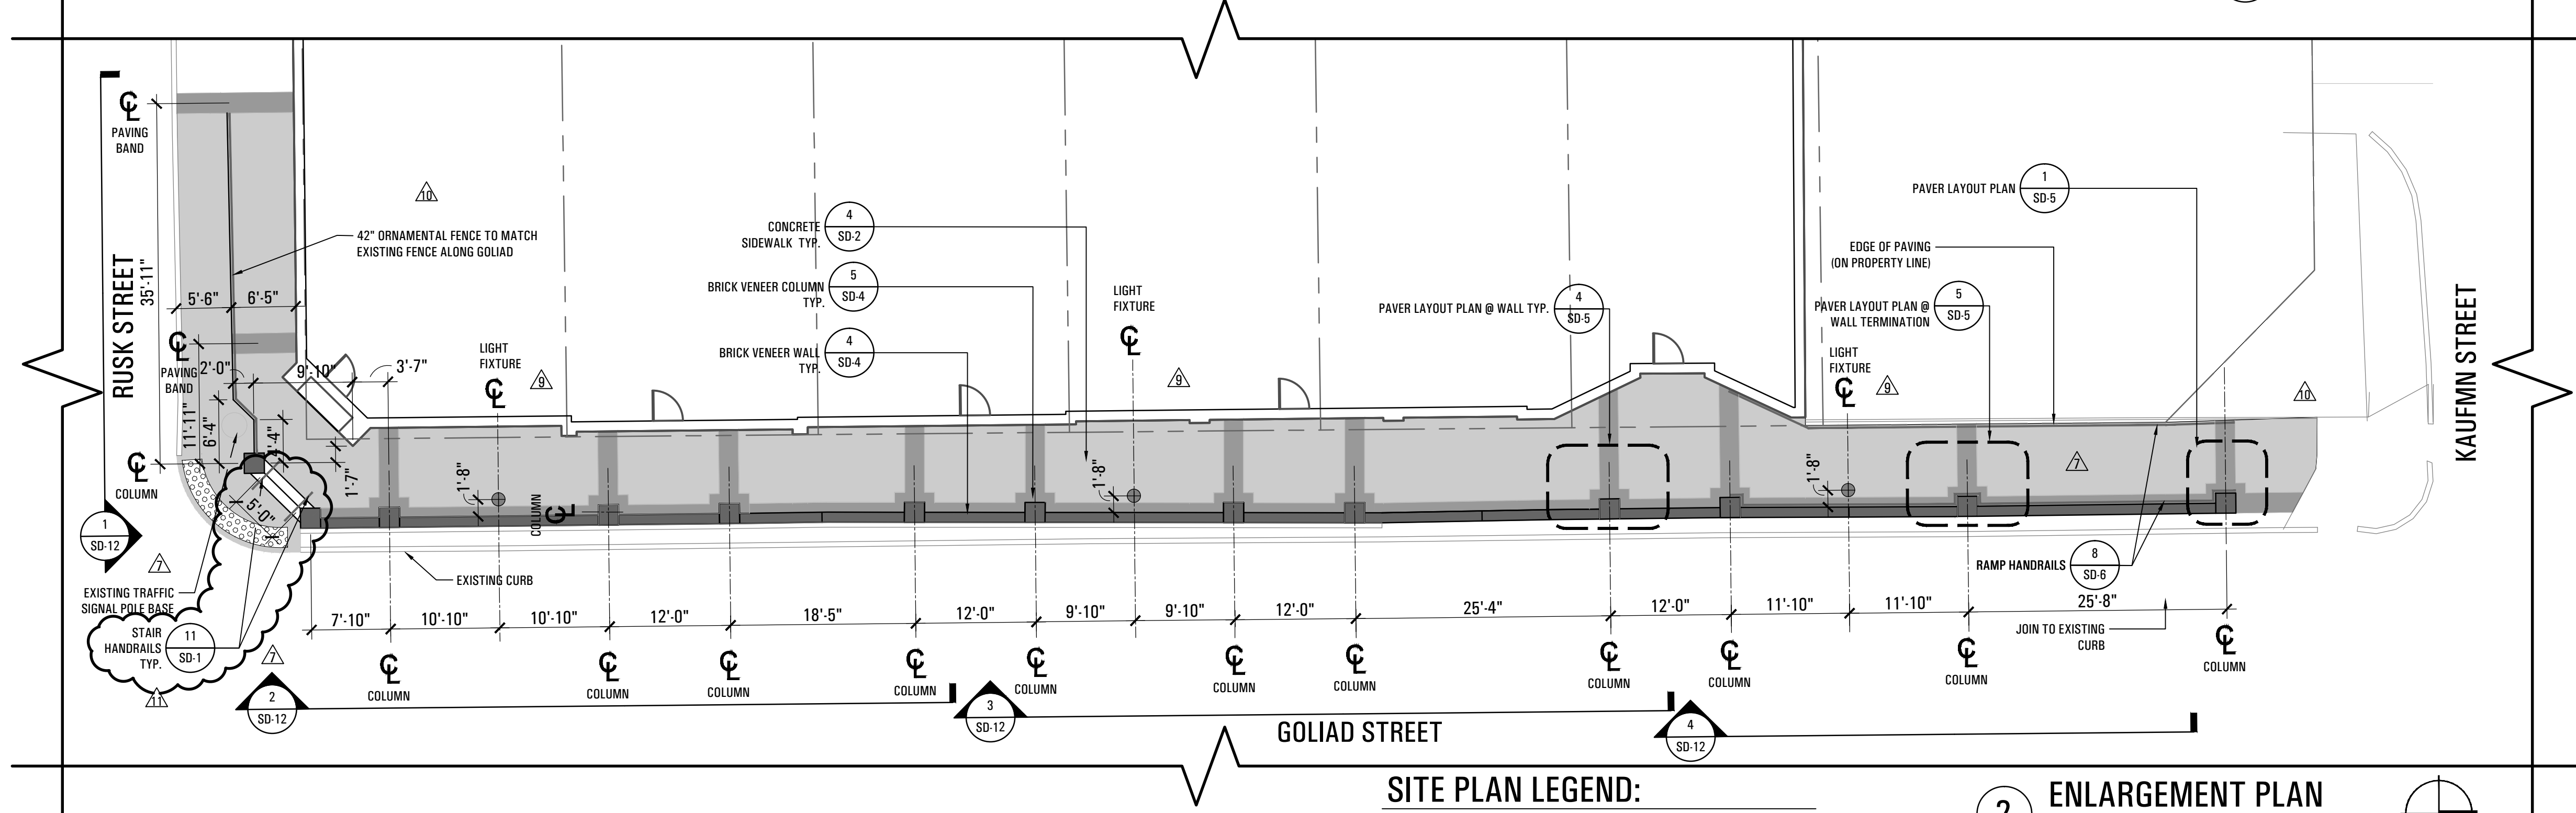

**2 ENLARGEMENT PLAN**  
SCALE: 1" = 10'-0"

**SITE PLAN LEGEND:**

- EDGE OF PAVEMENT
- ▬ CONCRETE SIDEWALK PAVEMENT
- ▬ CONCRETE VEHICULAR PAVEMENT
- TYPICAL LIGHT FIXTURE

- ▲ 10/09/15 RFI #200, #202
- ▲ 10/30/15 RFI #212

submittals / revisions

no.	date	detail
▲	05/13/14	RFI #71
▲	08/14/14	LASI #9
▲	07/31/14	LASI #10
▲	09/26/14	RFI #131
▲	10/16/14	RFI #137
▲	12/30/14	RFI #139
▲	06/04/15	LASI #18
▲	06/08/15	LASI #19
▲	09/28/15	RFI #196

la terra studio, inc.

12024  
 its project number  
 02.26.2014  
 date  
 rac; bhm  
 drawn by  
 mtb  
 checked by

