

Downtown Rockwall

Project # 12024 ~ renovation ~

streetscape improvements

rockwall, texas




submittals / revisions

no.	date	detail

la terra studio, inc.

12024
 Its project number
 02.26.2014
 date
 SAH
 drawn by
 SAH
 checked by

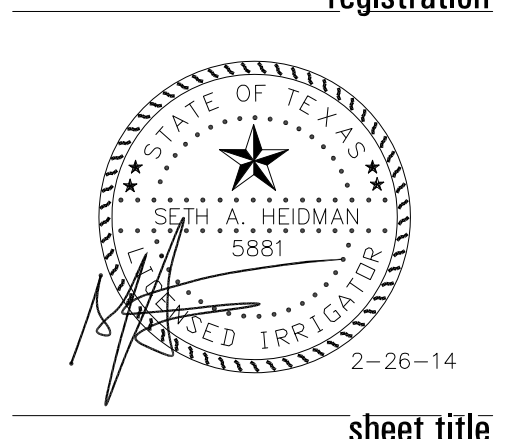

sheet title

Irrigation Plan

sheet number

IP-2