



© 2013 la terra studio, inc. All Rights Reserved FILE:P:\12024-Downtown Rockwall PSS&E - Rockwall\CAD\SSHEETS\12024\_Enlargement\_Plan\_key.dwg

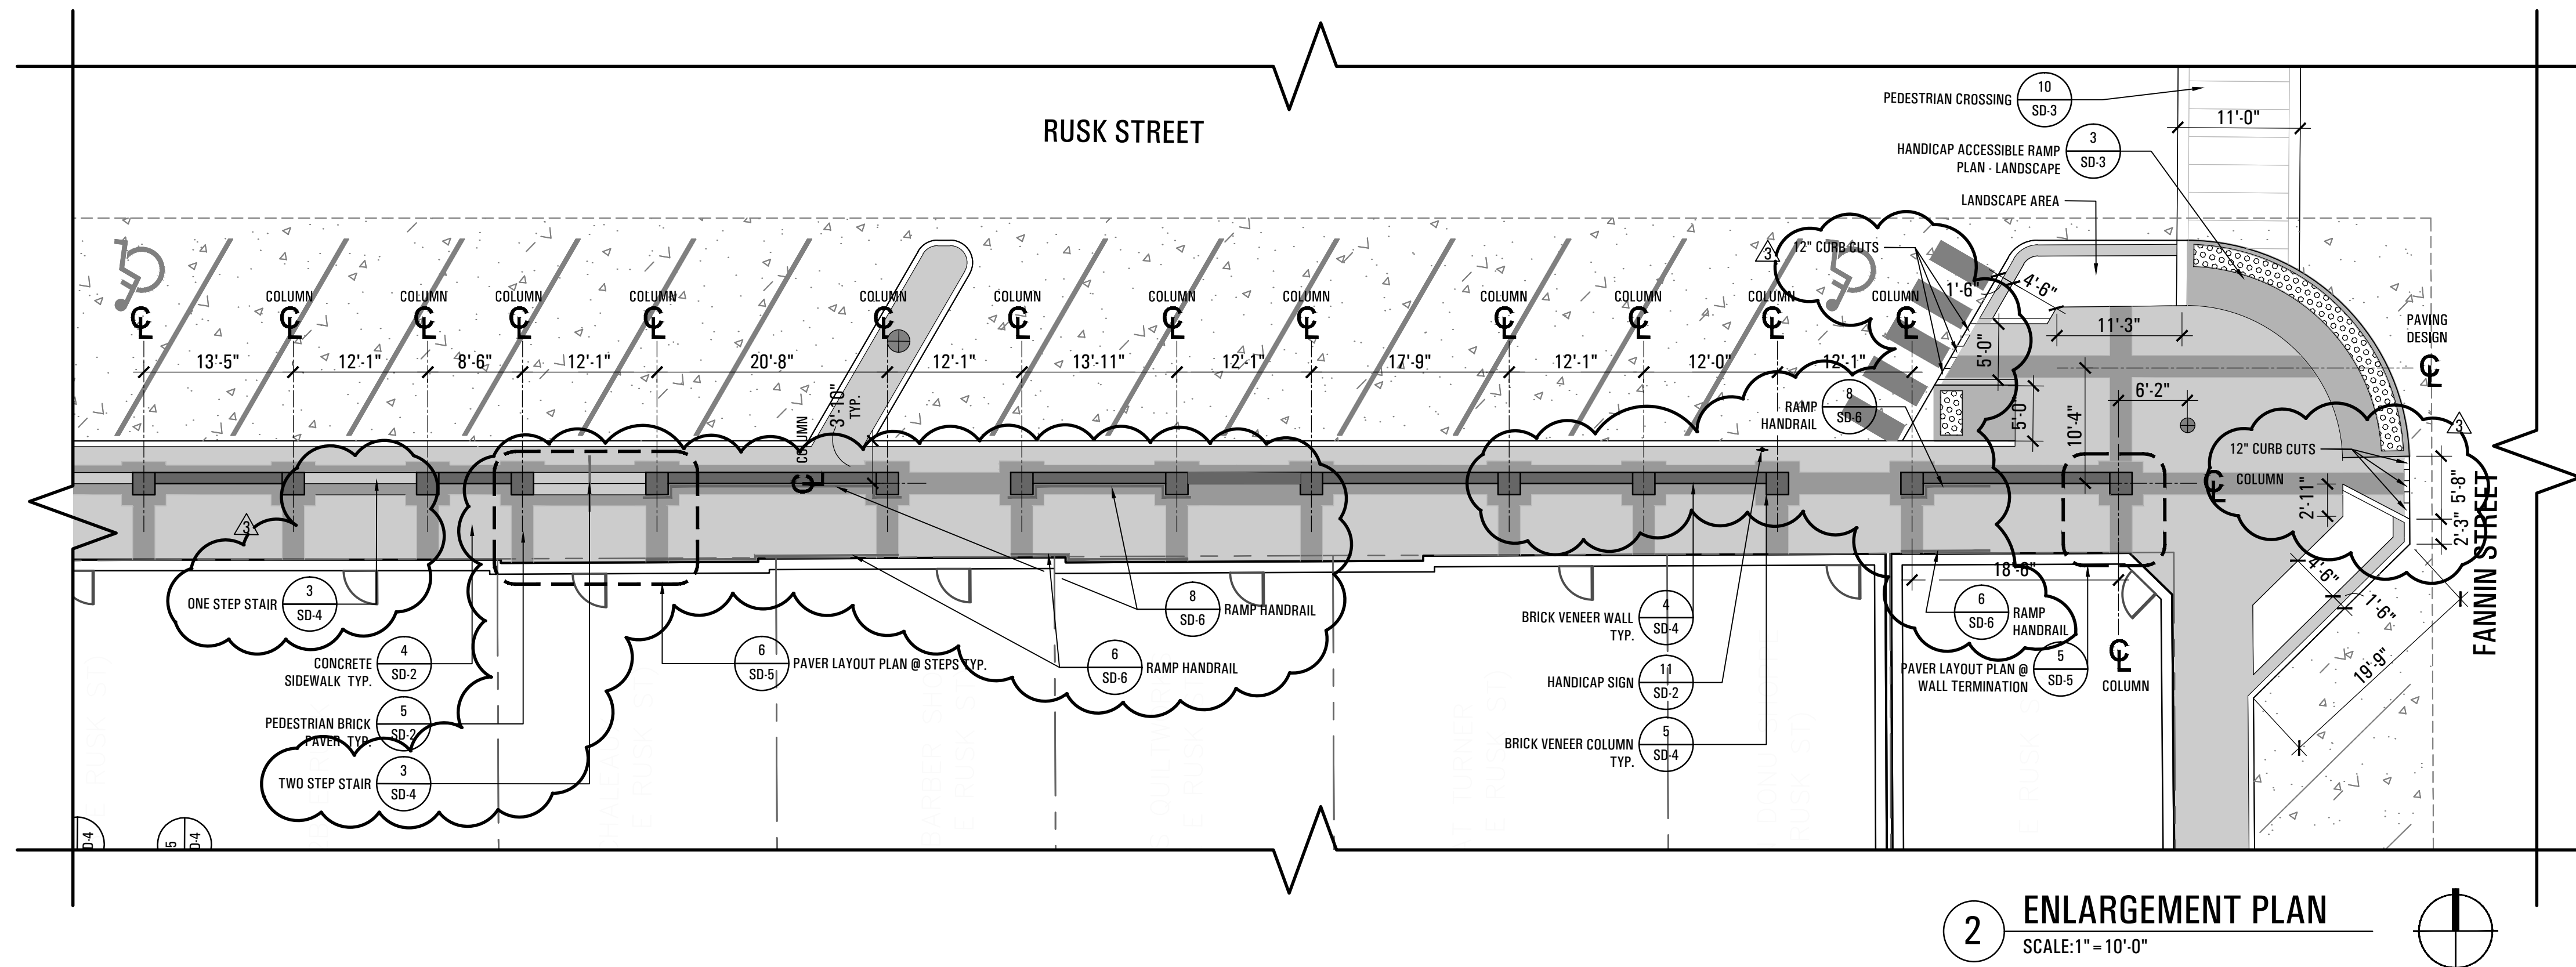

**SITE PLAN LEGEND:**

- EDGE OF PAVEMENT
- CONCRETE SIDEWALK PAVEMENT
- CONCRETE VEHICULAR PAVEMENT
- TYPICAL LIGHT FIXTURE

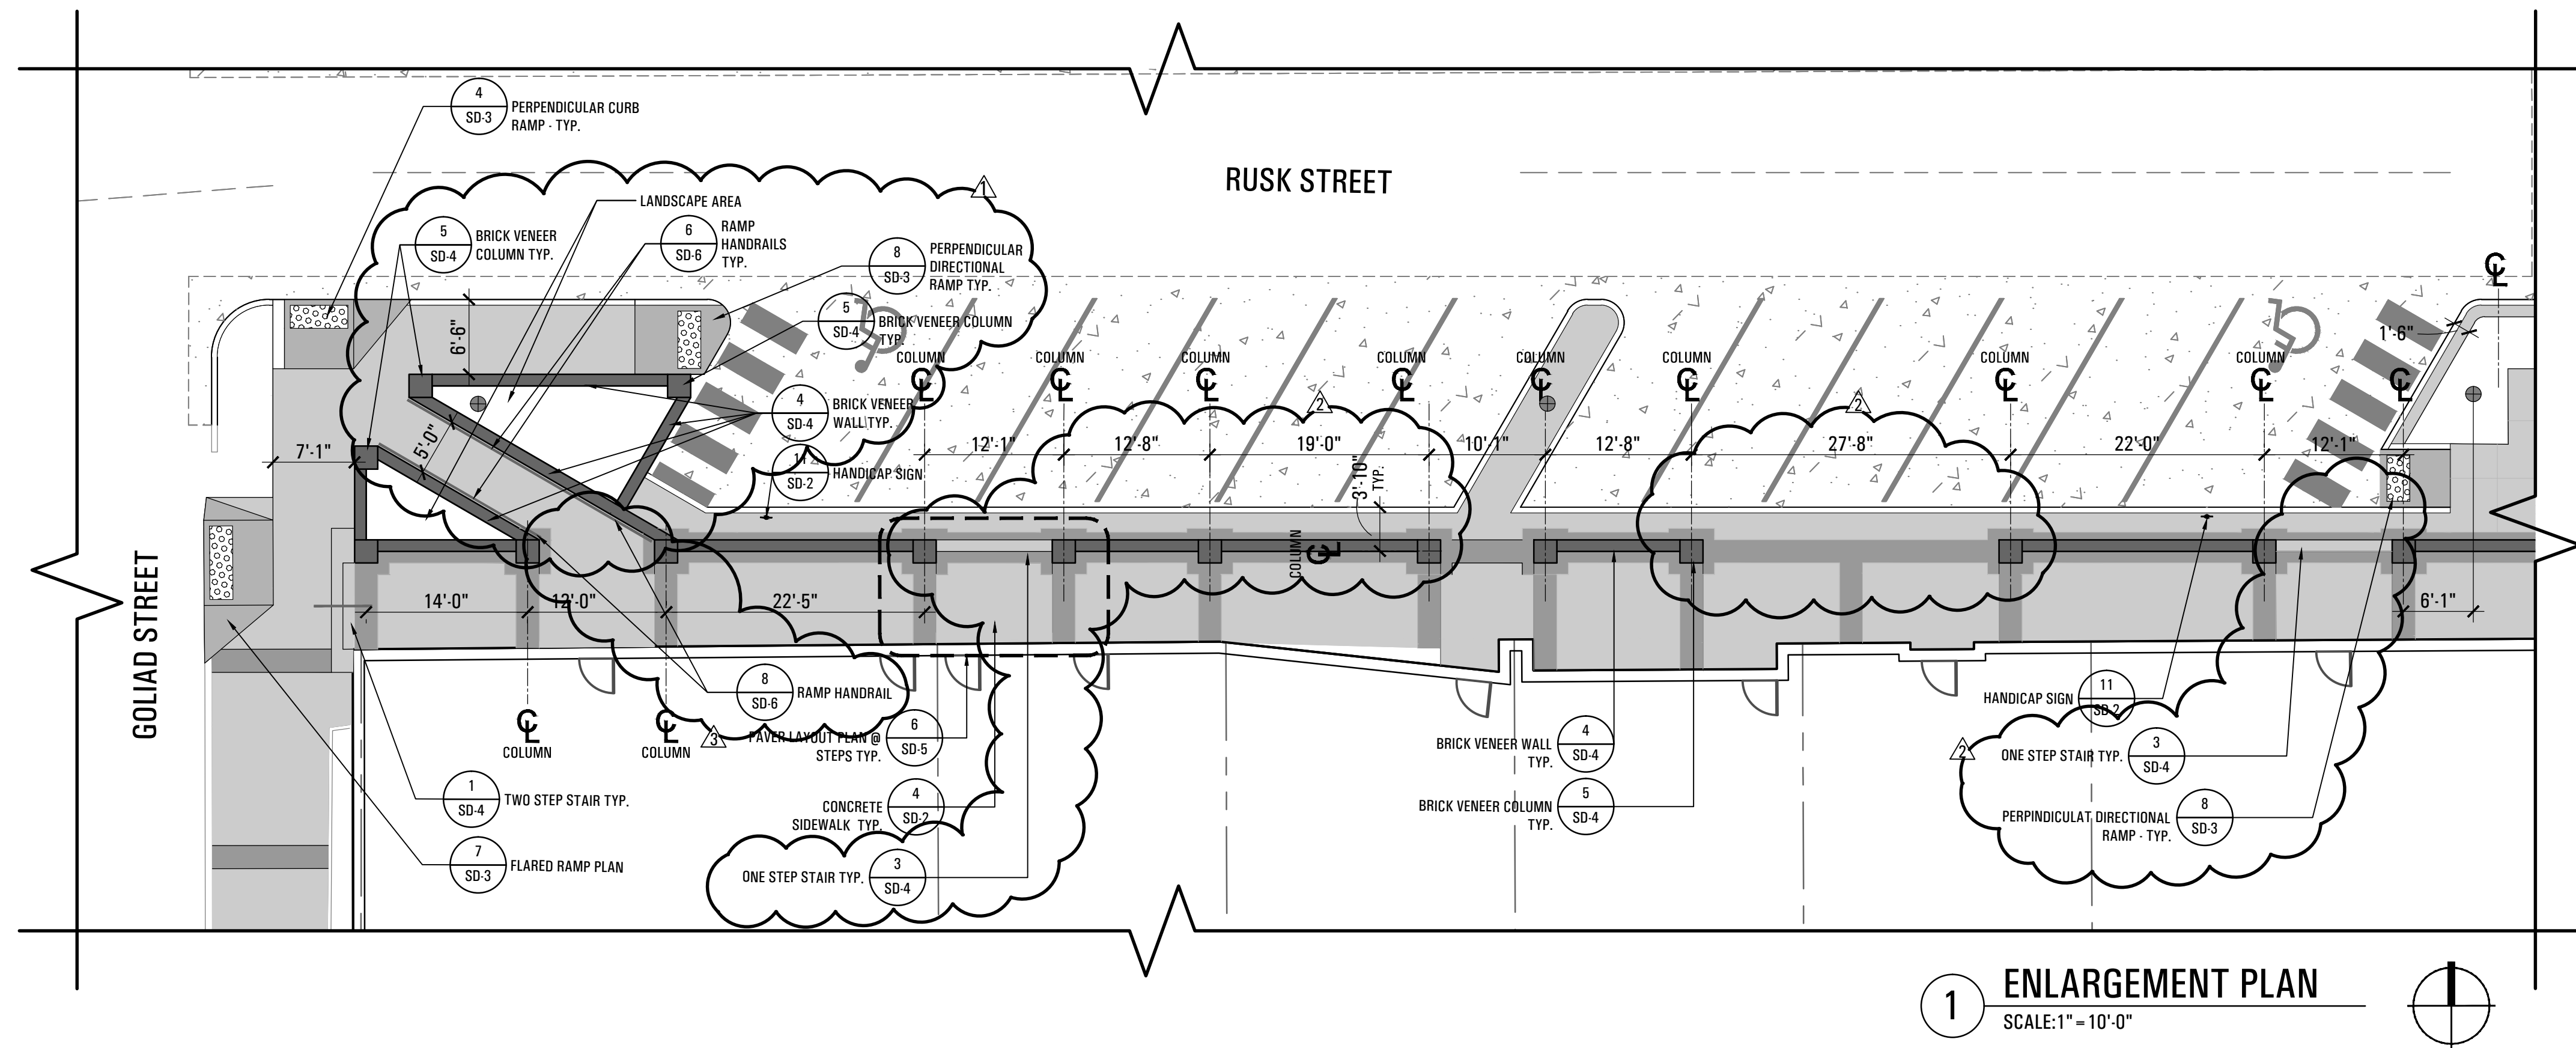


submittals / revisions

no.	date	detail
△	04/14/14	RFI #39
△	05/02/14	RFI #77 WEST RUSK GRADING
△	05/08/14	RFI #20, #38, #42, #43, #54

la terra studio, inc.

12024  
Its project number  
02.26.2014  
date  
rac; bhm  
drawn by  
mtb  
checked by

registration

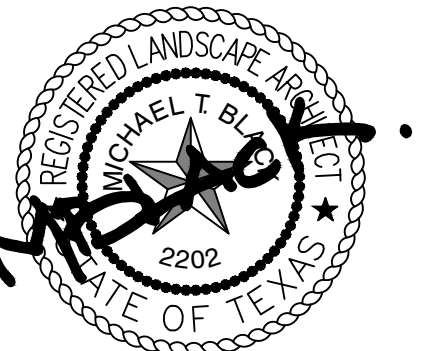

02.26.2014  
sheet title

Enlargement Plan  
sheet number

**EP-3**