



submittals / revisions

no.	date	detail
▲	04/24/14	RFI #79
▲	05/08/14	RFI #38


la terra studio, inc.

12024
 its project number
 02.26.2014
 date
 rac; bhm
 drawn by
 mtb
 checked by




Site Details
 sheet number


SD-6

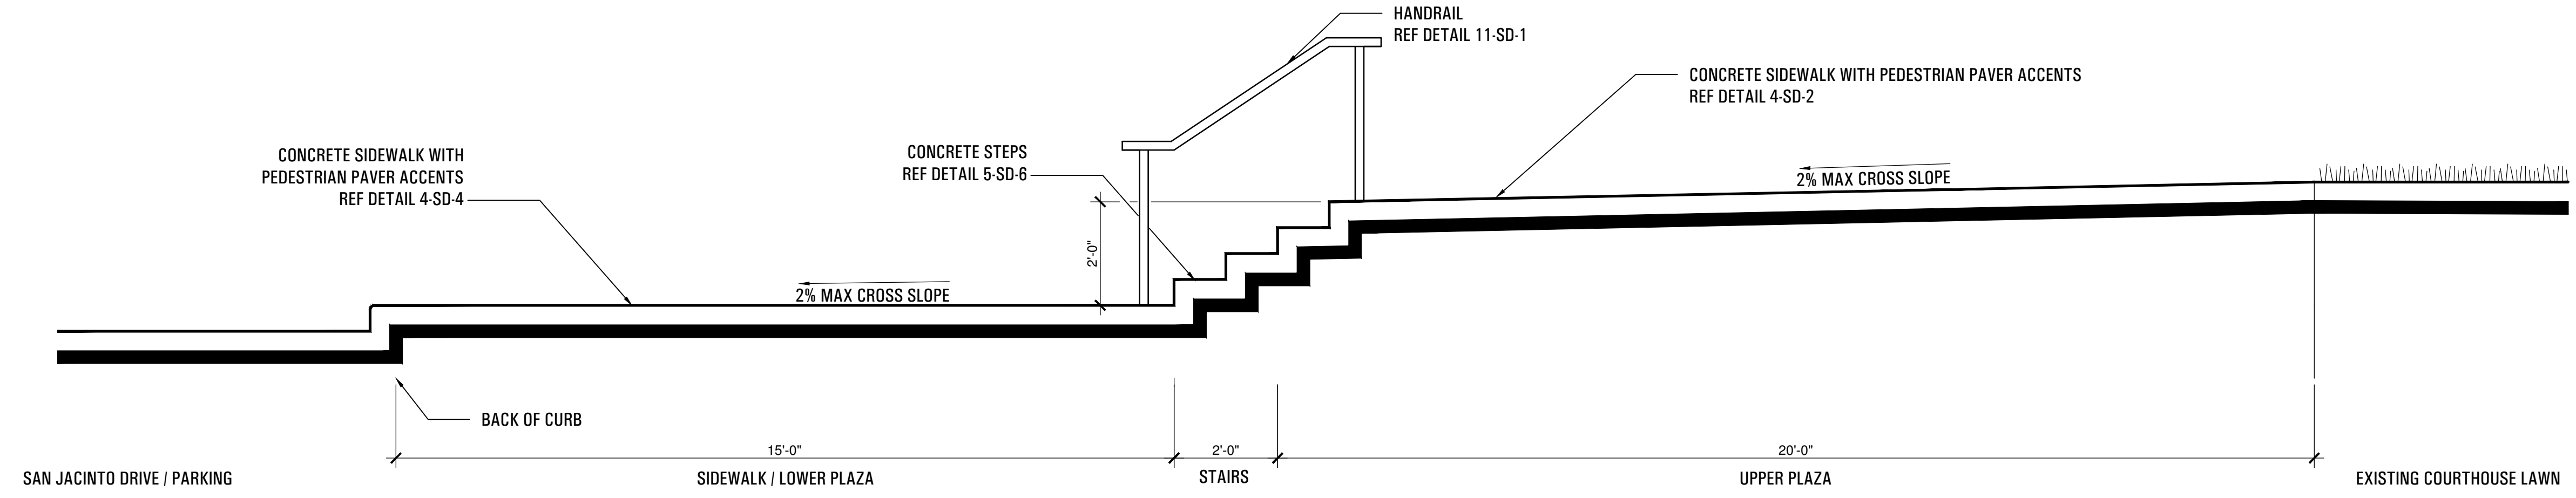


1 COURTHOUSE PLAZA SECTION
 SCALE: 1/2" = 1'-0"

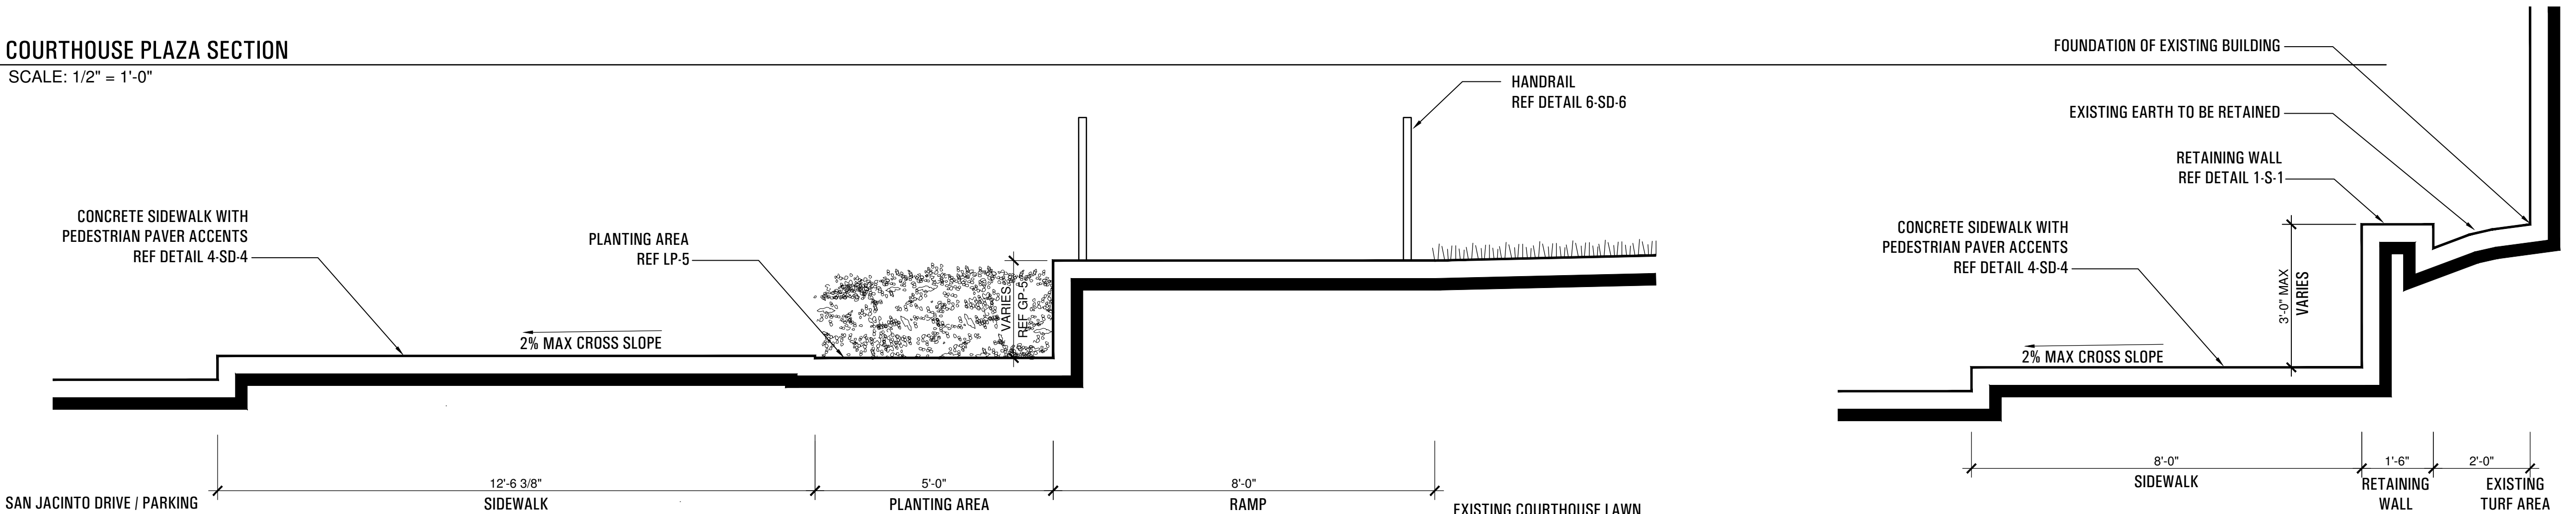


2 COURTHOUSE PLAZA RAMP SECTION
 SCALE: 1/2" = 1'-0"

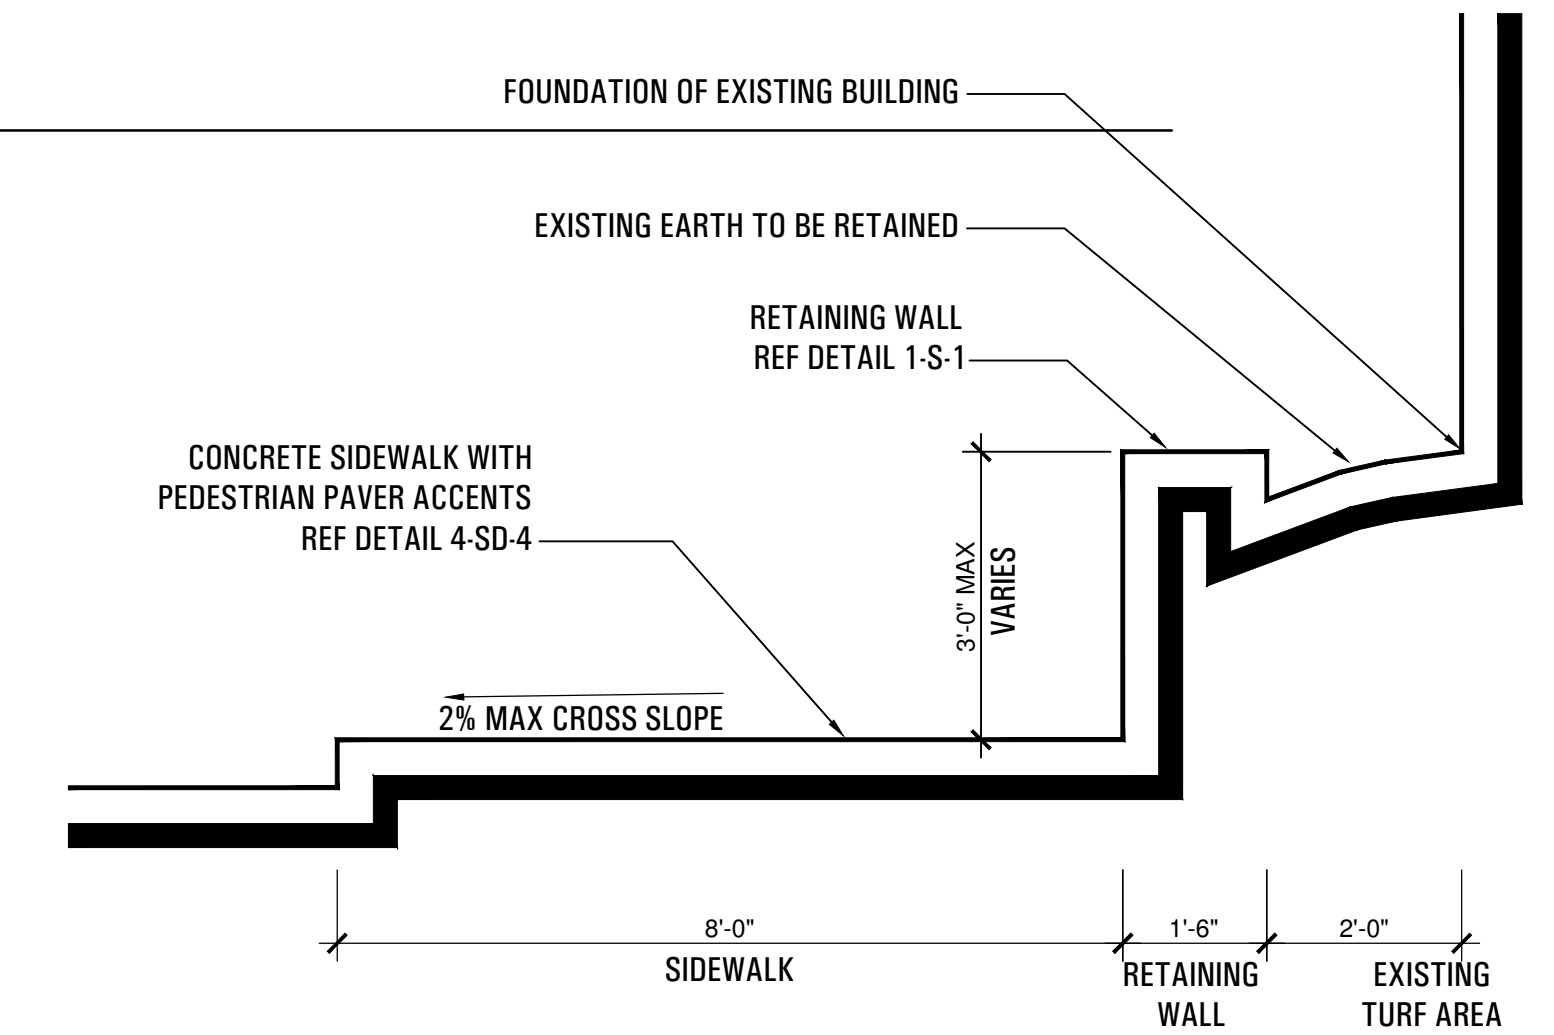


3 PEDESTRIAN WALKWAY ALONG SOUTH OF WASHINGTON PARKING AREA
 SCALE: 1/2" = 1'-0"

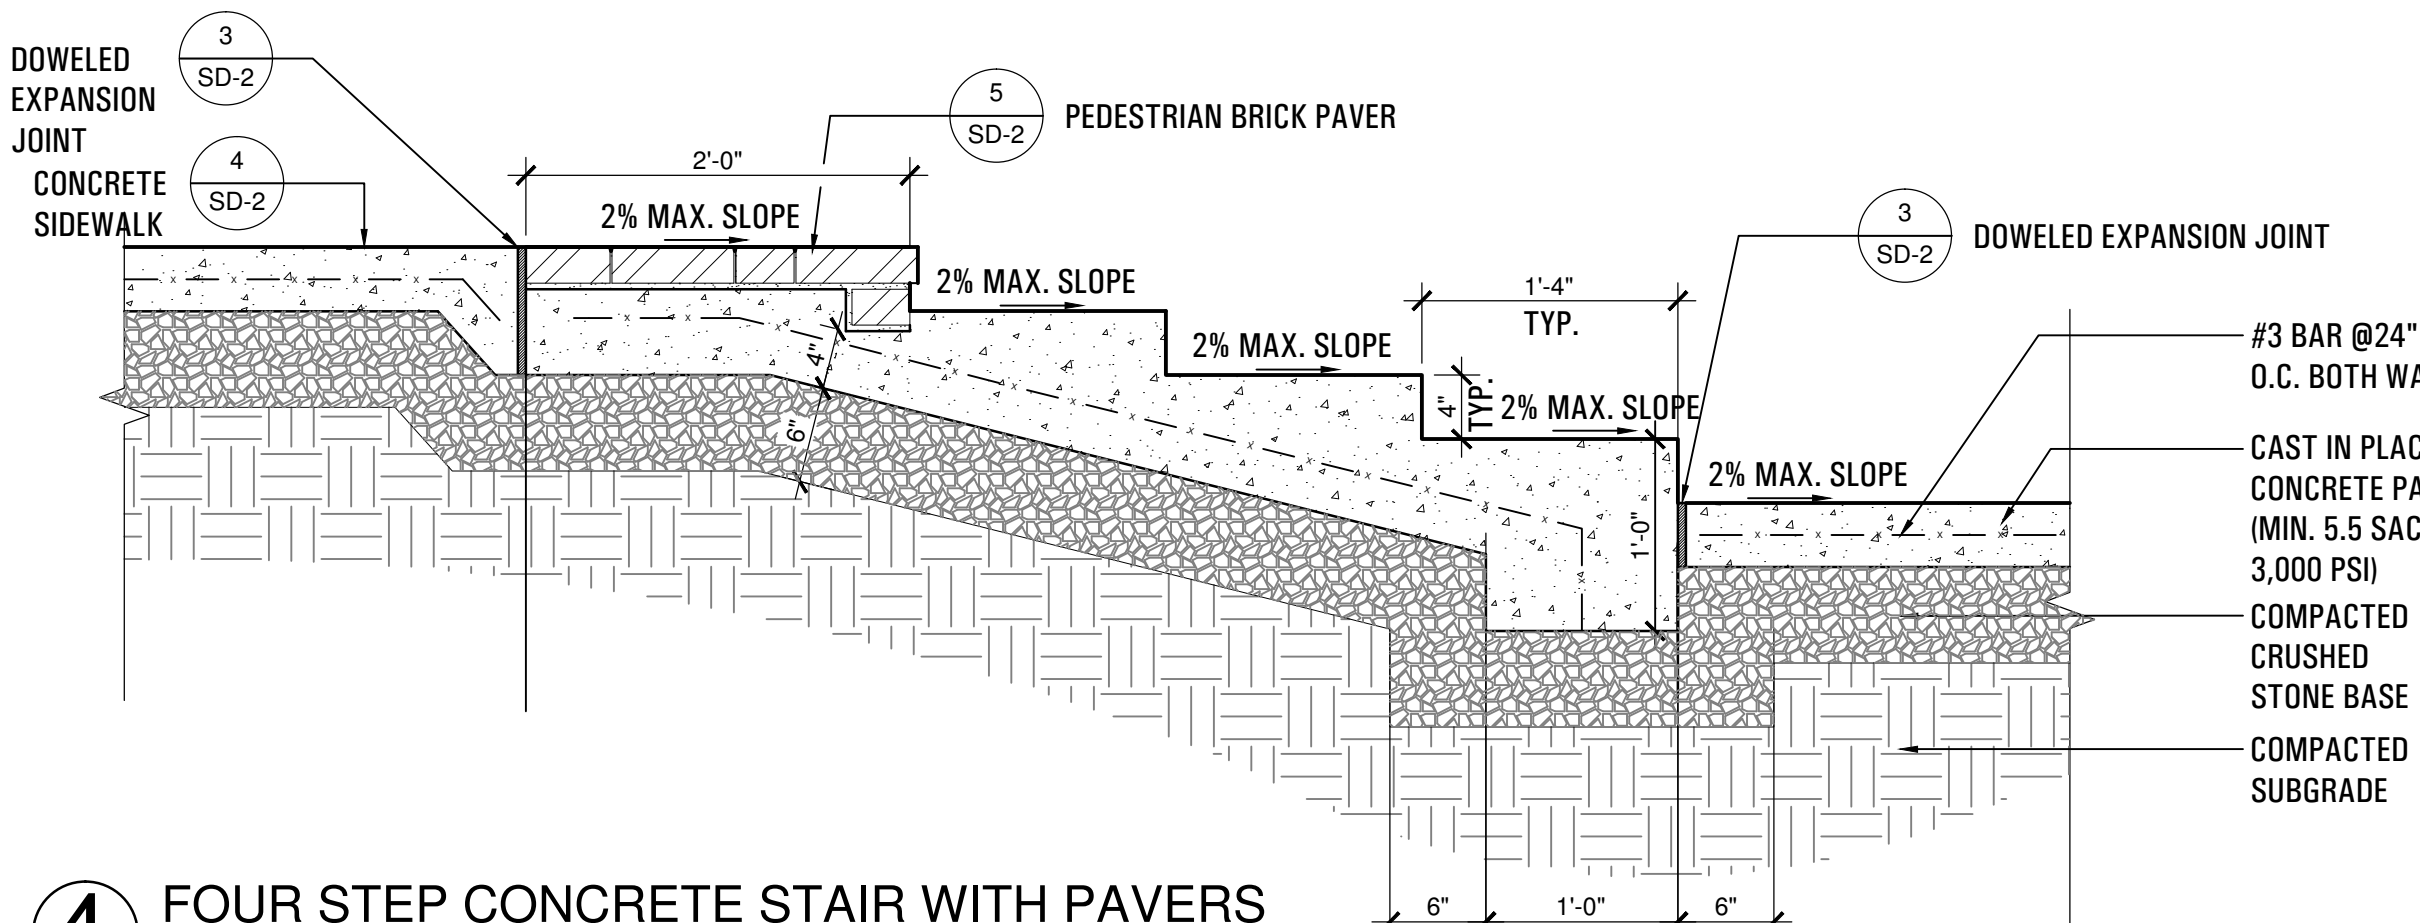


4 FOUR STEP CONCRETE STAIR WITH PAVERS
 SCALE: 1" = 1'-0"

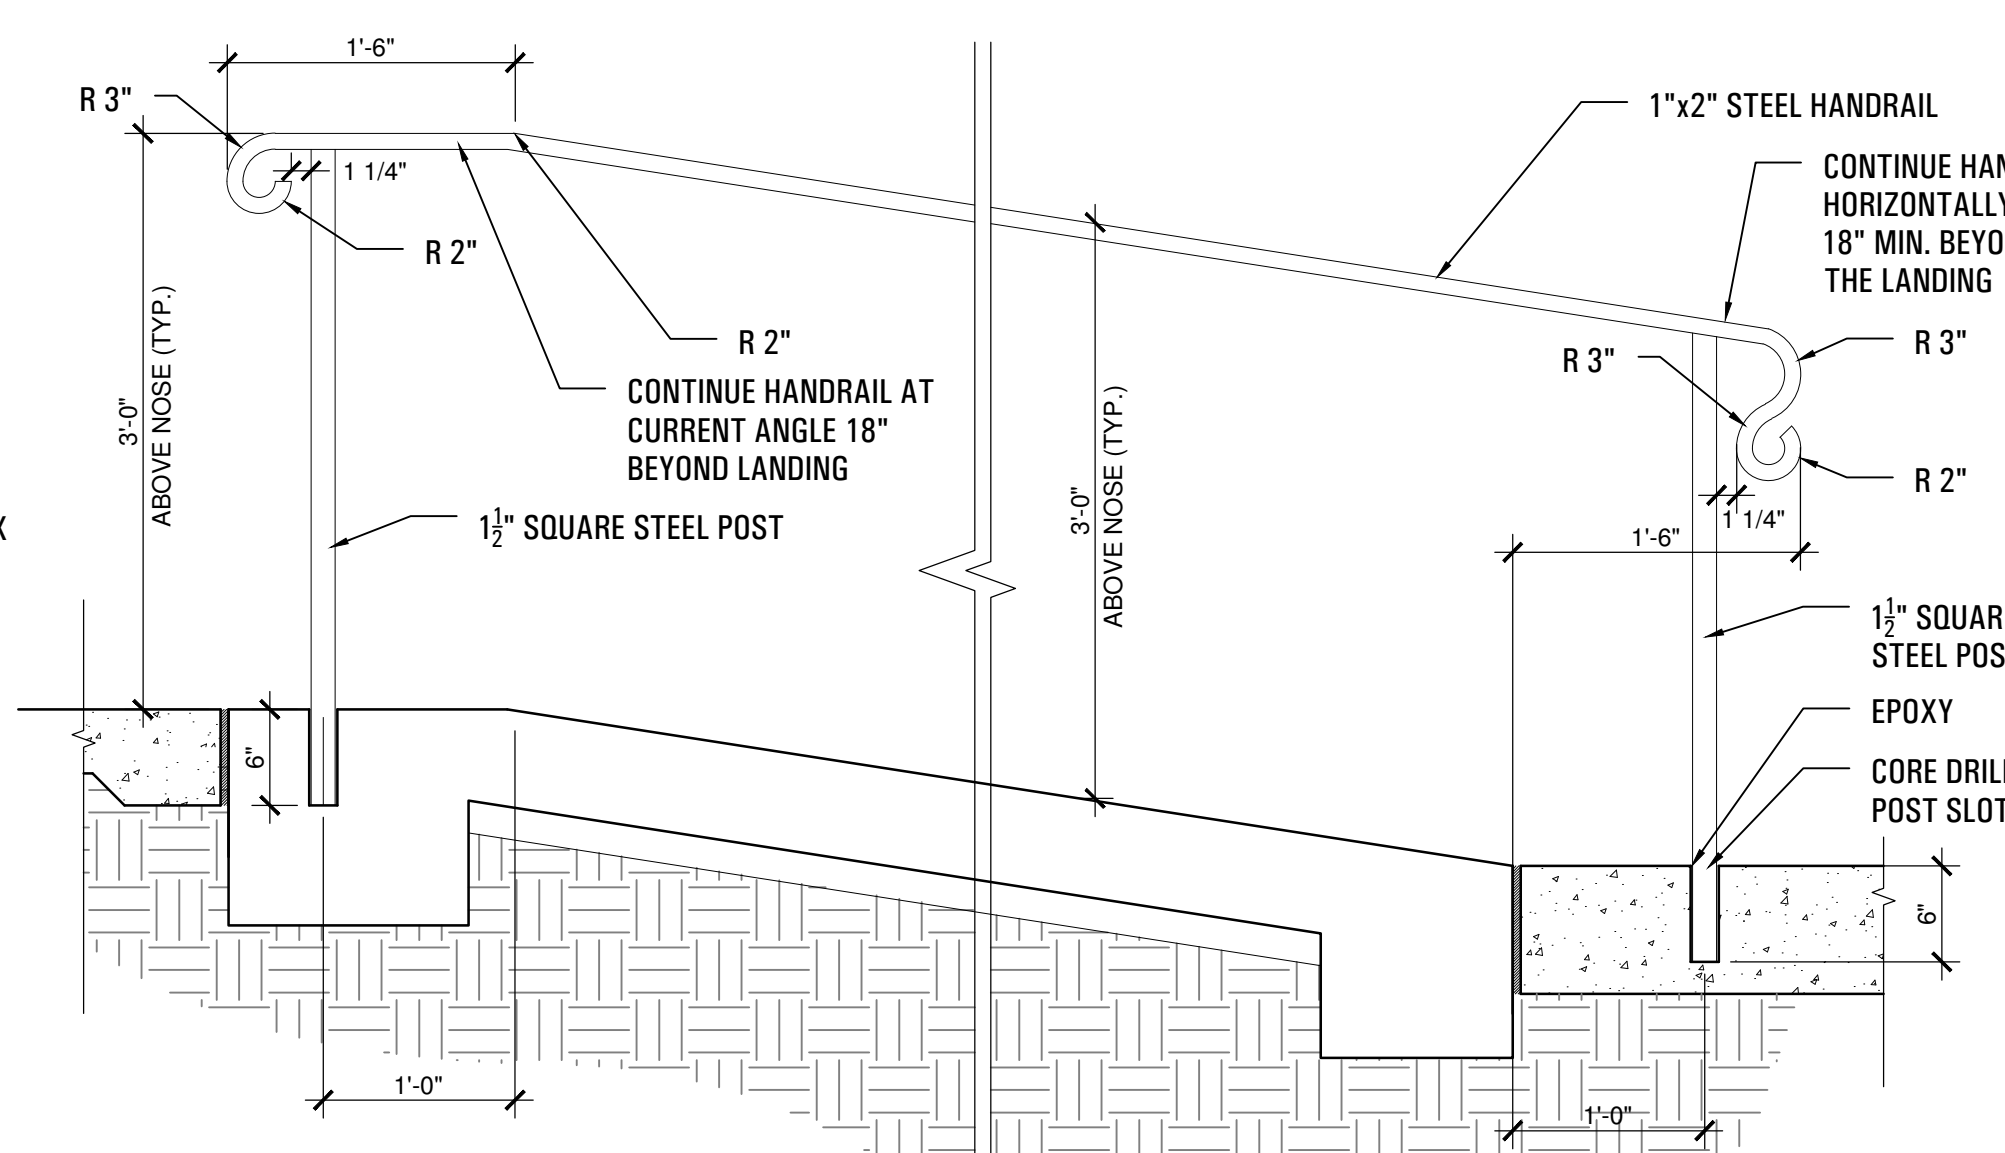


6 RAMP HANDRAIL DETAIL
 SCALE: 1" = 1'-0"

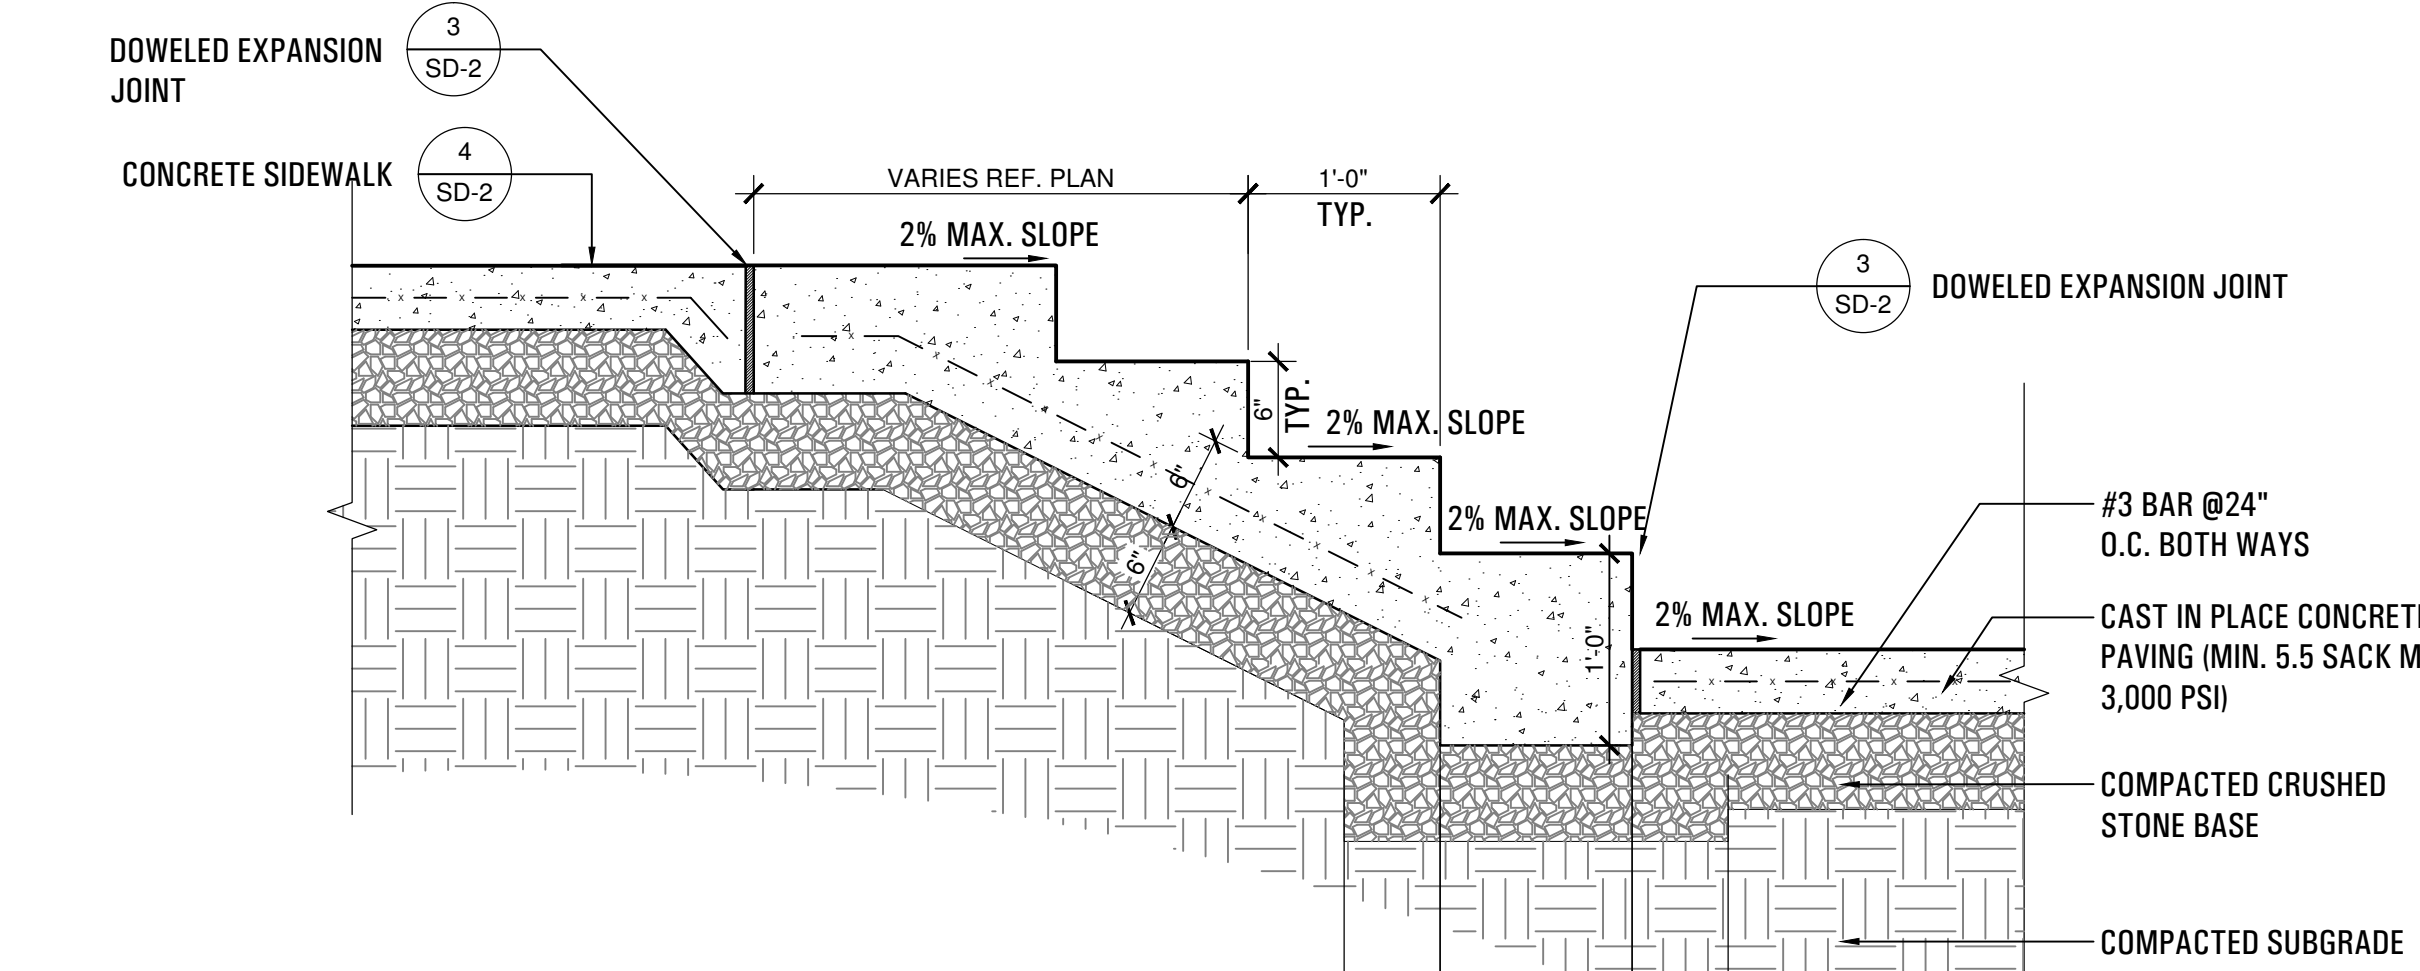

5 FOUR STEP CONCRETE STAIR
 TREE WELL WITH GRATE
 SCALE: 3/4" = 1'-0"

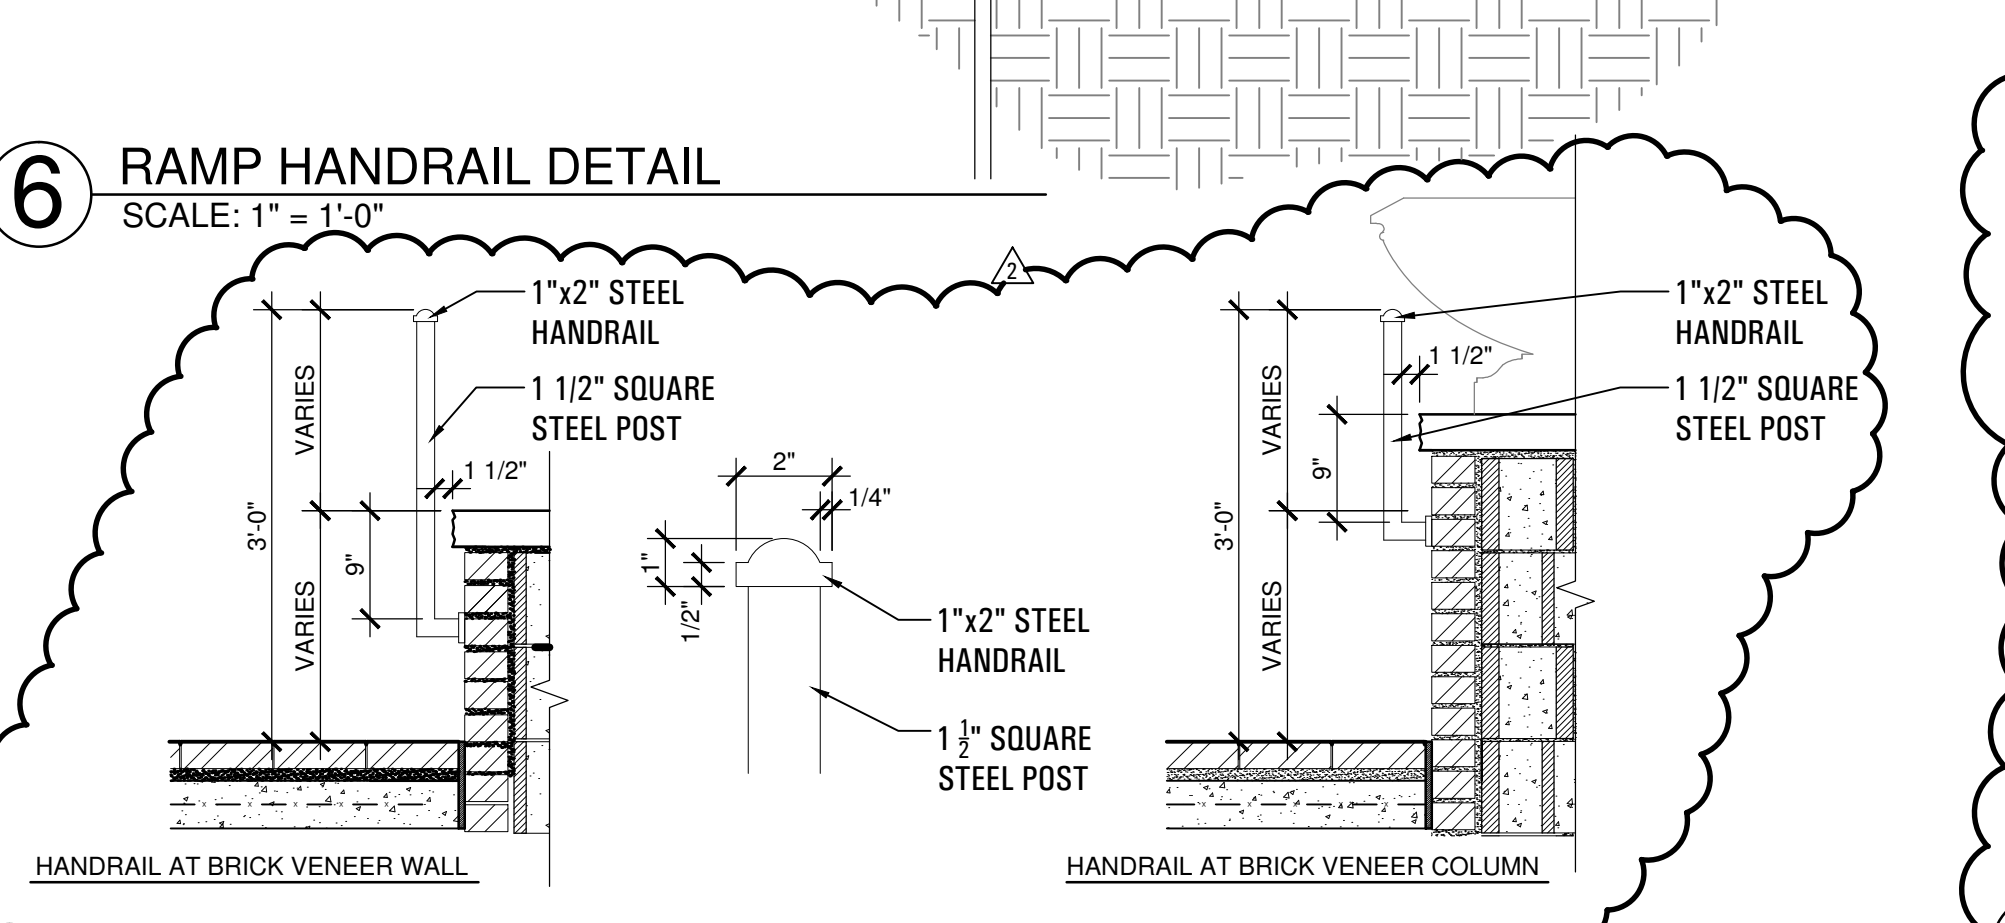

8 RAMP HANDRAIL DETAIL
 SCALE: 3/4" = 1'-0"

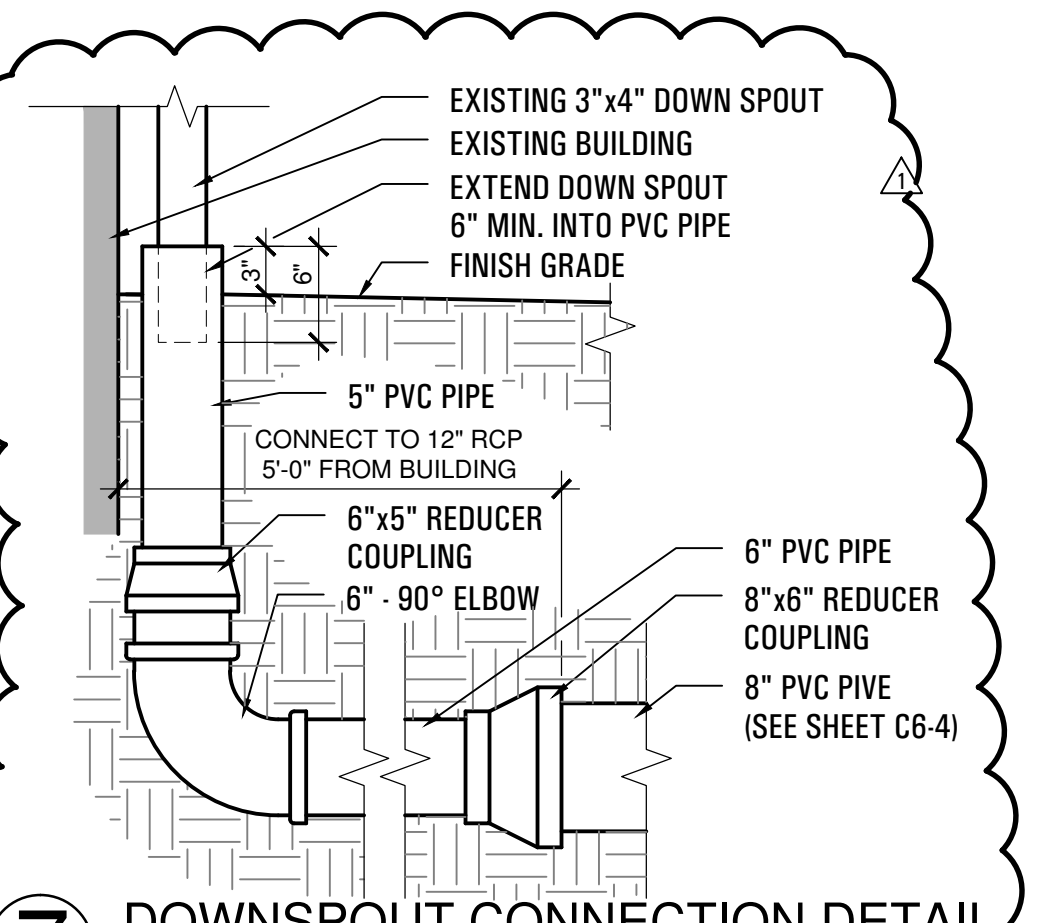

7 DOWNSPOUT CONNECTION DETAIL
 SCALE: 1" = 1'-0"

© 2013 la terra studio, inc. All Rights Reserved FILE:R:\12024-Downtown Rockwall PS&E - Rockwall\CAD\Sheet\12024-Str Details_6.dwg