


SITE PLAN LEGEND:

- PROJECT LIMIT LINE
- EDGE OF PAVEMENT
- CONCRETE SIDEWALK PAVEMENT
- CONCRETE VEHICULAR PAVEMENT
- TYPICAL LIGHT FIXTURE

sheet location

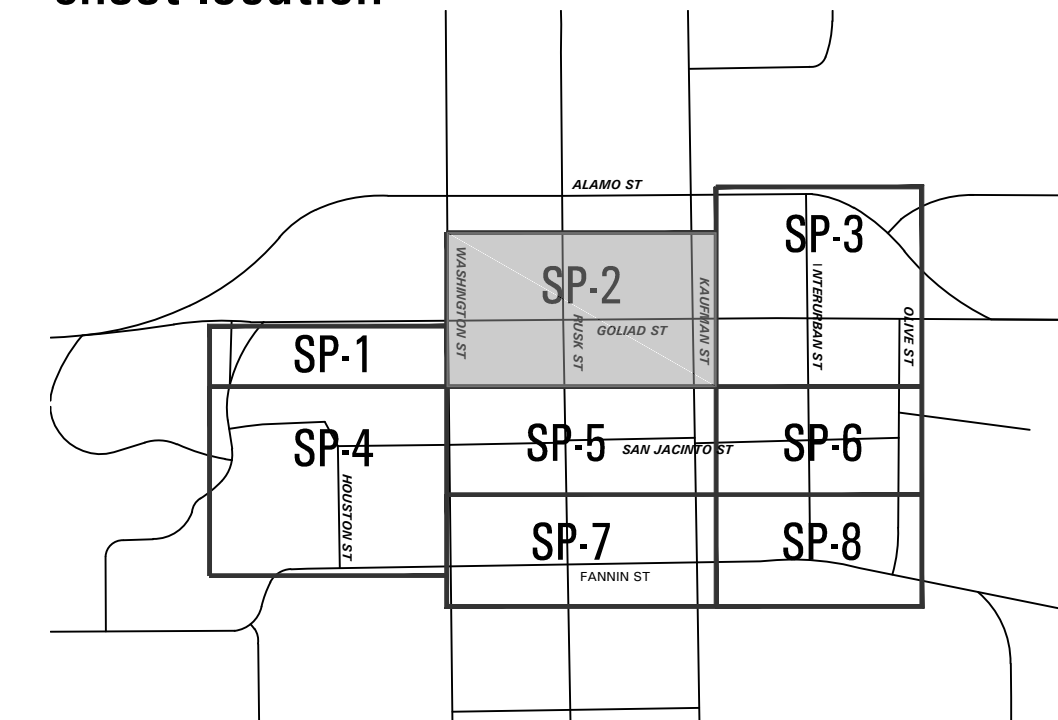

Downtown Rockwall
 la terra studio Project #12024
streetscape improvements
 PHASE 2
 rockwall, texas



submittals / revisions

no.	date	detail
▲	04/10/14	RFI #23
▲	09/10/14	RFI #124
▲	09/10/15	RFI #38

la terra studio, inc.
 12024
 its project number
 02.26.2014
 date
 rac; bhm
 drawn by
 mtb
 checked by

registration



02.26.2014
 sheet title
Site Plan
 sheet number
SP-2