


GRADING PLAN LEGEND:

- 580 ——— EXISTING GRADE CONTOUR
- 581 ——— FINISH GRADE CONTOUR
- 587.25 ——— FINISH SPOT GRADE
- 580.00 ——— SEE CIVIL FOR CROSS REFERENCE OF PROPOSED ELEVATION
- TS ——— TOP STEP
- BS ——— BOTTOM STEP
- TW ——— TOP OF WALL
- BW ——— BOTTOM OF WALL
- TC ——— TOP OF CURB
- G ——— GUTTER
- FF ——— FINISH FLOOR
- TCOL ——— TOP OF COLUMN

NO.	DATE	DETAIL
1	08/29/14	RFI #120
2	09/03/14	RFI #122
3	09/16/14	RFI #121, #125
4	10/16/14	RFI #137
5	11/26/14	LASI #12
6	12/02/14	RFI #63
7	12/09/14	RFI #152
8	12/30/14	RFI #139
9	01/13/15	LASI #14
10	04/15/15	RFI #173

sheet location

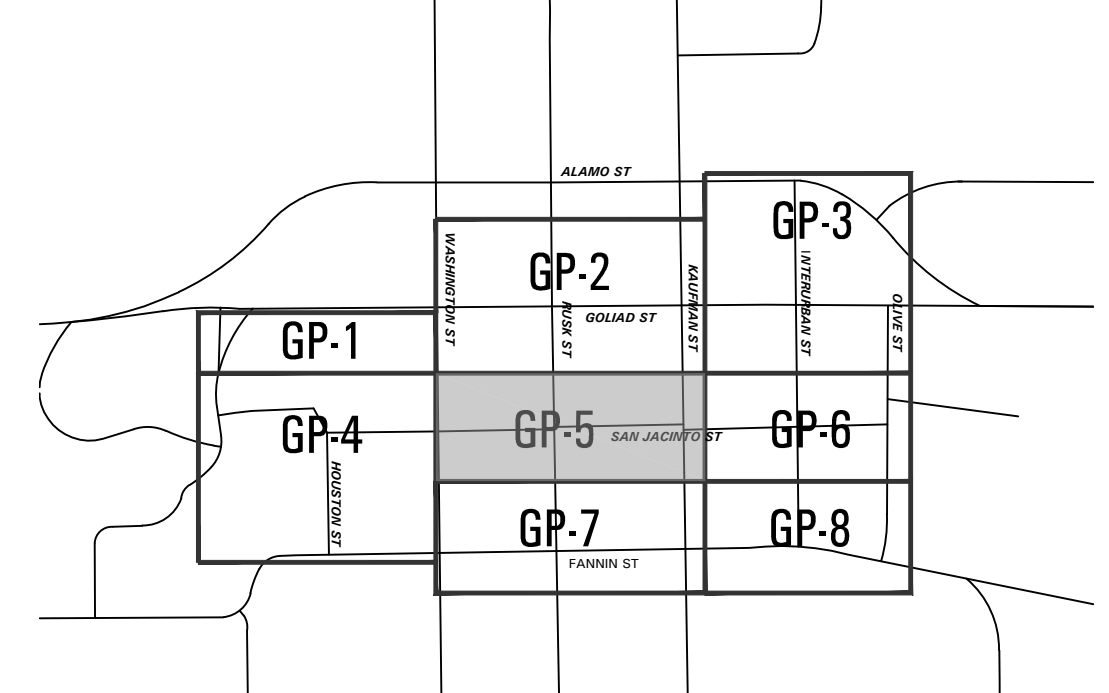

Downtown Rockwall
 la terra studio Project #12024
streetscape improvements
 PHASE 2
 rockwall, texas



submittals / revisions

NO.	DATE	DETAIL
1	04/02/14	RFI #29
2	05/02/14	RFI #77 WEST RUSK GRADING
3	05/08/14	RFI #20, #42, #43, #54
4	05/12/14	LASI #5
5	05/13/14	RFI #52
6	05/30/14	RFI #40
7	07/25/14	RFI #104
8	08/14/14	LASI #9
9	07/31/14	LASI #10

la terra studio, inc.

12024
 lts project number
 02.26.2014
 date
 rac; bhm
 drawn by
 mth
 checked by



Grading Plan
 sheet number
GP-5