


DEMOLITION LEGEND:

- PROJECT LIMIT LINE
- EXISTING CURB TO BE REMOVED
- SAW-CUT
- MATERIAL TO BE REMOVED
- EXISTING PAVING REMOVED
- EXISTING VEHICULAR PAVING REMOVED
- EXISTING BITUMINOUS WEARING COURSE TO BE REMOVED TO A DEPTH OF 2"
- EXISTING TREE TO BE REMOVED
- EXISTING TREE TO BE PROTECTED

sheet location

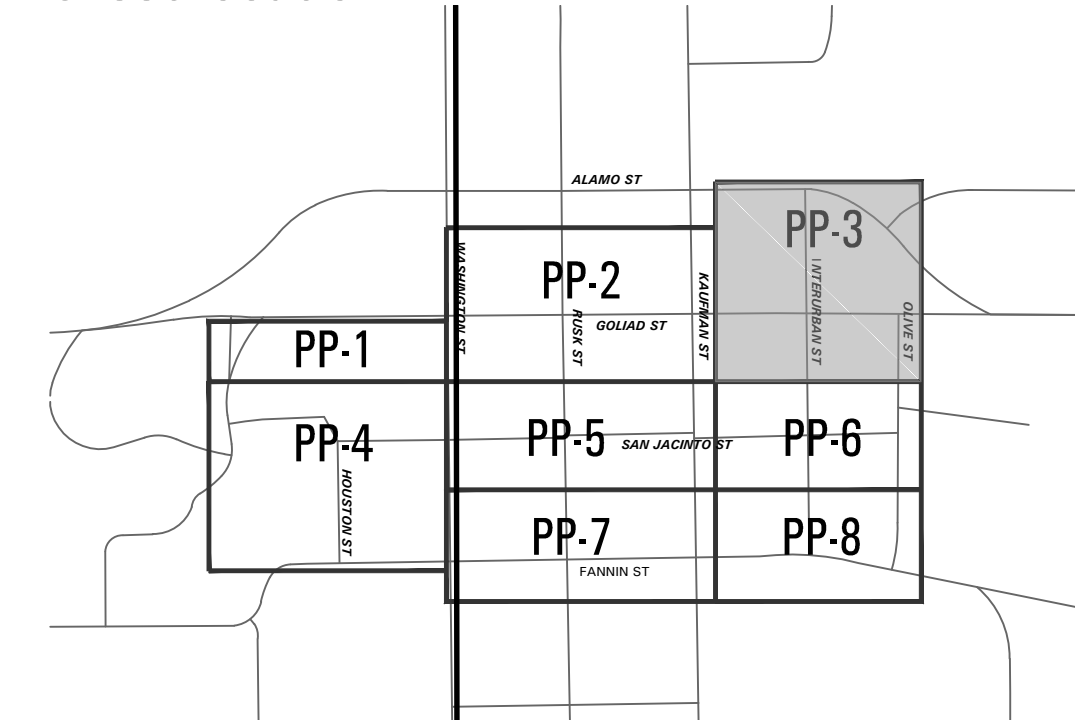

Call 1.800.DIG-TESS 2 Working Days BEFORE You Dig!
 www.digtess.org **Dig Safely**
 SHEET NOTES



Downtown Rockwall
 streetscape improvements
 PHASE 2
 rockwall, texas

la terra studio Project #12024

submittals / revisions

no.	date	detail
▲	05/13/14	RFI #48

la terra studio, inc.

12024
 Its project number
 02.26.2014
 date
 rac; bhm
 drawn by
 mtb
 checked by



Site Preparation Plan
 sheet number
PP-3