

submittals / revisions

no.	date	detail
△	4/2/14	Electrical Revisions
△	5/8/14	Electrical Revisions
△	7/24/14	Utility Relocations

la terra studio, inc.


12024
its project number
02.26.2014
date
C.A.D.
drawn by
J.W.
checked by

registration




sheet title
Large Scale Elec. Plans - Phase 2
sheet number


EL2.01

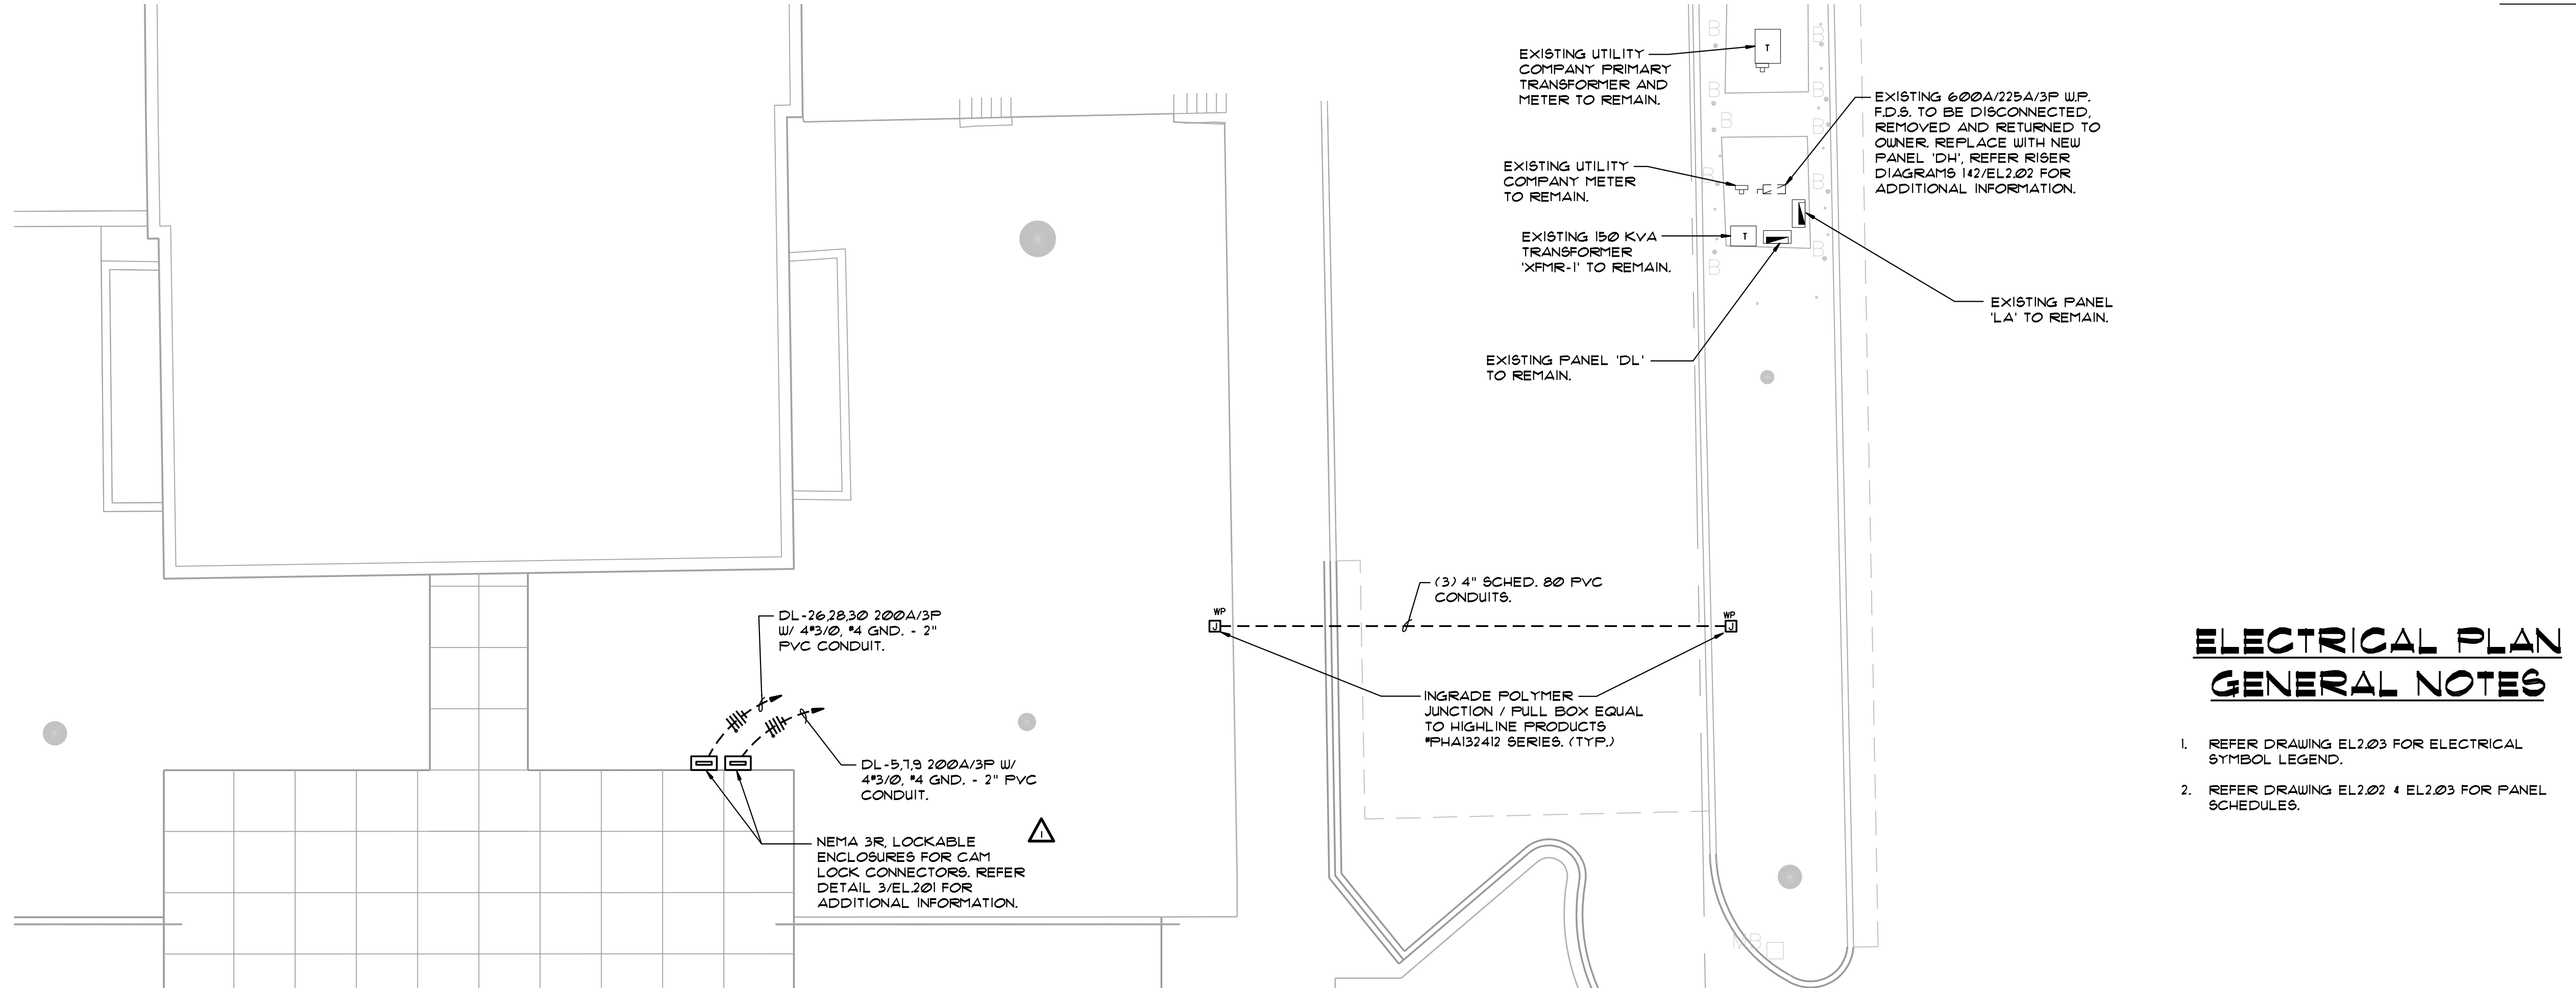

1 COURTHOUSE STAGE AREA PLAN - POWER - PHASE 2
SCALE: 1/8" = 1'-0"

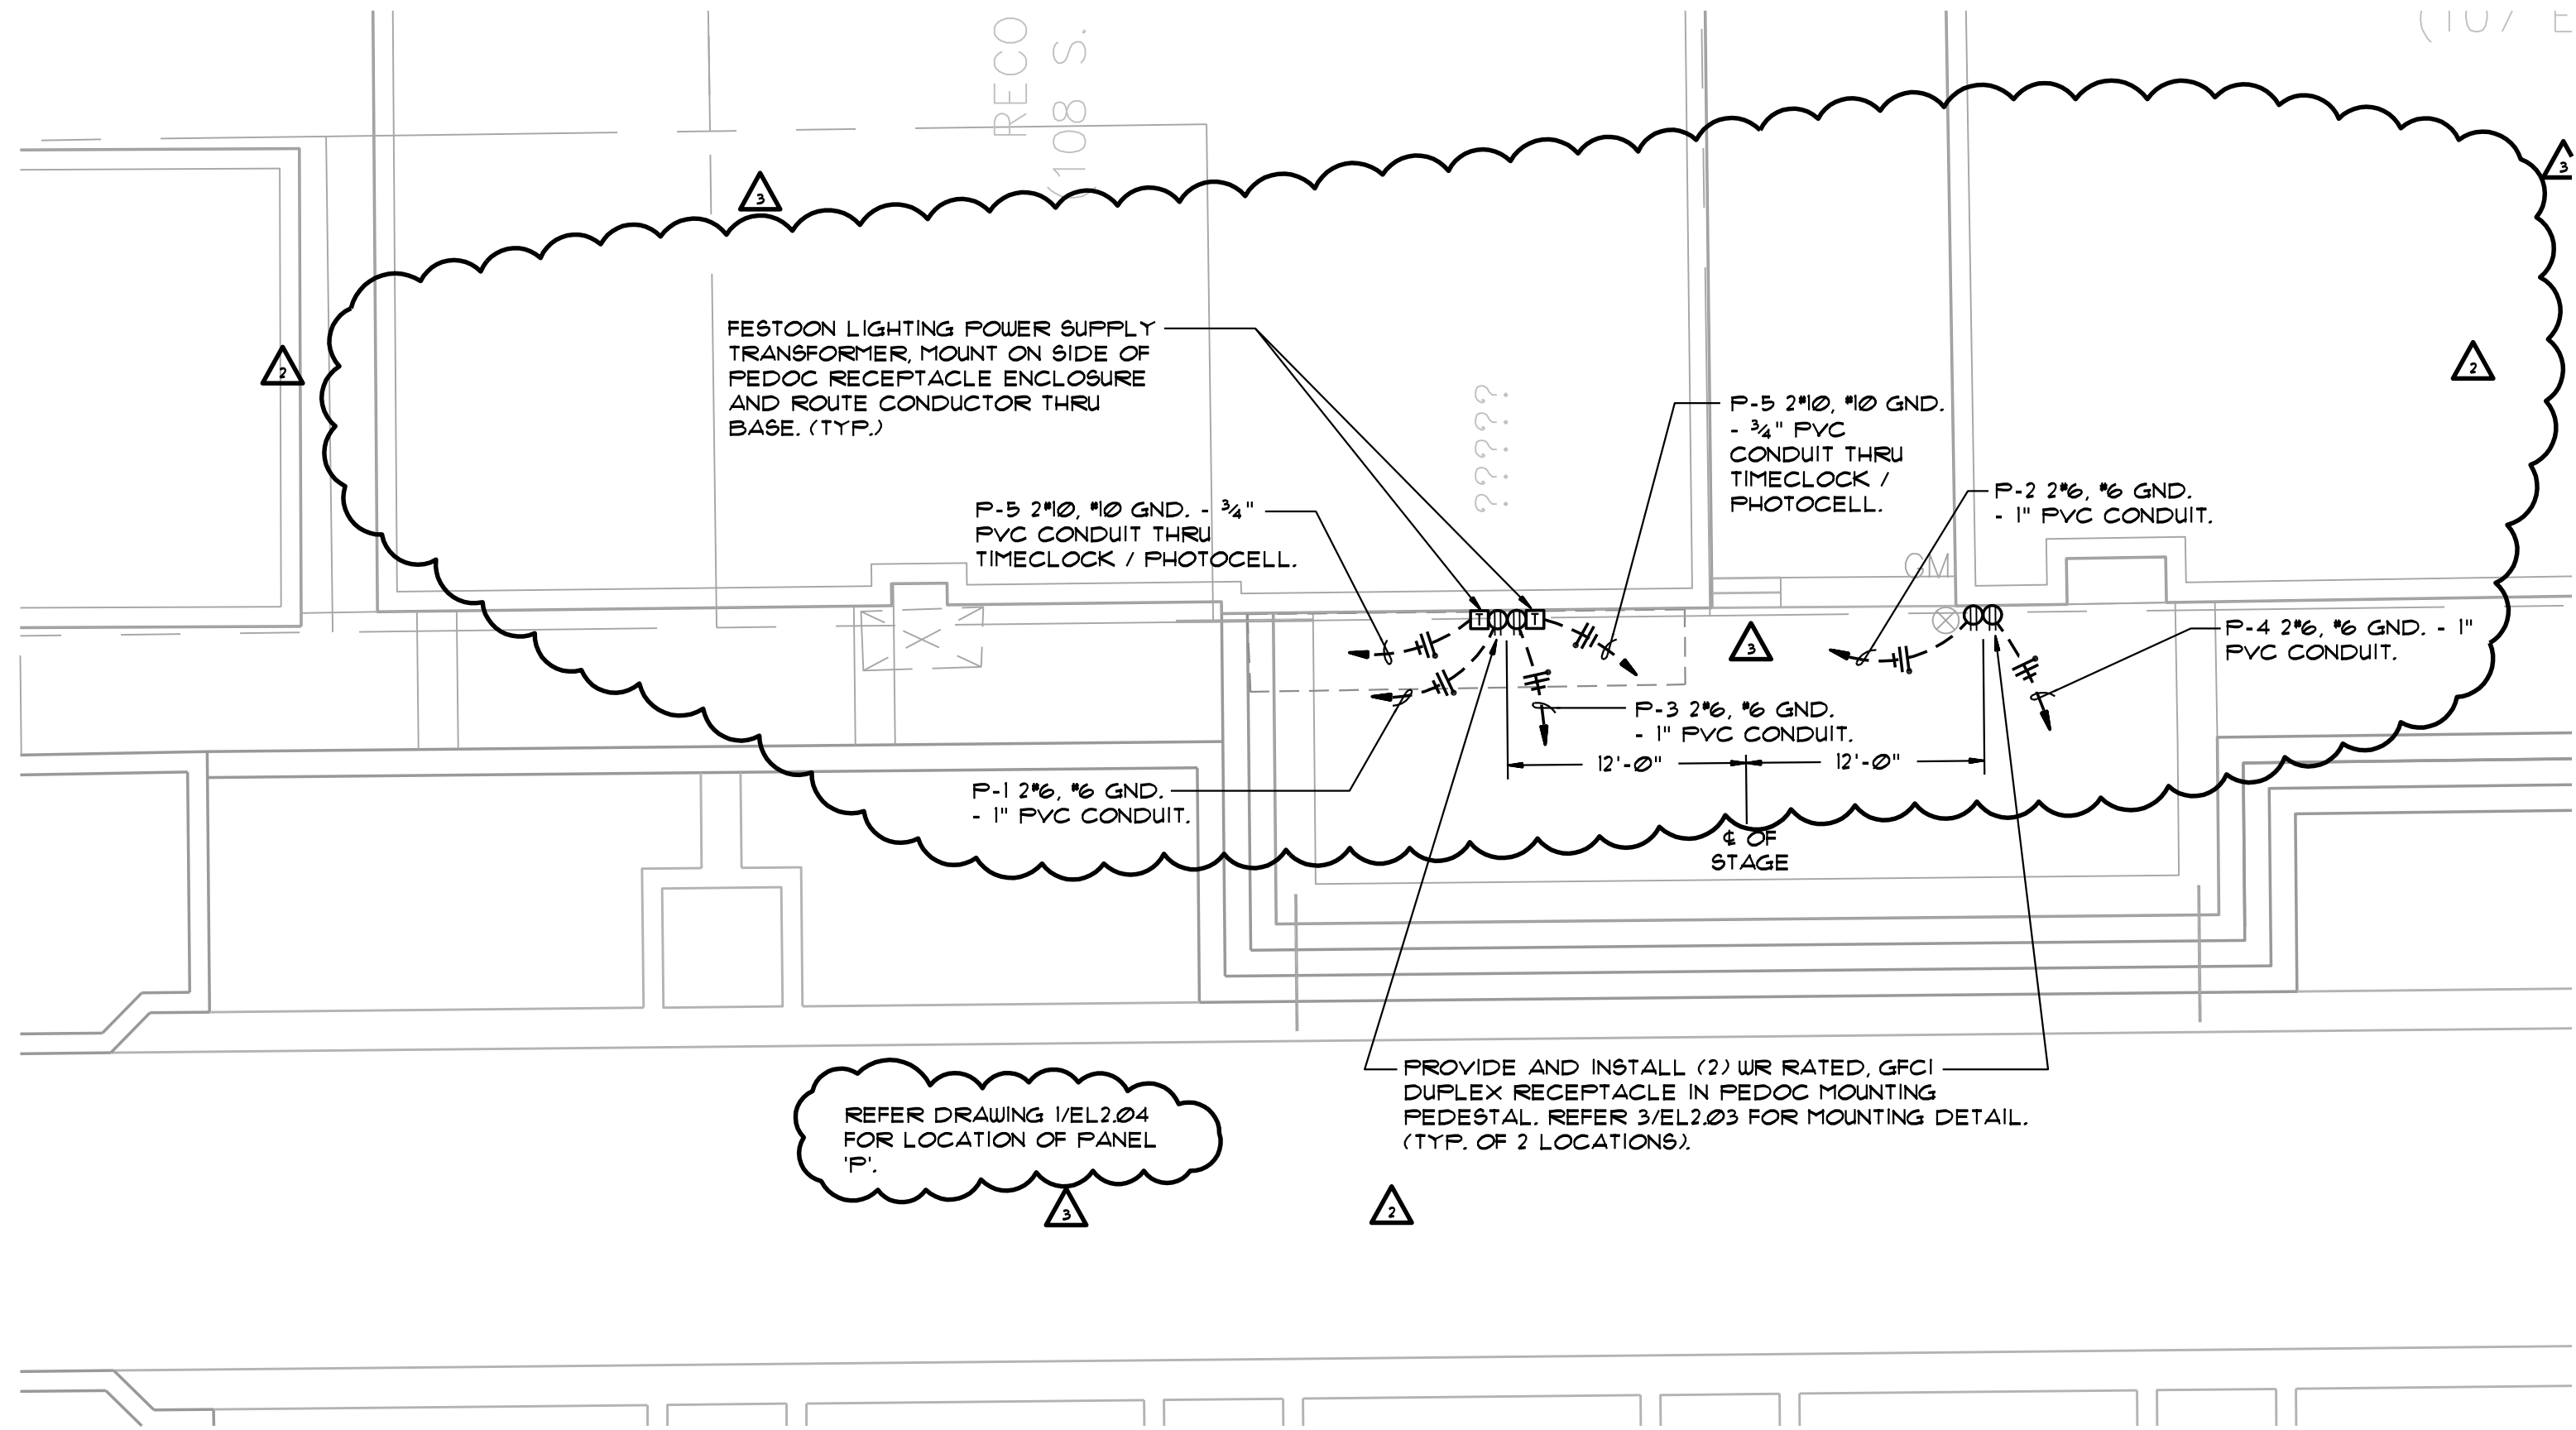

2 SAN JACINTO ST. PEDESTRIAN MALL PLAN - POWER - PHASE 2
SCALE: 1/8" = 1'-0"

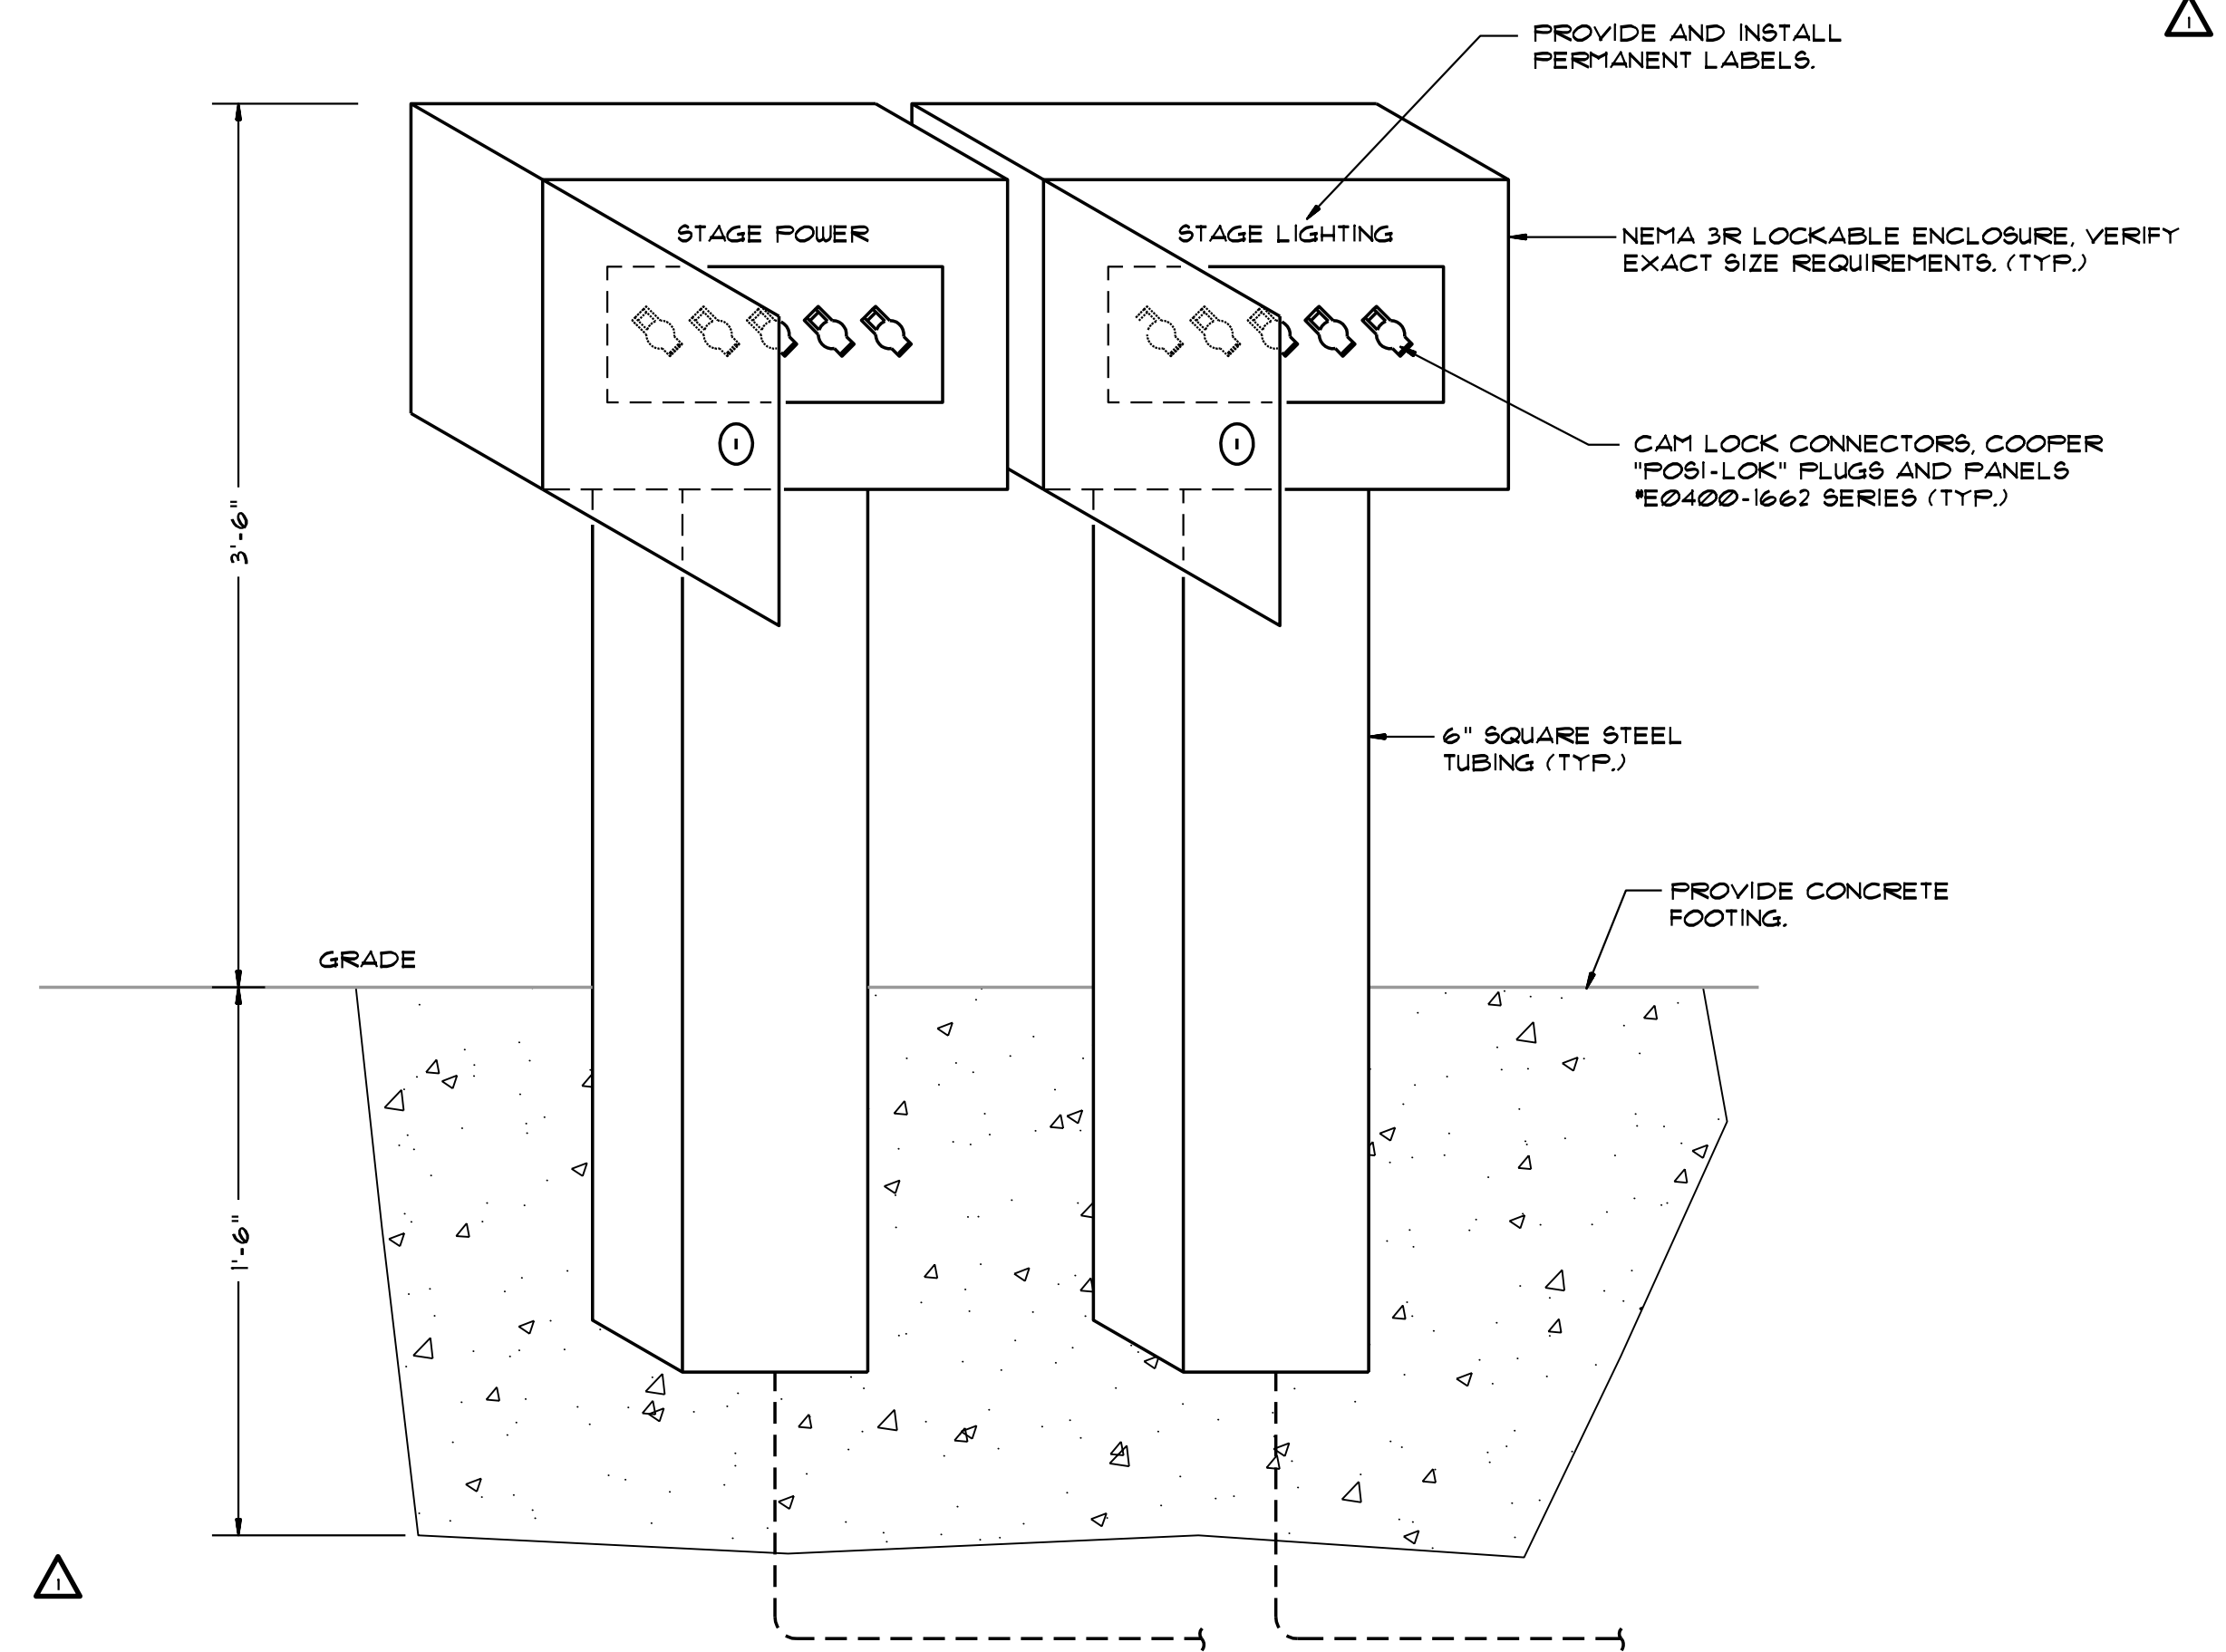

3 CAM LOCK ENCLOSURE DETAIL
SCALE: NONE

EA ENGINEERING ASSOCIATES
TX REG #F-4925
Ph: 940.427.8487 Fax: 940.427.8499
P.O. Box 167 Alford, TX 76225