


(108 E. WASHINGTON ST)

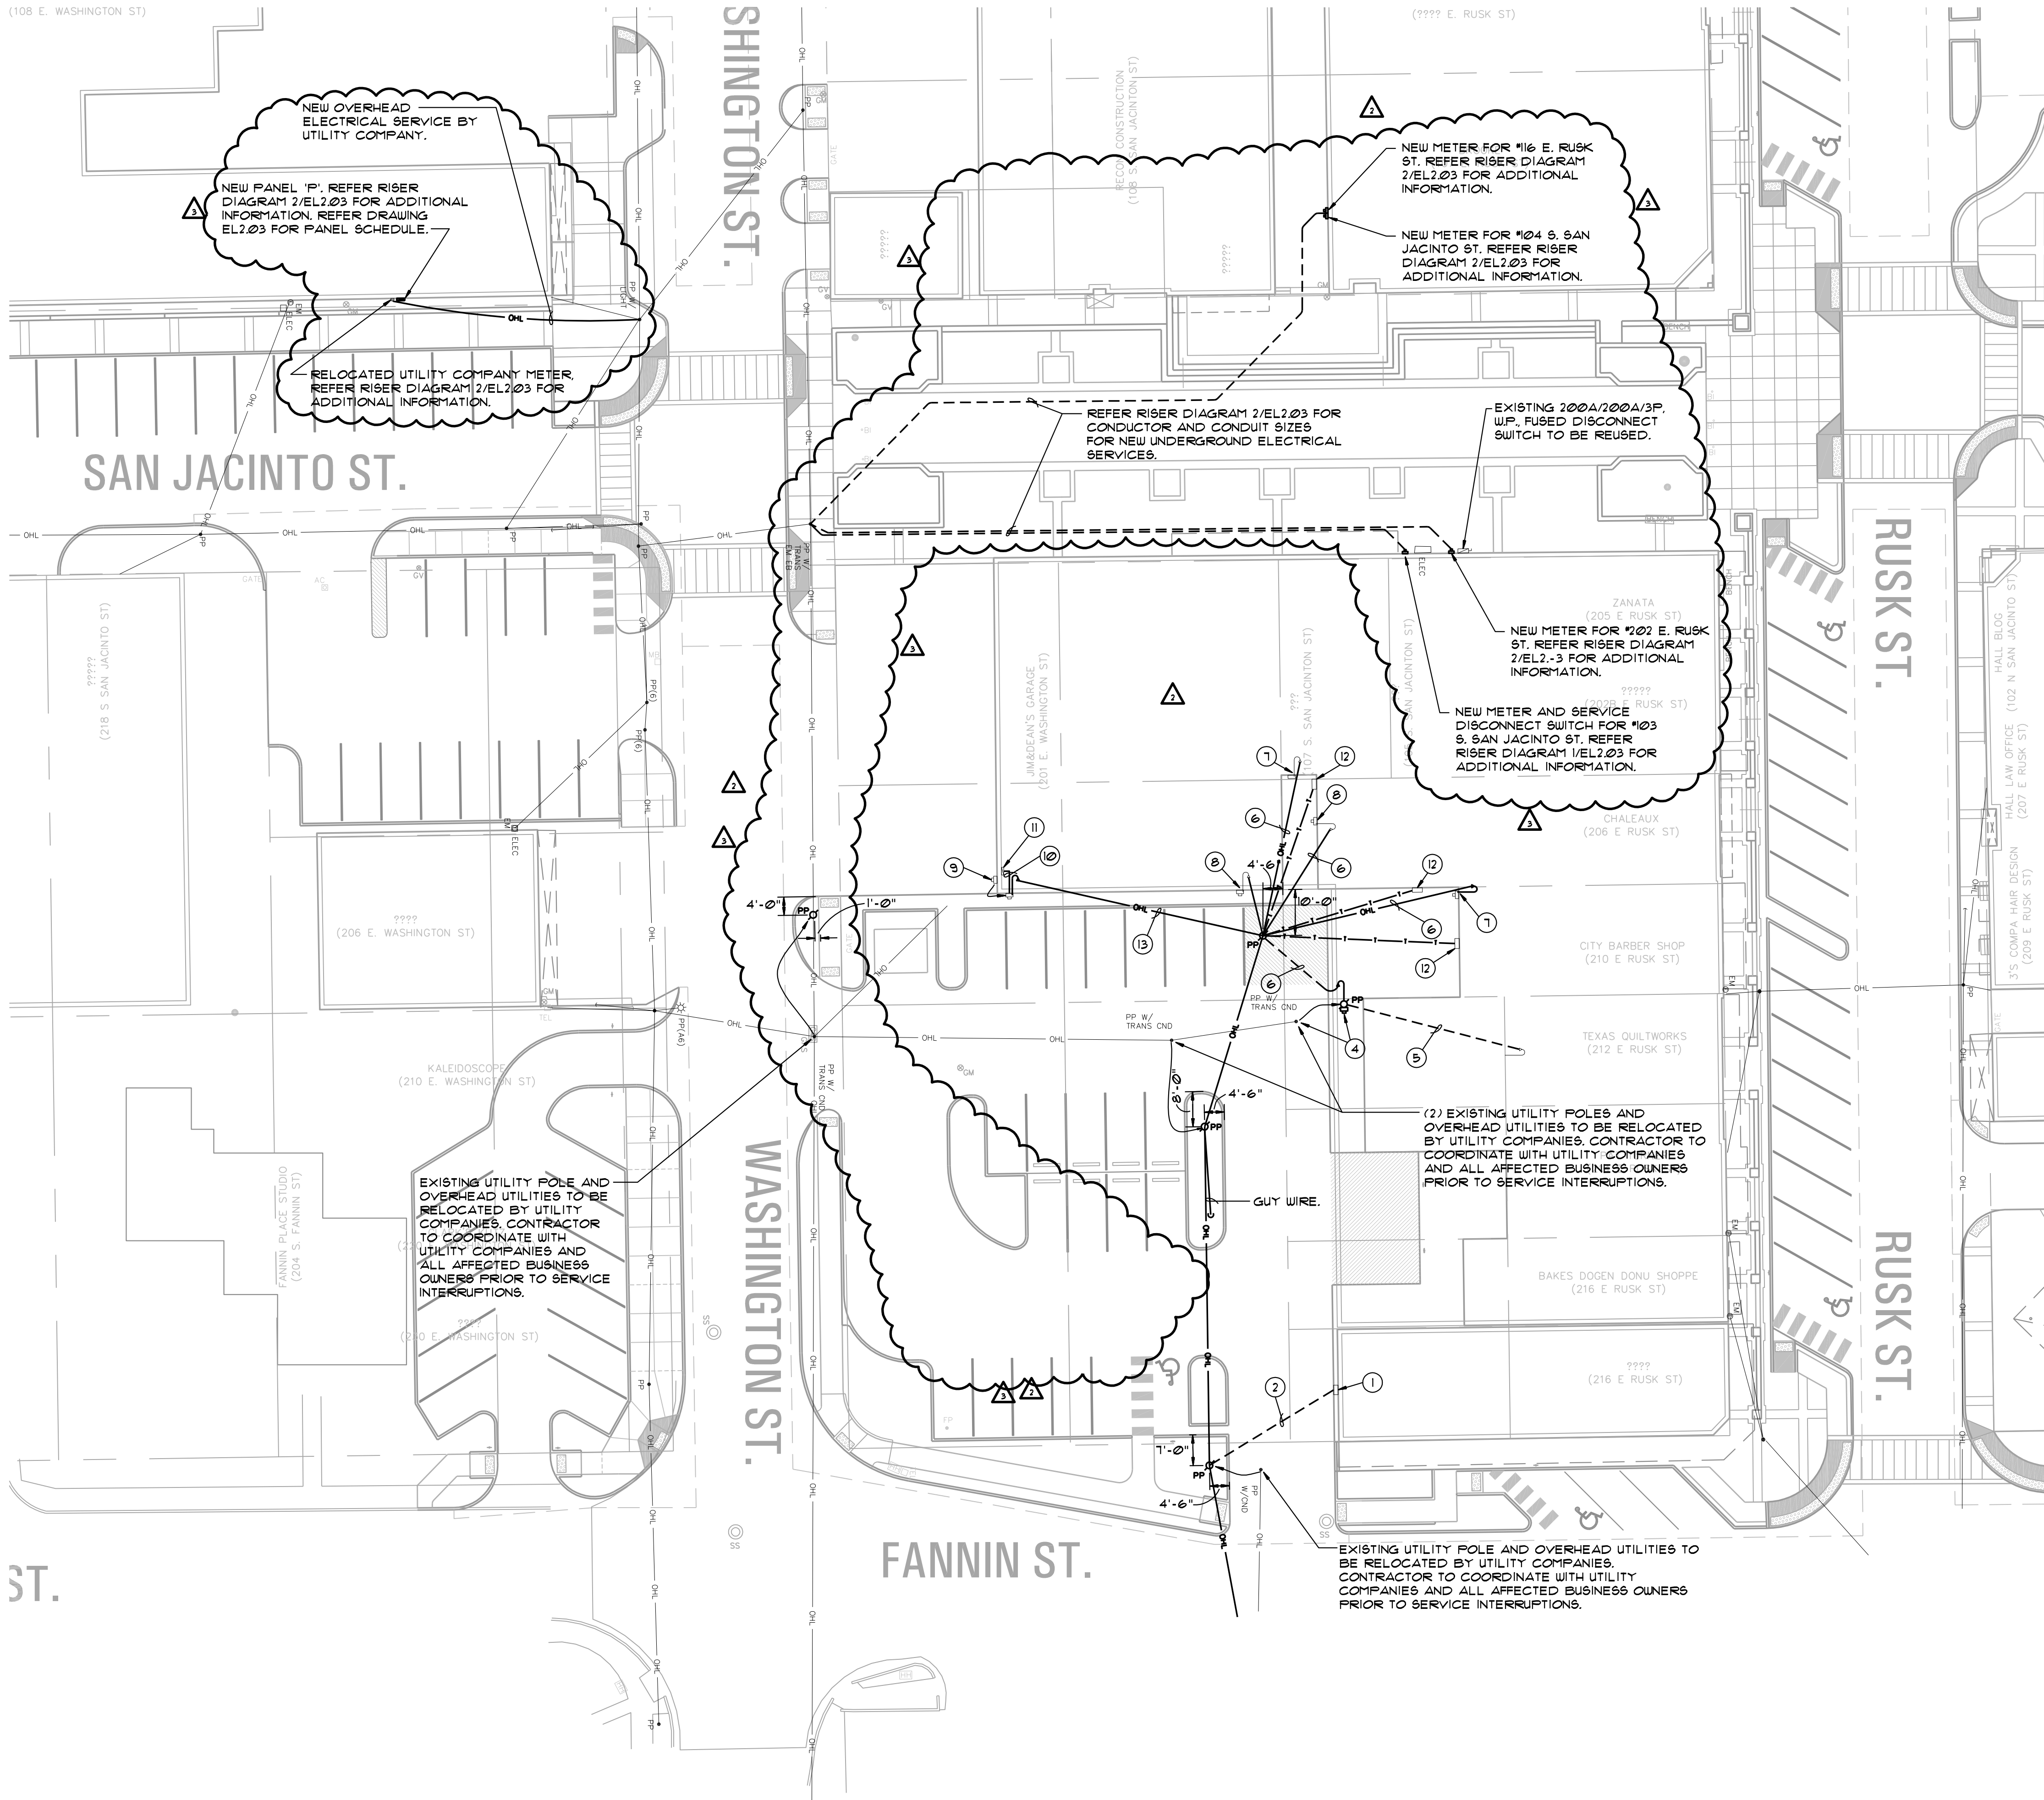


UTILITIES RELOCATION PLAN NOTES BY SYMBOL 'O'

- ① EXISTING SERVICE ENCLOSURE TO REMAIN.
- ② INSTALL NEW 4" PVC CONDUIT WITH MULE TAPE FROM EXISTING SERVICE ENCLOSURE TO NEW UTILITY POLE. RISE UP POLE 10'-0" PER ONCOR SPECIFICATIONS.
- ③ INSTALL NEW PRIVATE METER POLE TO MATCH EXISTING WOOD POLES.
- ④ RELOCATE TENANT METER AND WEATHERHEAD FROM EXISTING POLE INDICATED, TO NEW PRIVATE METER POLE AND RECONNECT TRIPLEX SERVICE CONDUCTORS.
- ⑤ EXISTING TRIPLEX SERVICE DROP, RECONNECT TO RELOCATED METER AND WEATHERHEAD ON TENANT METER POLE INDICATED.
- ⑥ EXISTING TRIPLEX SERVICE DROP TO BE RECONNECTED TO NEW UTILITY COMPANY SERVICE POLE BY ONCOR.
- ⑦ EXISTING 2" RGS CONDUIT SERVICE MAST AND WEATHERHEAD TO 4'-0" ABOVE ROOF LINE IF DIRECTED BY ONCOR.
- ⑧ EXISTING METER SERVICE MAST AND WEATHERHEAD TO REMAIN.
- ⑨ RELOCATE EXISTING METER AND SERVICE RISER TO SIDE OF BUILDING INDICATED. EXTEND SERVICE RISER PER ONCOR REQUIREMENTS.
- ⑩ INSTALL NEW FEEDER FROM RELOCATED METER TO EXISTING TENANT PANEL. 3/0 CU - 2" RGS CONDUIT.
- ⑪ EXISTING TENANT PANEL TO REMAIN.
- ⑫ TELEPHONE TERMINAL SERVICE BOX TO BE RECONNECTED TO NEW TELEPHONE SERVICE DROP BY TELEPHONE COMPANY. COORDINATE WORK WITH TELEPHONE COMPANY.
- ⑬ NEW TRIPLEX SERVICE DROP BY ONCOR. COORDINATE WORK WITH ONCOR.

UTILITY CONTACTS	
Oncor Electric Delivery	AT&T Telephone
Mr. Phil Dickerson (972) 551-6712	Mr. Brian Duncan (972) 451-2303

no.	date	detail
△	4/2/14	Electrical Revisions
△	5/21/14	Electrical Revisions
△	7/24/14	Electrical Revisions

la terra studio, inc.
12024
Its project number
02.26.2014
date
C.A.D.
drawn by
J.W.
checked by

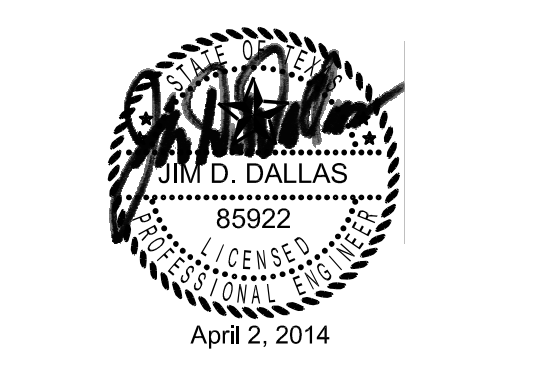

sheet title
Utility Relocation
Plan - Electrical
sheet number

EL2.04

△ ENTIRE NEW DRAWING

EA ENGINEERING ASSOCIATES
TX REG #F-4925
Ph: 940.427.8487 Fax: 940.427.8499
P.O. Box 167 Alford, TX 76225