



submittals / revisions

no.	date	detail
Δ	5/8/2014	Electrical Revisions



la terra studio, inc.

12024	its project number
02.26.2014	date
C.A.D.	drawn by
J.W.	checked by
	registration



sheet title
Area 5 - Electrical Demo. Phase 2
sheet number

ED1.05

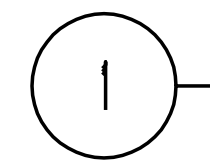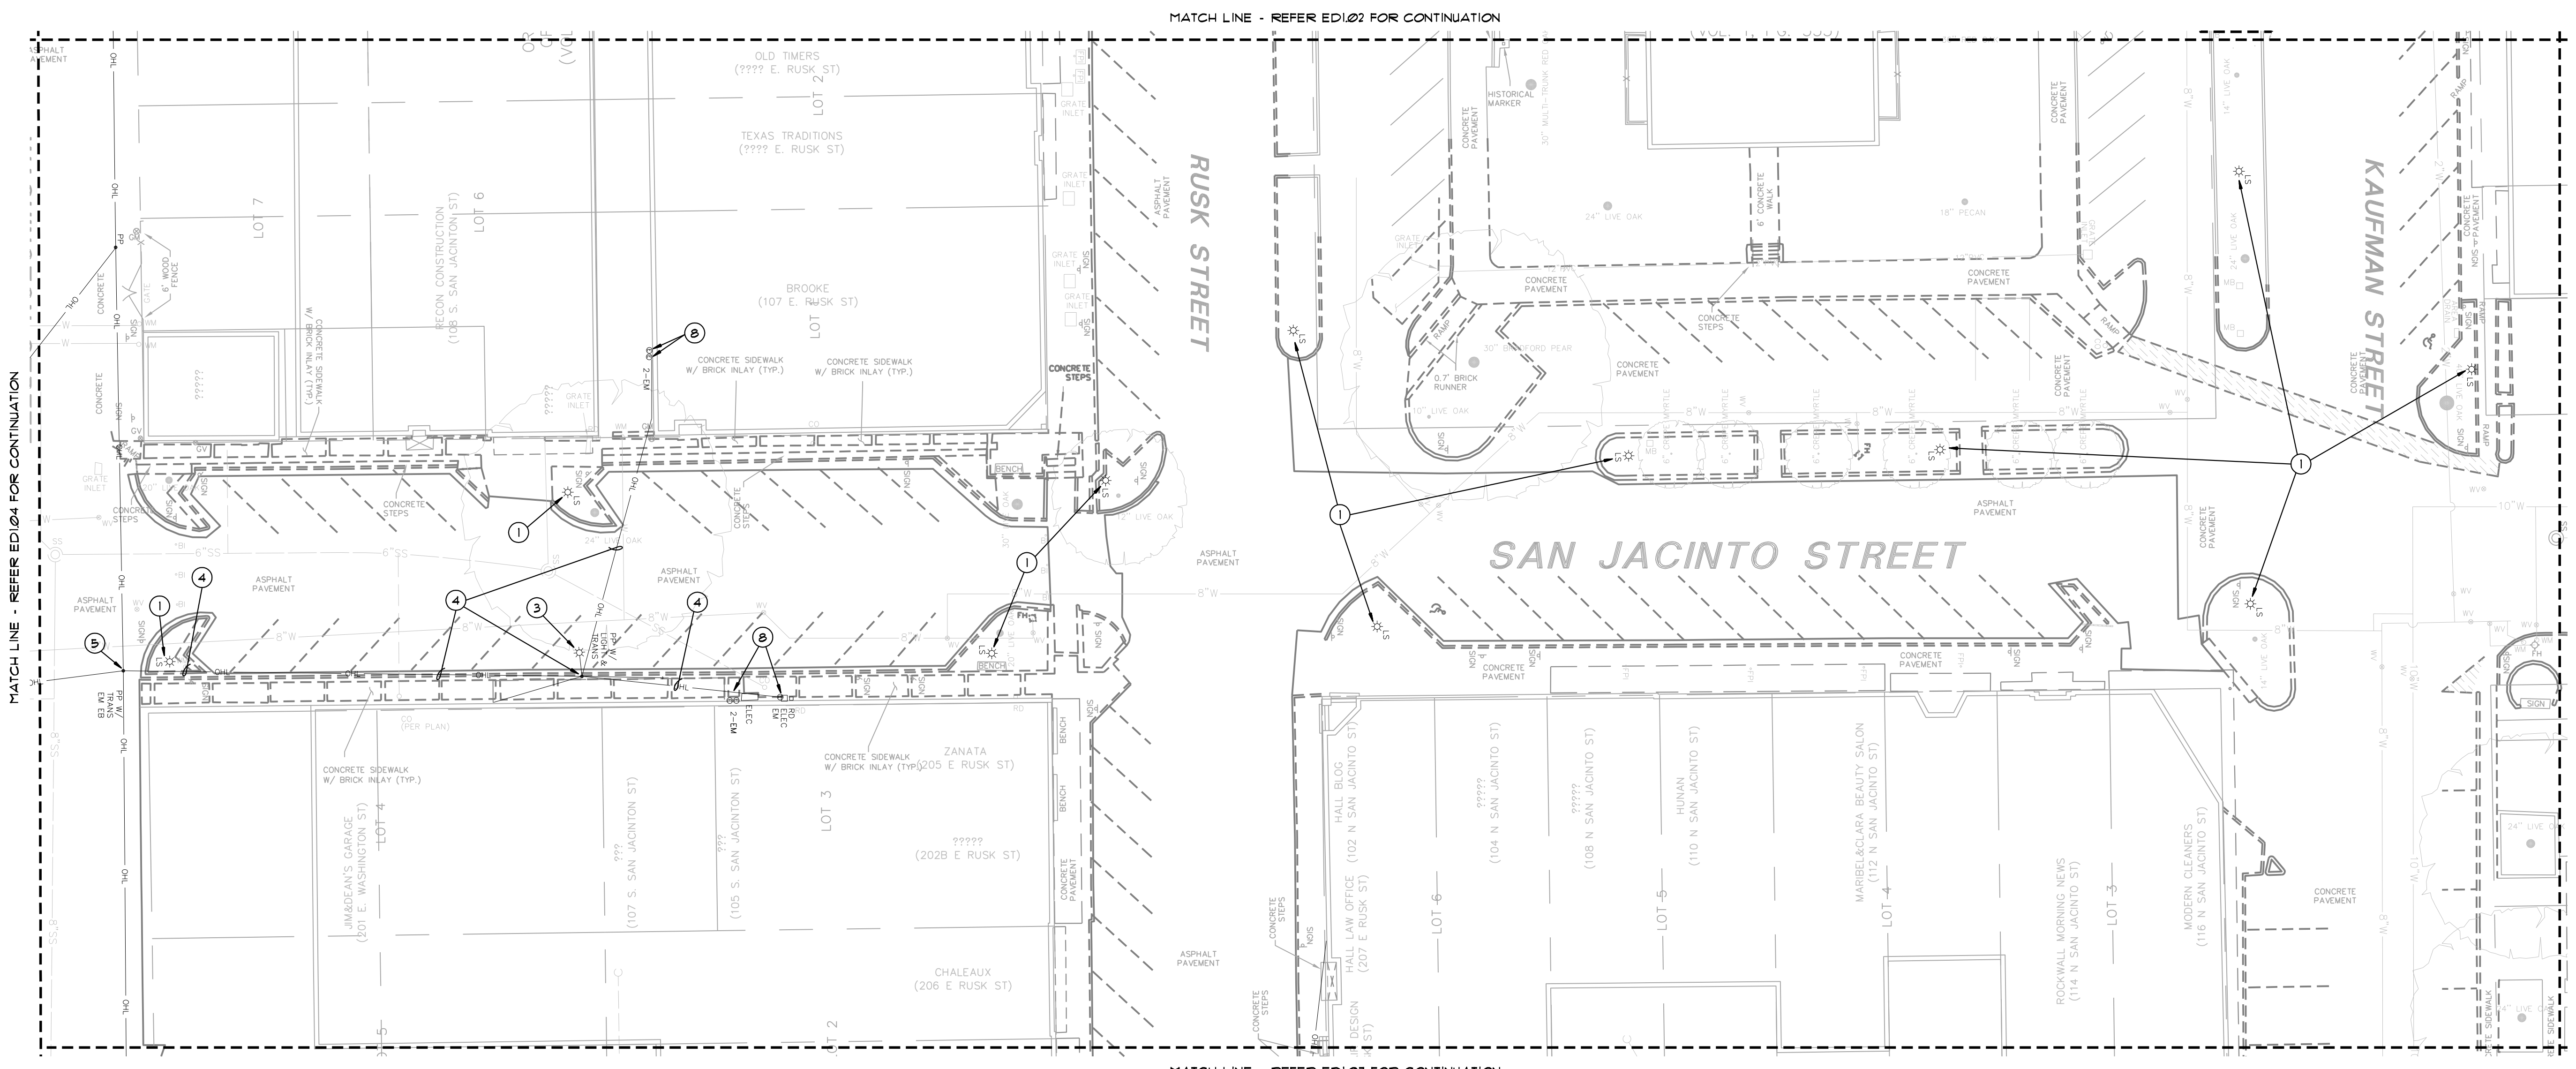

AREA 5 - ELECTRICAL DEMOLITION PLAN - PHASE 2

SCALE: 1" = 20' - 0"

**DEMOLITION PLAN
NOTES BY SYMBOL 'O'**

NOTE: NOT ALL NUMBERS APPEAR ON ALL DRAWINGS.

- ① EXISTING PEDESTRIAN STREET LIGHT TO BE REMOVED. REMOVE EXISTING ANCHOR BOLTS TO 6" BELOW GRADE ELEVATION. PATCH CONCRETE TO MATCH SIDEWALK WHERE APPLICABLE.
- ② EXISTING LIGHT TO REMAIN.
- ③ EXISTING 'COBRA HEAD' LIGHT ON POWER POLE TO BE REMOVED. CITY IS TO COORDINATE WITH ONCOR FOR REMOVAL.
- ④ EXISTING OVERHEAD UTILITY SERVICES TO BE REMOVED BY UTILITY COMPANIES.
- Δ ⑤ EXISTING METER, LOAD CENTER AND PHOTOCELL TO BE REMOVED FROM EXISTING UTILITY POLE. EXISTING METER TO BE RELOCATED. REFER DRAWING 2/EL2.01 FOR NEW LOCATION.
- ⑥ EXISTING UTILITY POLE AND OVERHEAD UTILITIES TO BE RELOCATED BY UTILITY COMPANIES. CONTRACTOR TO COORDINATE WITH UTILITY COMPANIES AND ALL AFFECTED BUSINESS OWNERS PRIOR TO SERVICE INTERRUPTIONS.
- ① EXISTING PEDESTRIAN STREET LIGHT TO BE REMOVED. REMOVE EXISTING ANCHOR BOLTS TO 6" BELOW GRADE. EXTEND EXISTING BRANCH CIRCUIT WIRING TO NEW TYPE '91' LIGHT POLE SHOWN ON DRAWING EL1.02 AND CONNECT.
- ⑧ EXISTING TENANT ELECTRICAL SERVICE METERS TO REMAIN. REFER TO DRAWING 2/EL2.03 FOR ADDITIONAL INFORMATION.



ENGINEERING ASSOCIATES
TX REG #F-4925
Ph: 940.427.8487 Fax: 940.427.8499
P.O. Box 167 Alford, TX 76225