




© 2013 la terra studio, inc. All Rights Reserved FILE: P:\12024-Downtown Rockwall PS&E - Rockwall\CAD\Sheet\12024-Strs Details\_4.dwg

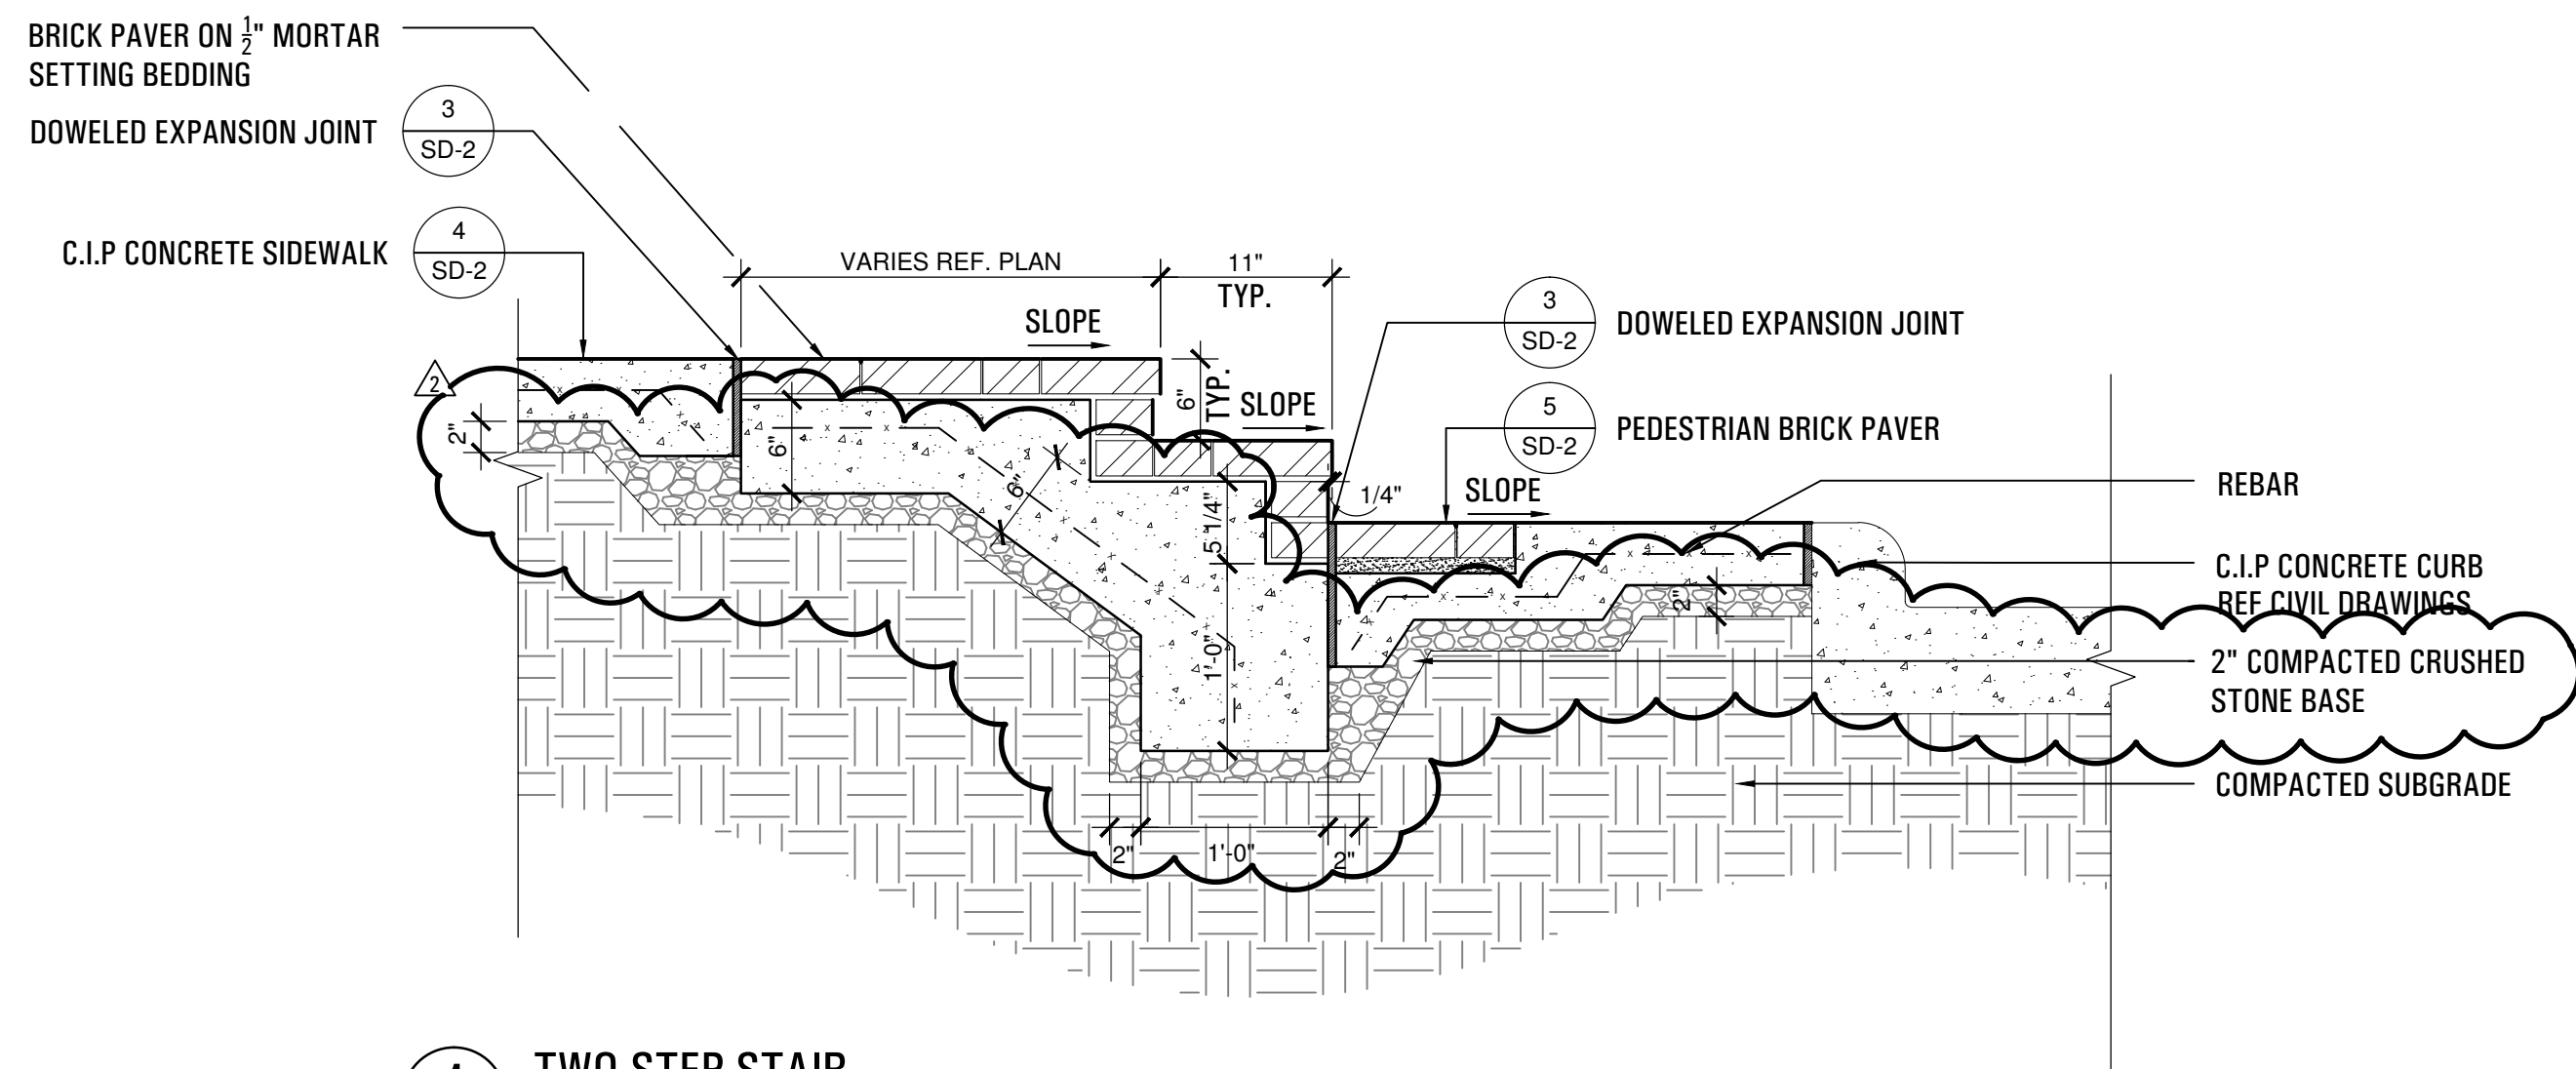


**1 TWO STEP STAIR**  
SCALE: 1" = 1'-0"

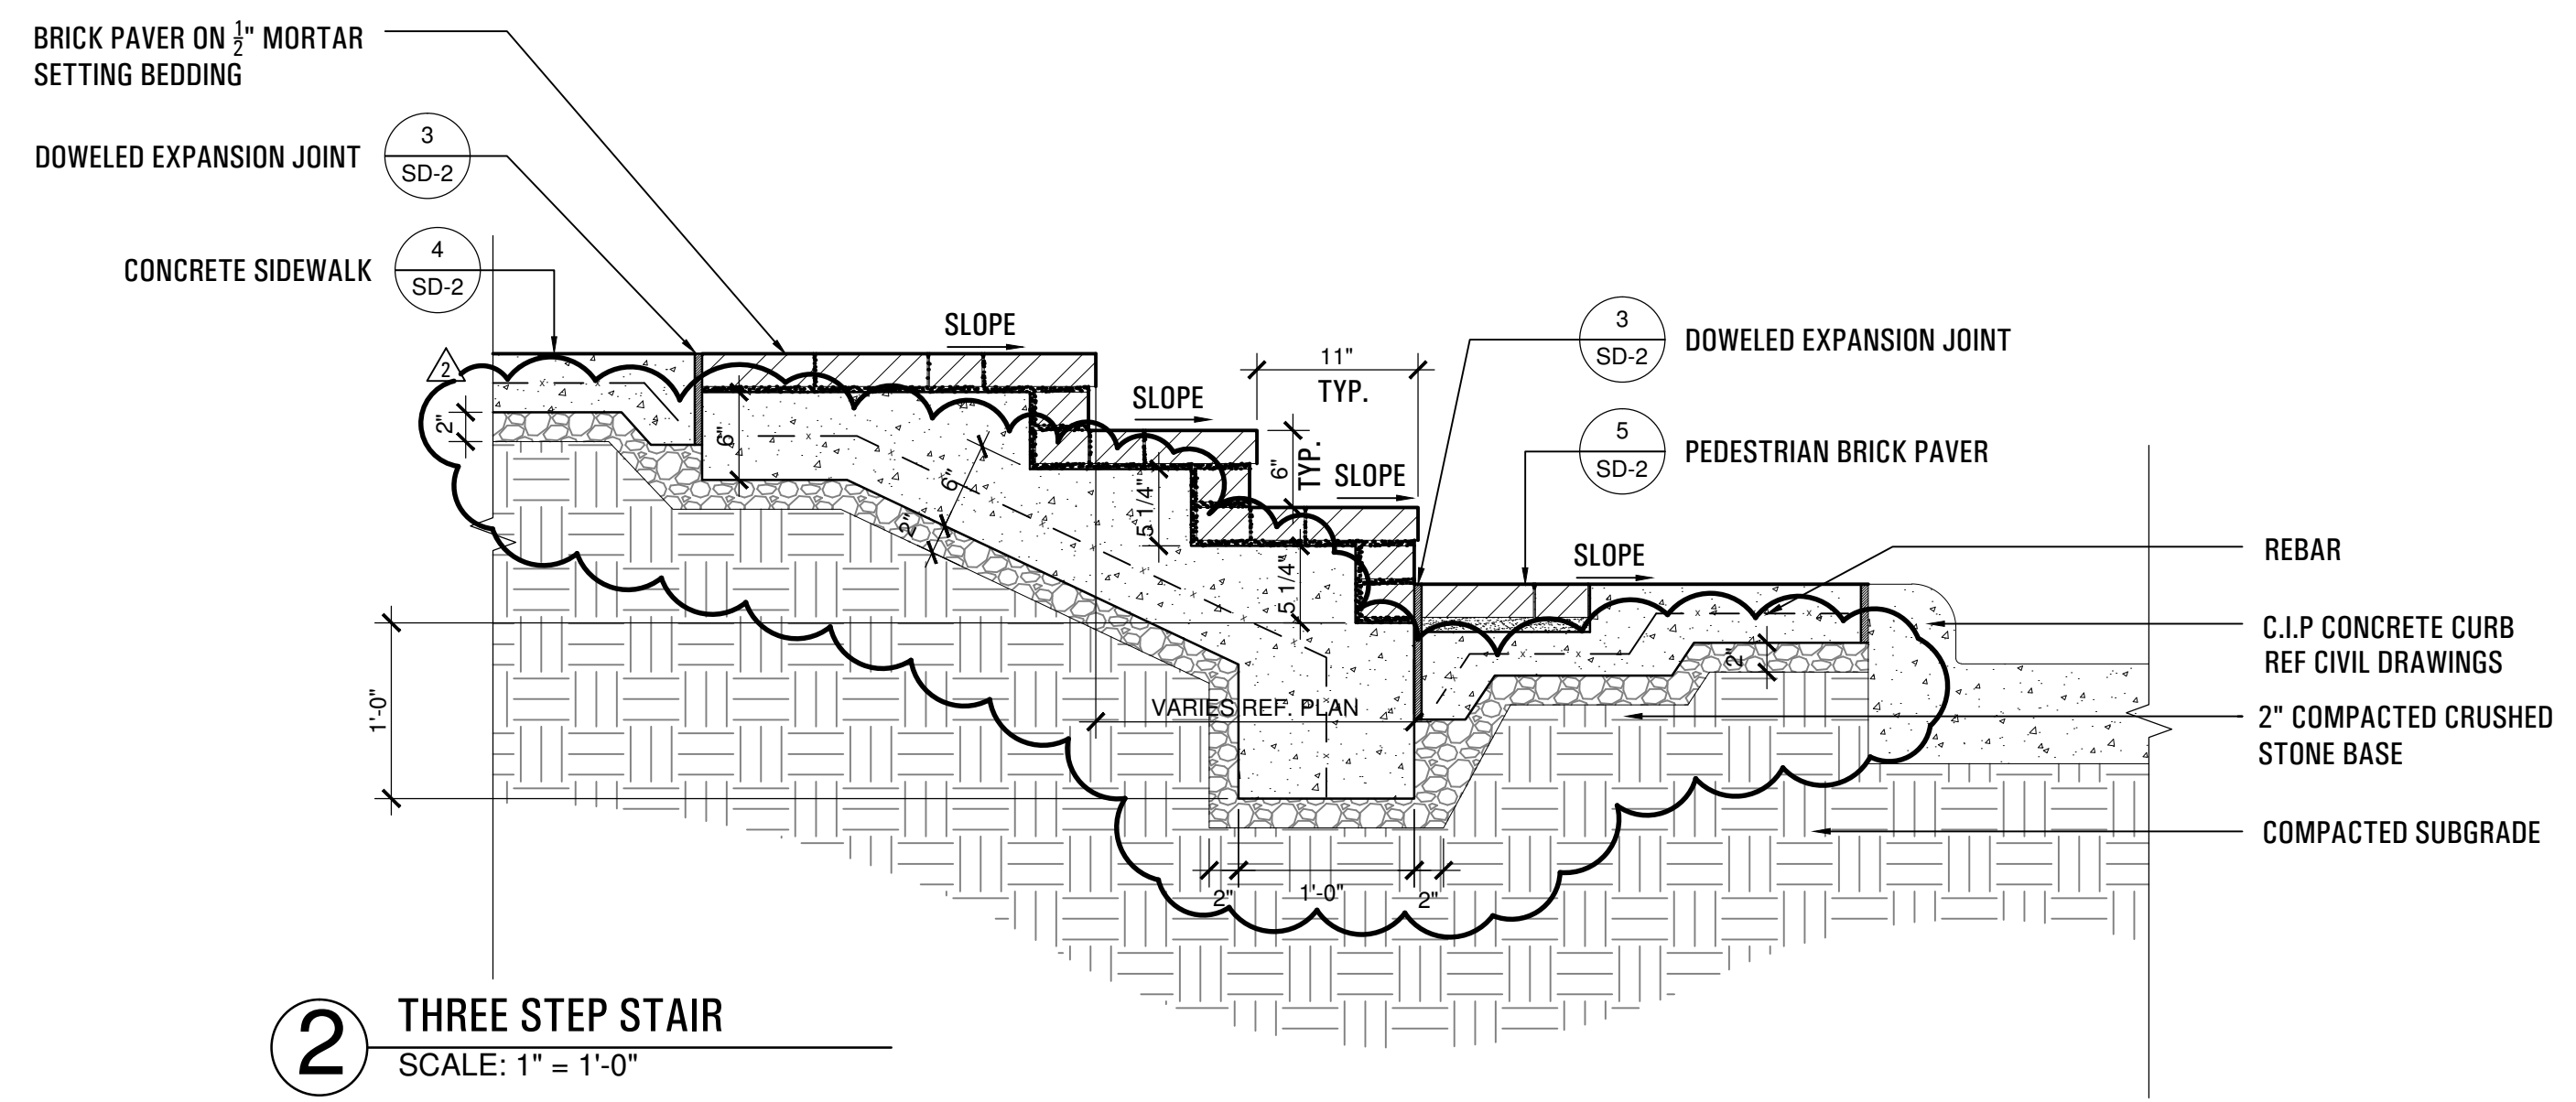


**2 THREE STEP STAIR**  
SCALE: 1" = 1'-0"

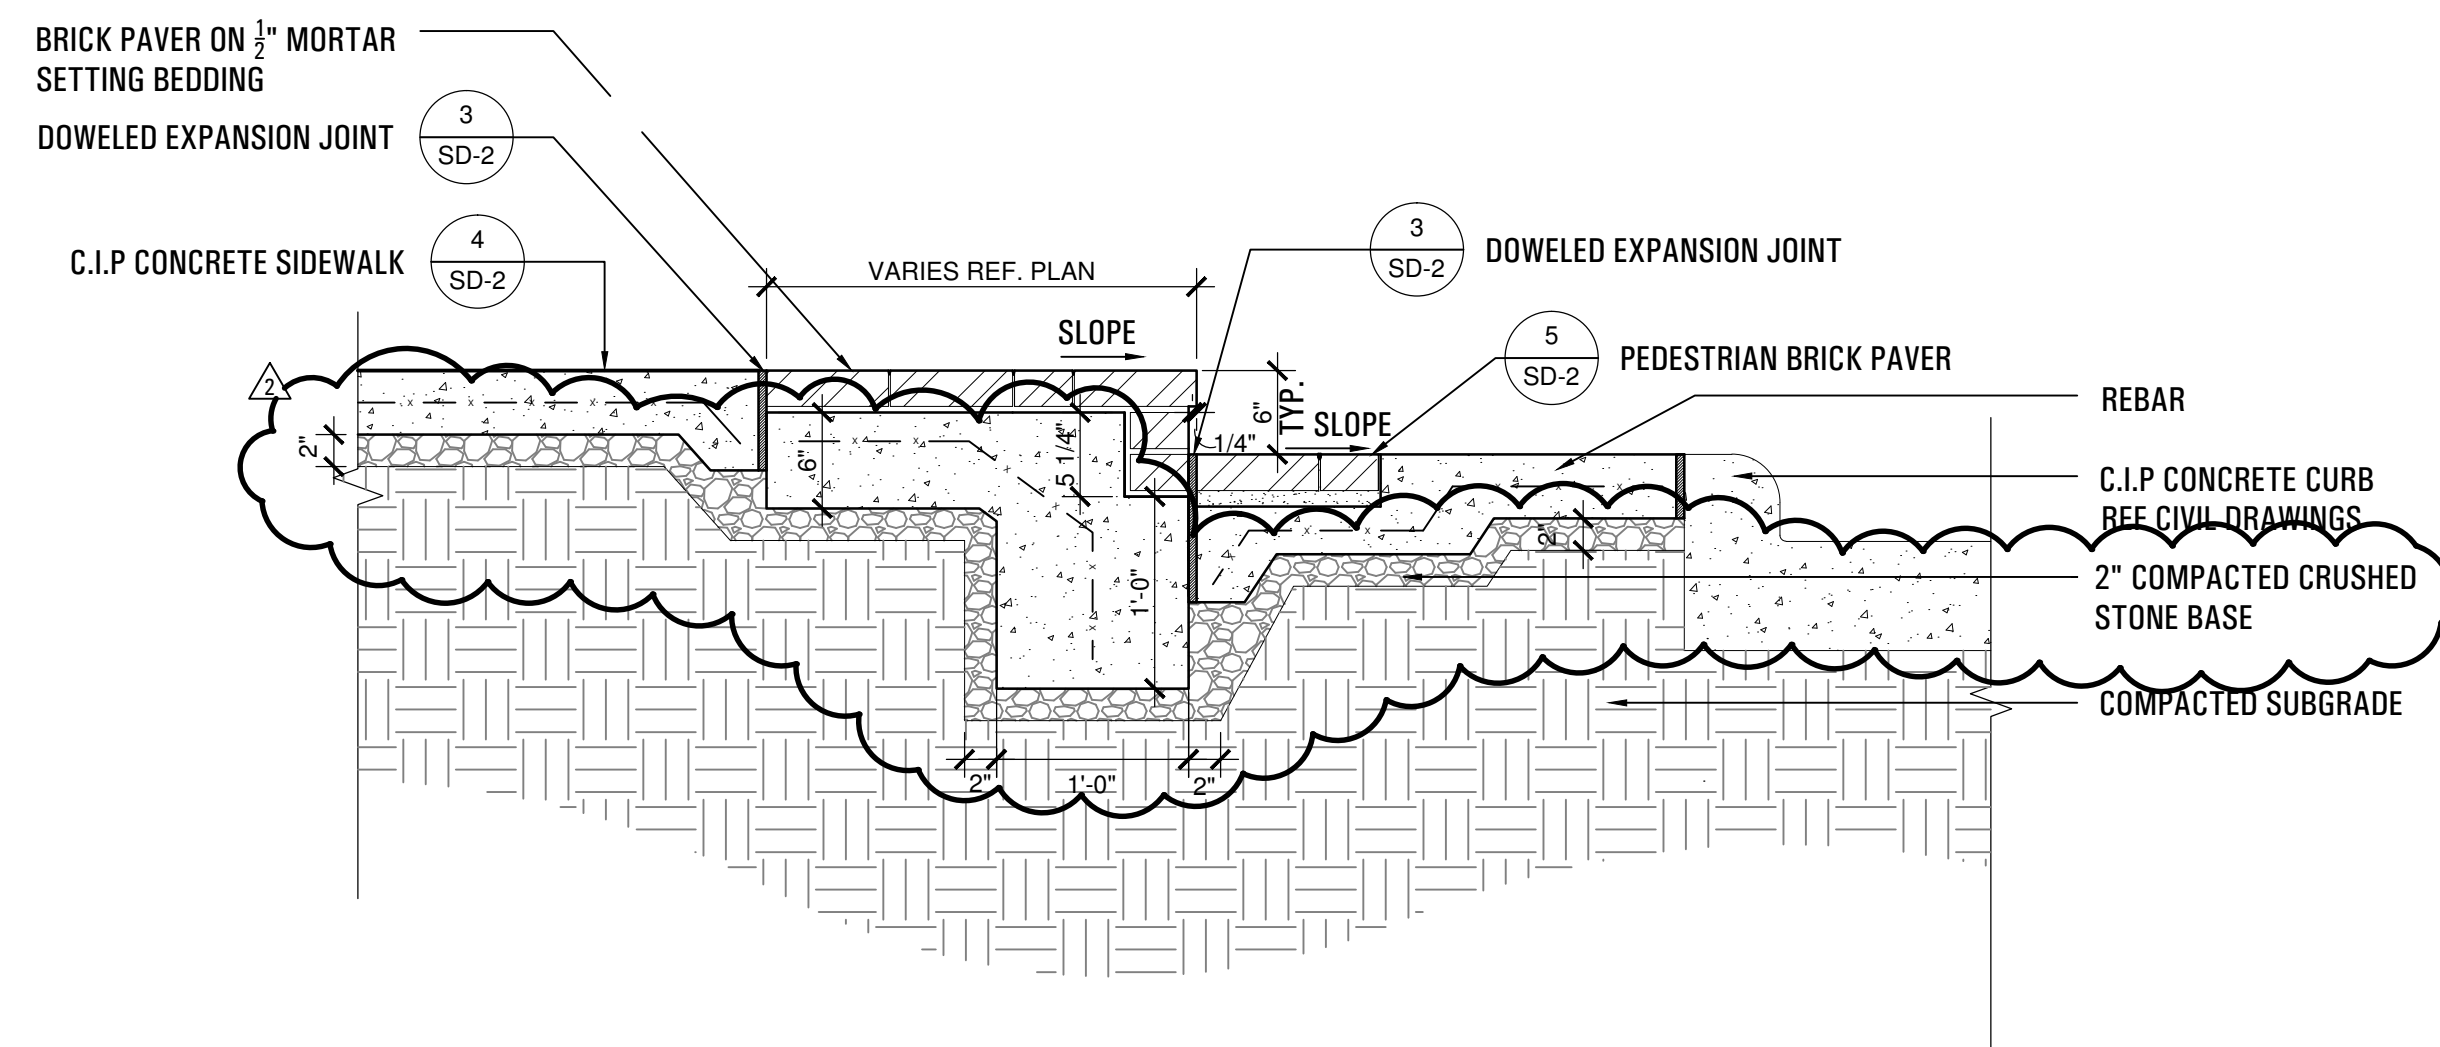


**3 ONE STEP STAIR**  
SCALE: 1" = 1'-0"

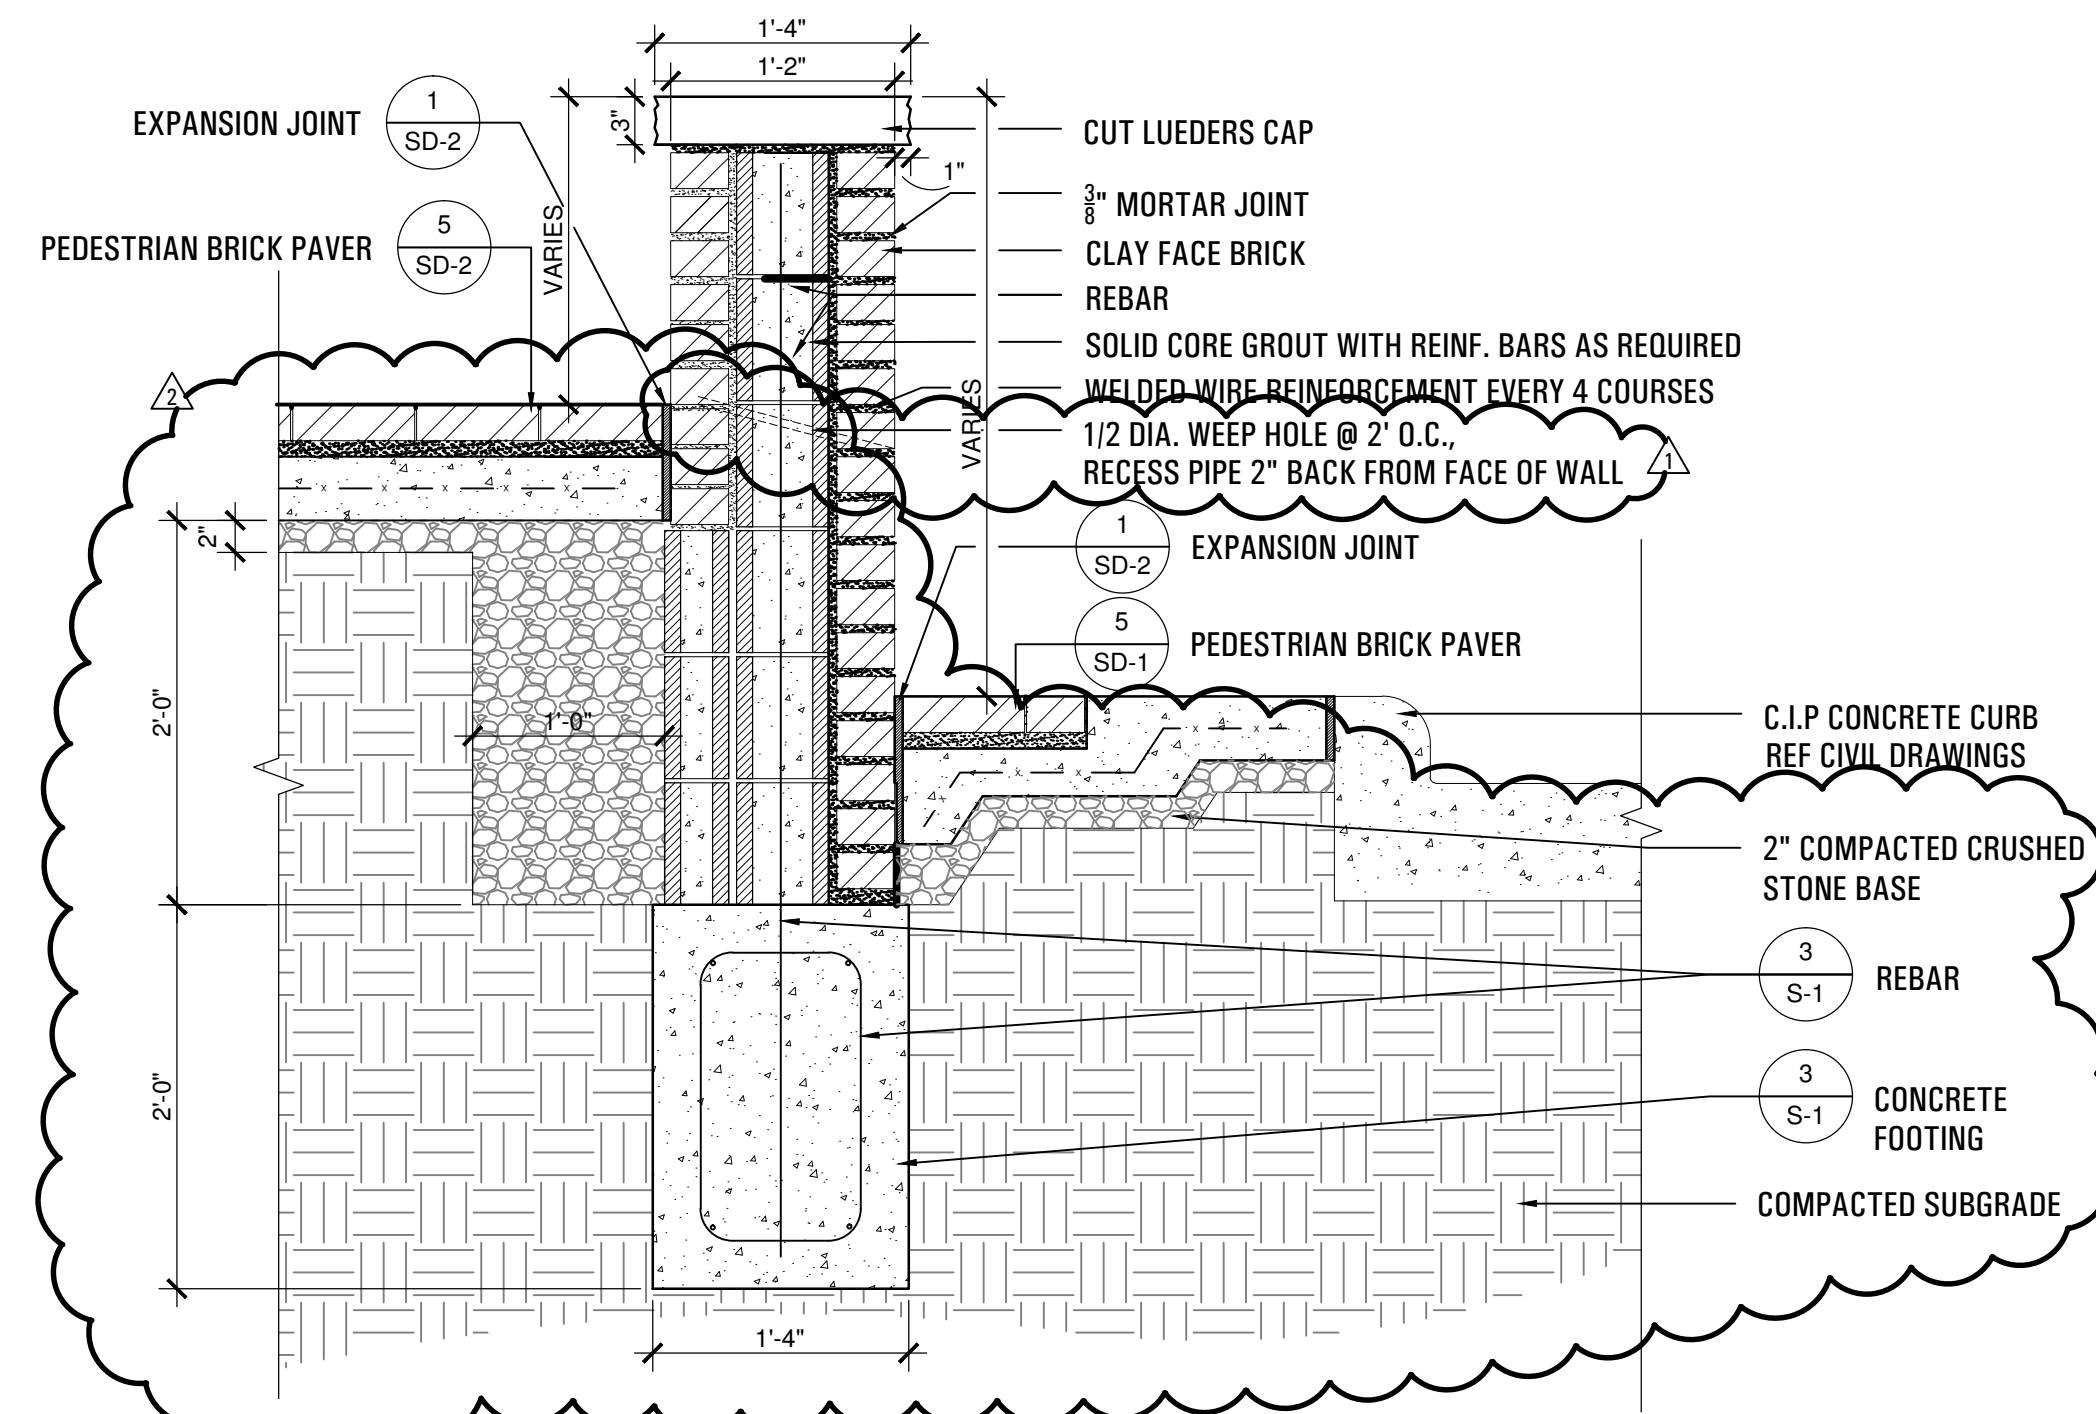


**4 BRICK VENEER WALL**  
SCALE: 1" = 1'-0"

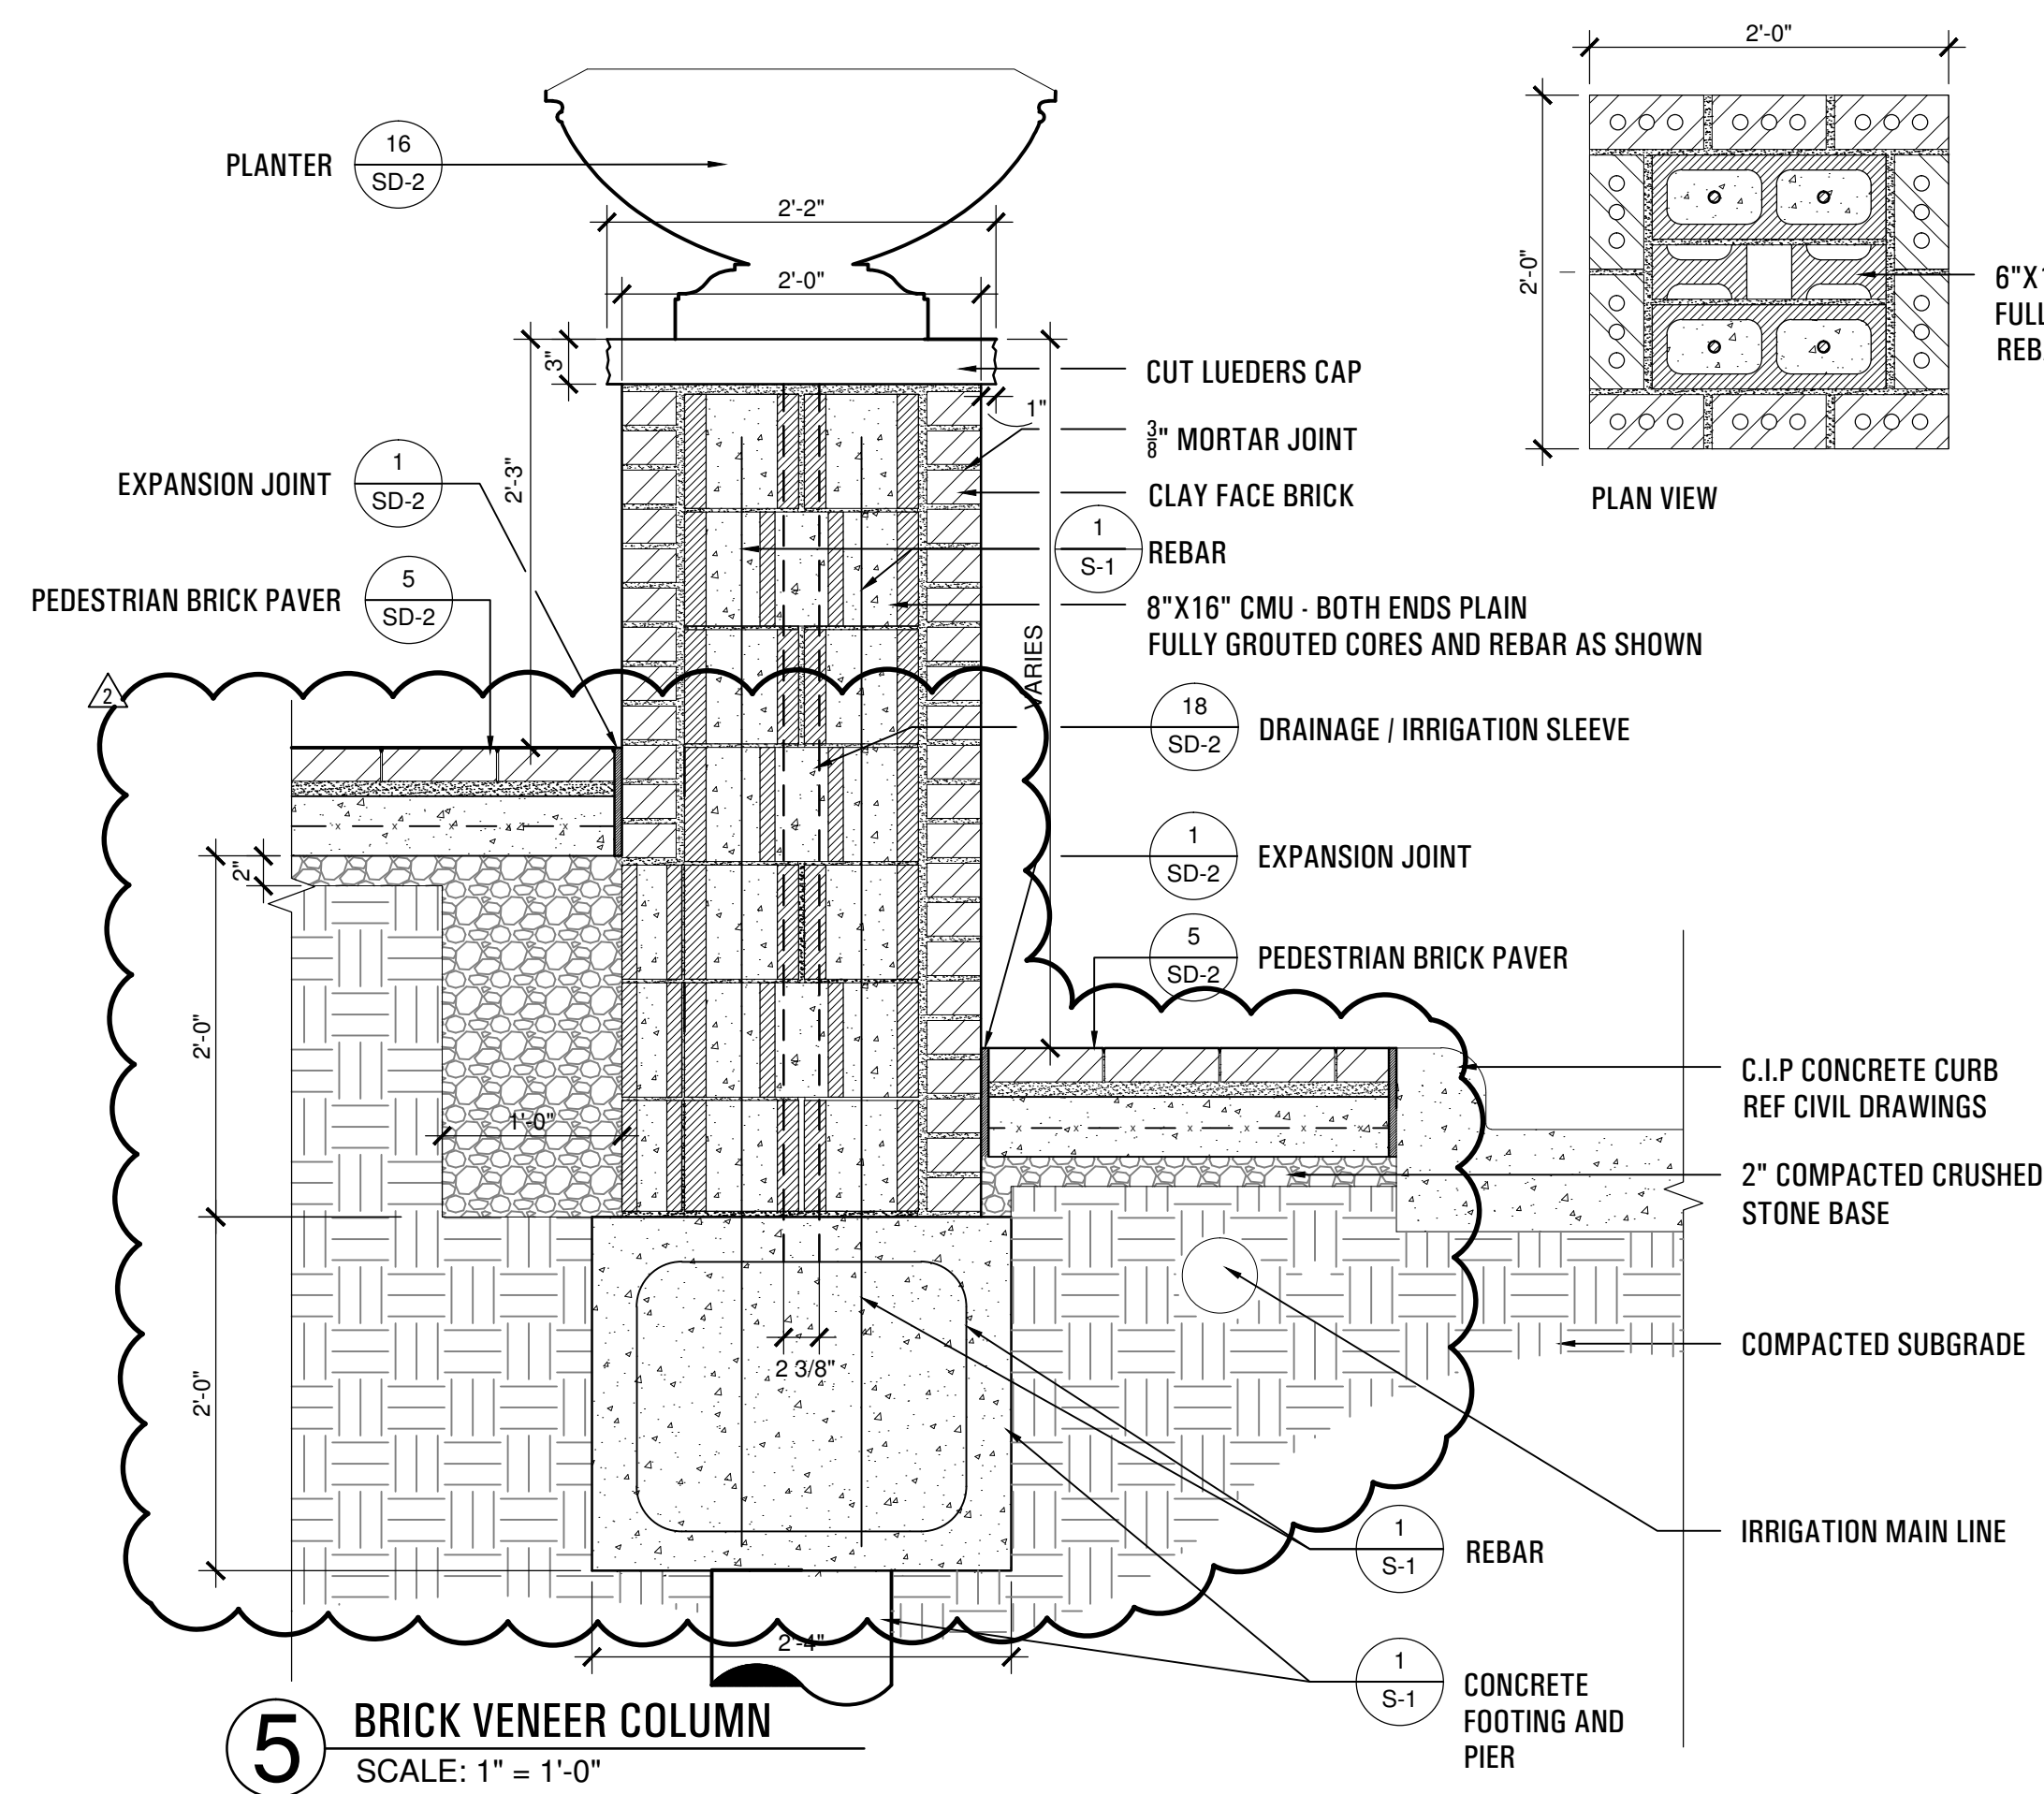


**5 BRICK VENEER COLUMN**  
SCALE: 1" = 1'-0"

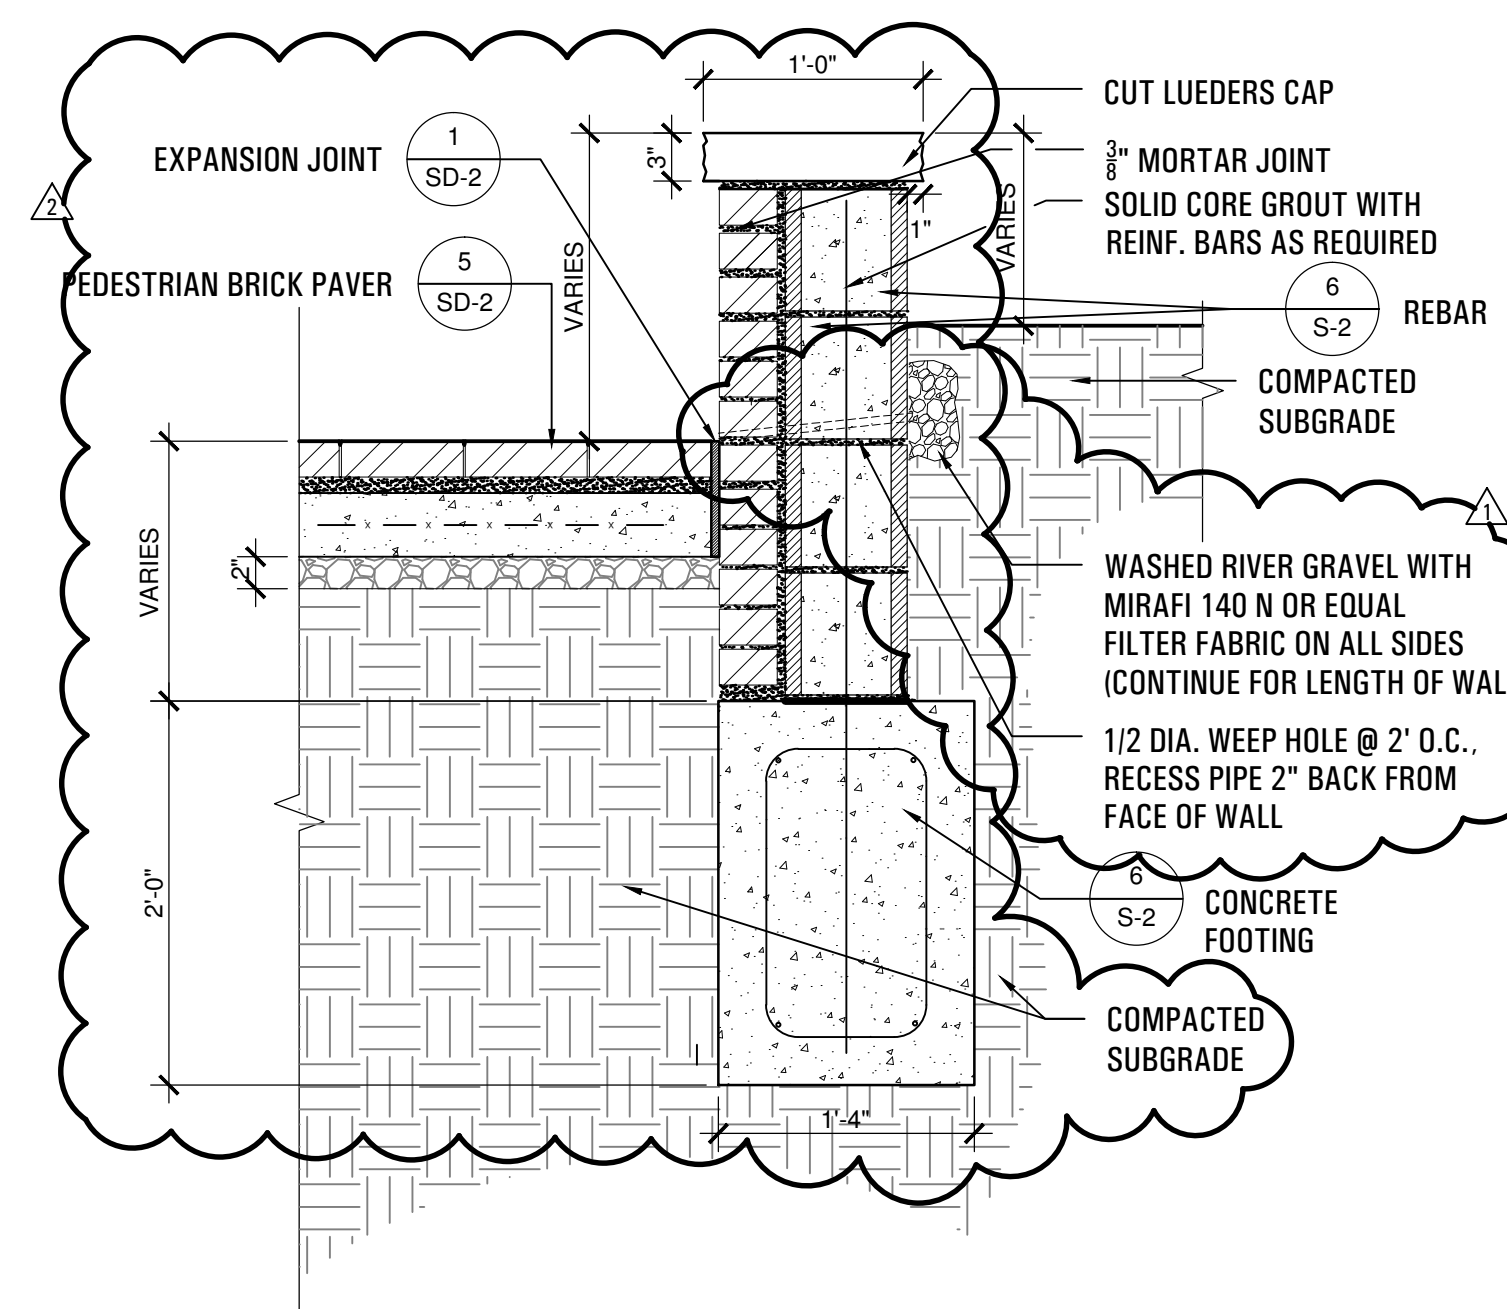

**6 BRICK VENEER PLANTER WALL**  
SCALE: 1" = 1'-0"

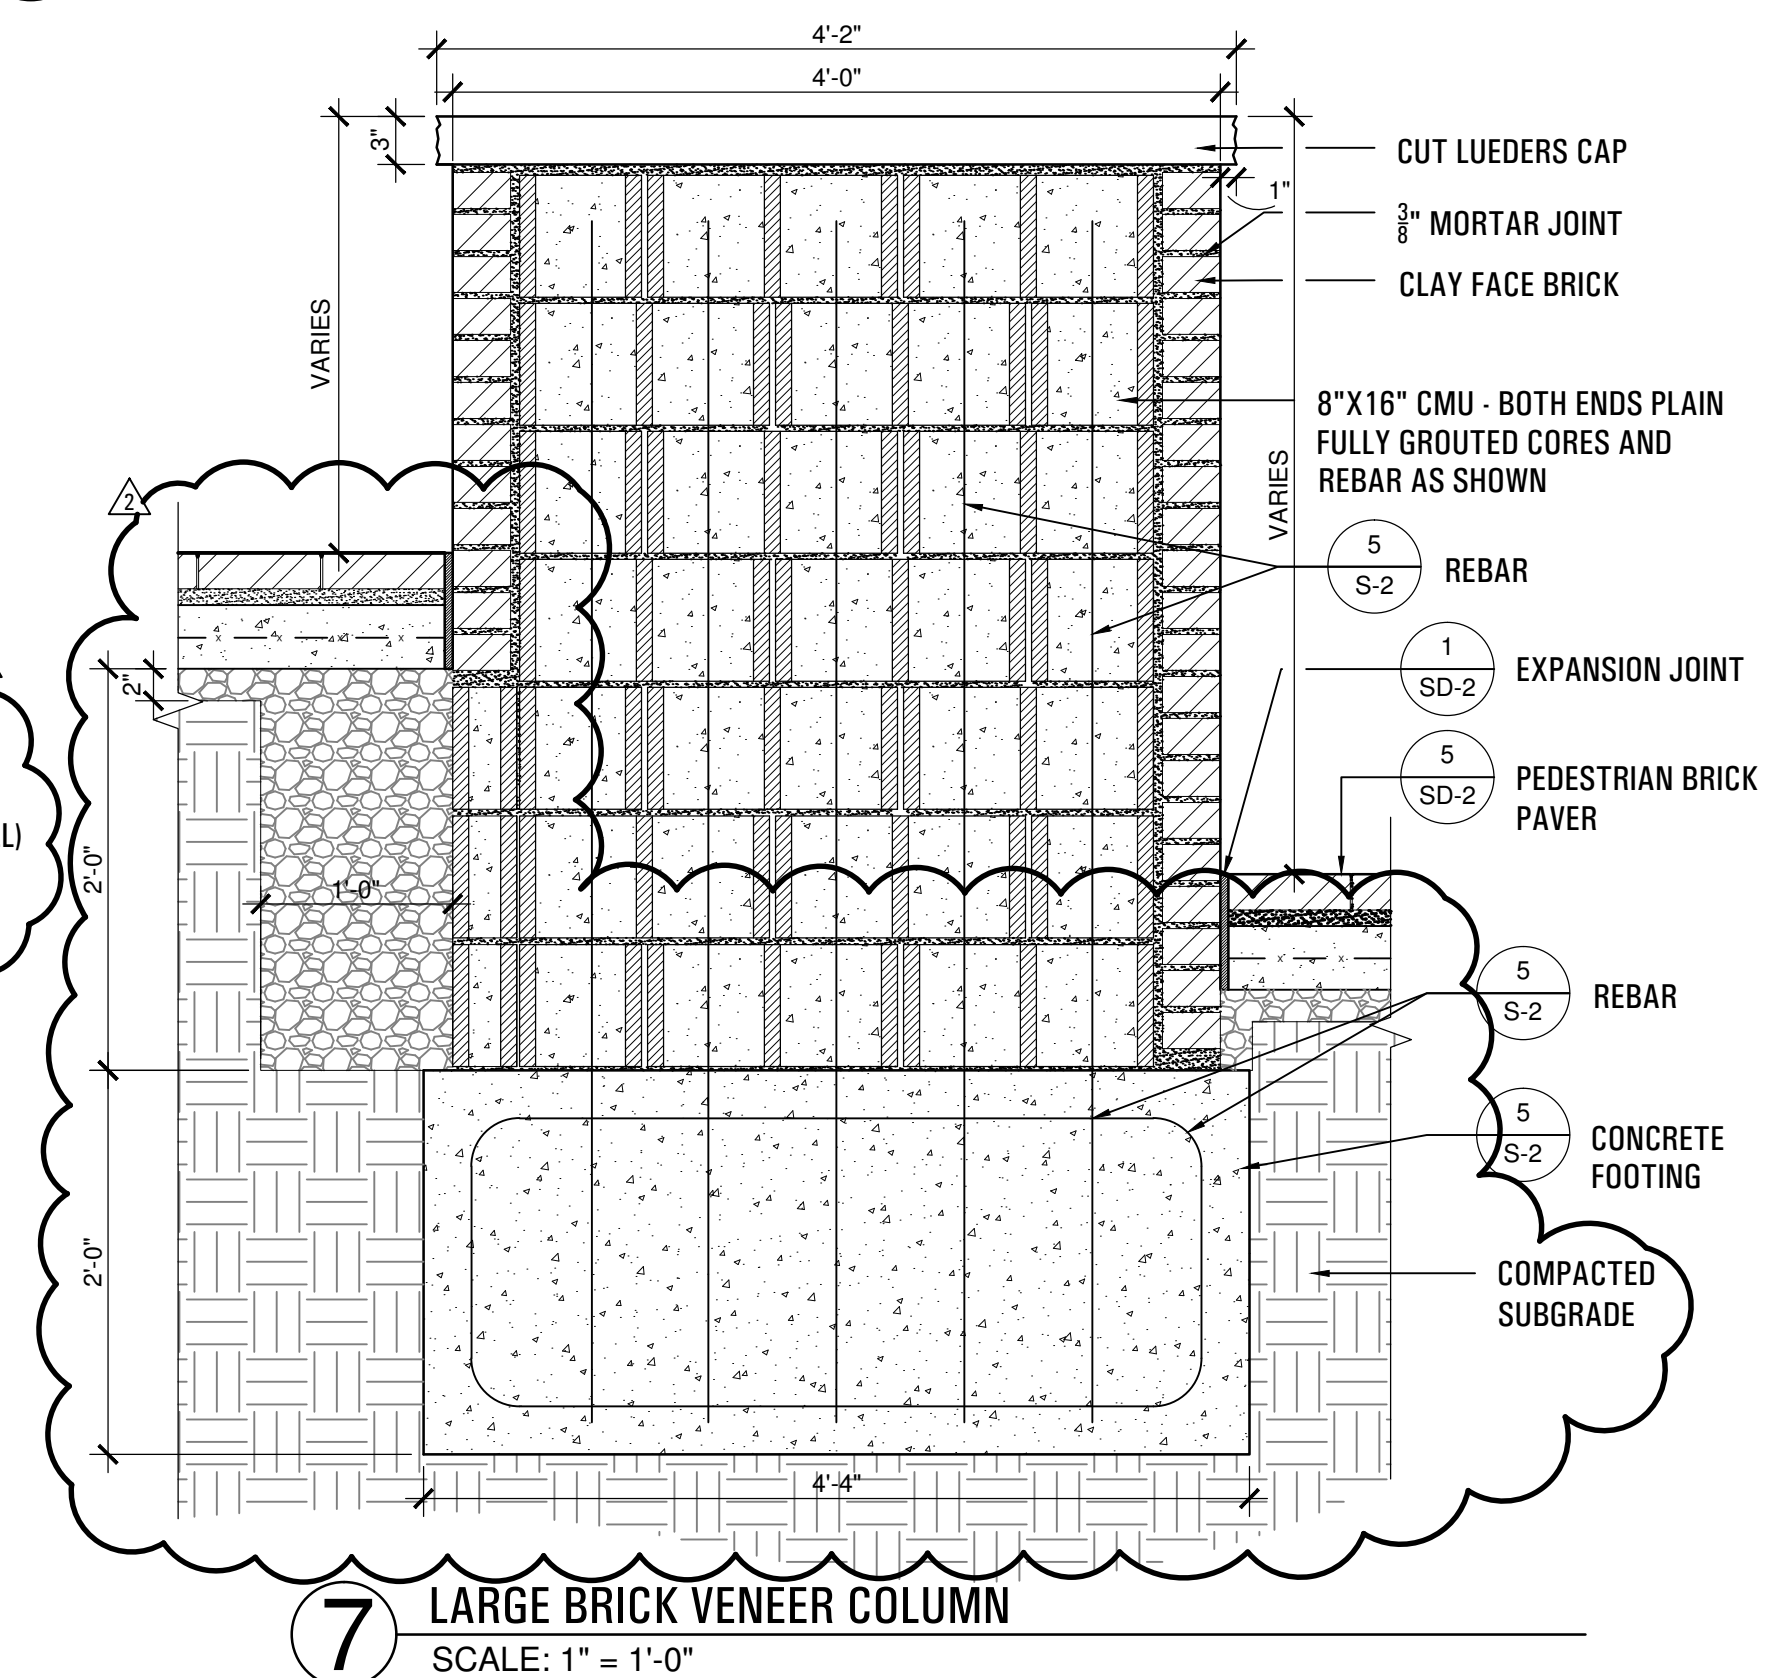

**7 LARGE BRICK VENEER COLUMN**  
SCALE: 1" = 1'-0"

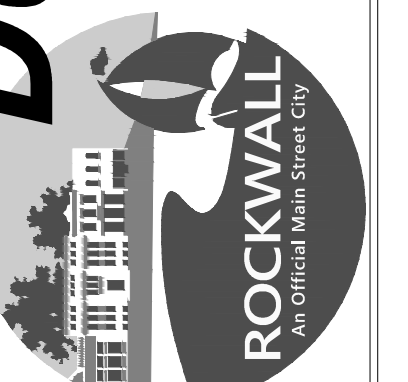


submittals / revisions

no.	date	detail
1	03/20/14	RFI #4
2	04/10/14	RFI #53

la terra studio, inc.

12024  
its project number  
02.26.2014  
date  
rac; bhm  
drawn by  
mtb  
checked by

registration

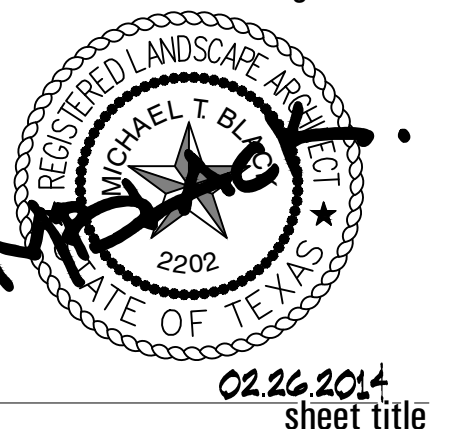

Site Details  
sheet number

**SD-4**