



DEMOLITION LEGEND:

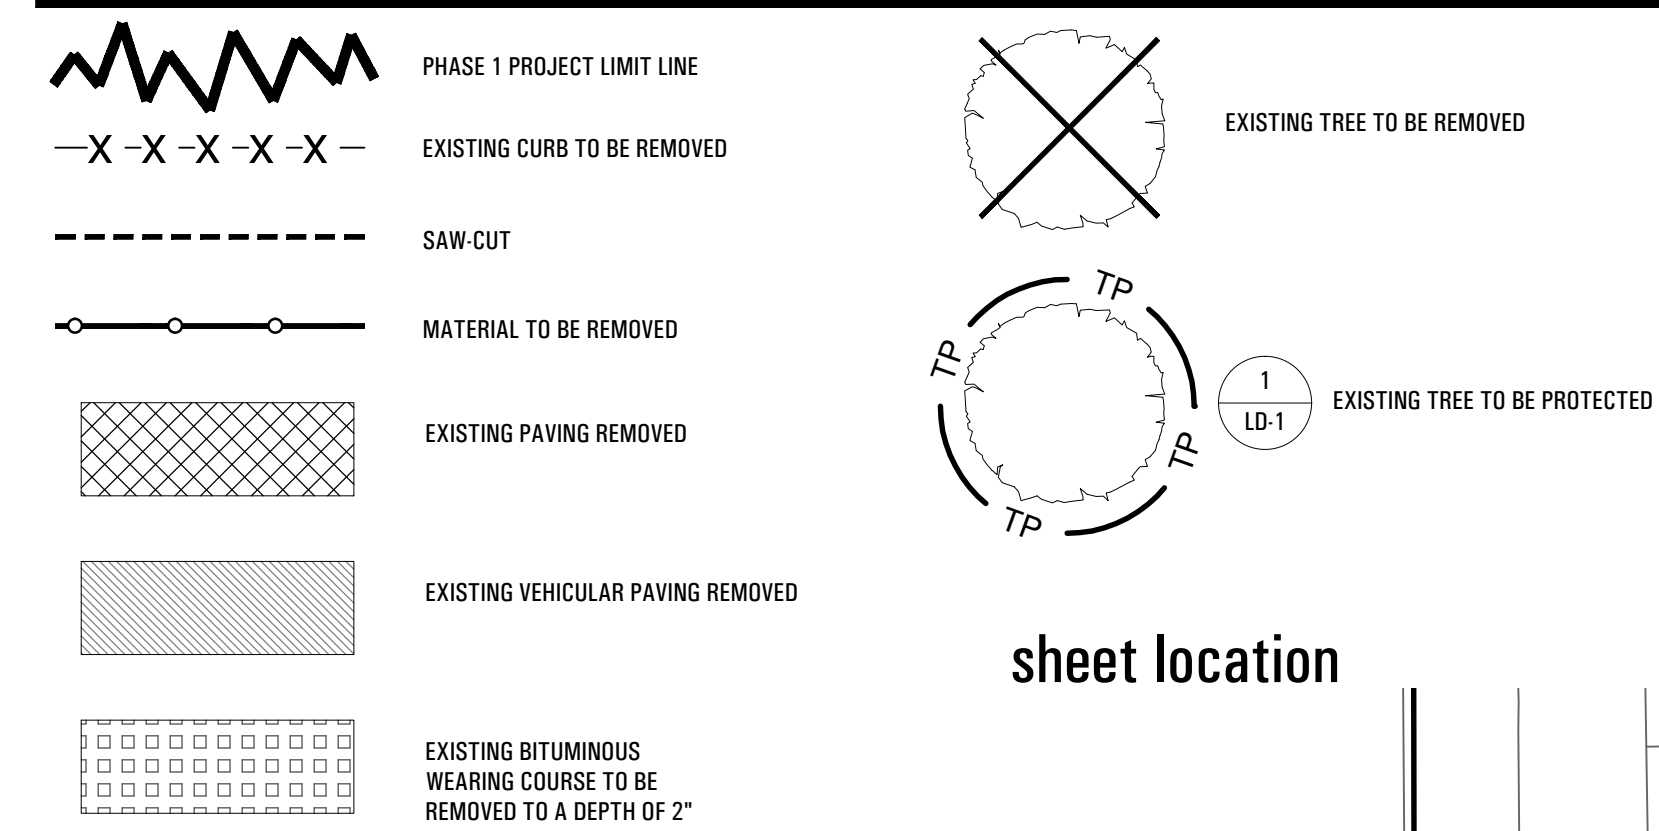

sheet location

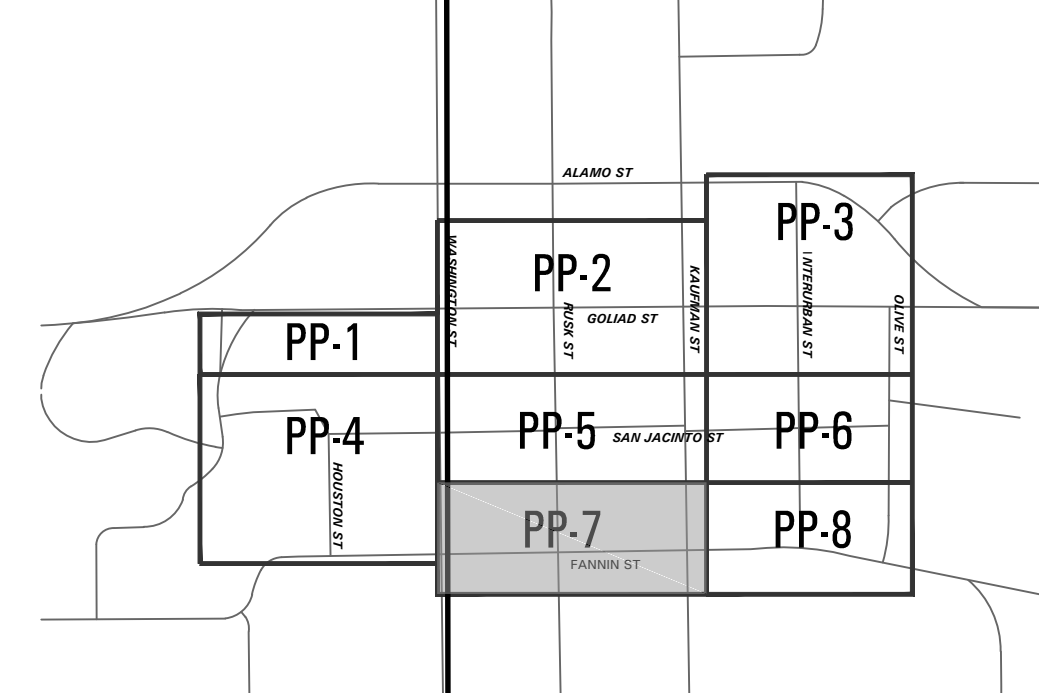

Call 1.800.DIG-TESS 2 Working Days BEFORE You Dig!
 www.digtess.org Dig Safely
 SHEET NOTES



submittals / revisions

no.	date	detail
▲	05/16/14	RFI #44
▲	07/14/14	RFI #94

la terra studio, inc.
 12024
 Its project number
 02.26.2014
 date
 rac; bhm
 drawn by
 mtb
 checked by

registration

02.26.2014
 sheet title
Site Preparation Plan
 sheet number
PP-7