

(A) TRASH RECEPTACLE (19 TOTAL):

RECEPTACLE, FLAT TOP, 36 GALLON
 MODEL: CV2-2000-PF
 FINISH: BLACK POWDER COAT
 MANUFACTURER: SITESCAPES
 CONTACT: BRITNEY NOVACEK 888.331.9464

(B) BENCH (2 TOTAL):

BENCH 4' BACKED BENCH, CAST IRON ENDS
 MODEL: CV1-3010-PF
 FINISH: BLACK POWDER COAT
 MANUFACTURER: SITESCAPES
 CONTACT: BRITNEY NOVACEK 888.331.9464

(C) BENCH (8 TOTAL):

BENCH 6' BACKED BENCH, CAST IRON ENDS
 MODEL: CV1-1010-PF
 FINISH: BLACK POWDER COAT
 MANUFACTURER: SITESCAPES
 CONTACT: BRITNEY NOVACEK 888.331.9464



(D) BIKE POST (2 TOTAL):

BOLLARD BIKE POST, 2 LOOPS
 MODEL: BP2-02-SM-PF
 FINISH: BLACK POWDER COAT
 MANUFACTURER: SITESCAPES
 CONTACT: BRITNEY NOVACEK 888.331.9464

NOTE:
 LANDSCAPE ARCHITECT TO APPROVE
 FINAL PLACEMENT OF SITE FURNISHINGS
 PRIOR TO INSTALLATION

SITE FURNISHING LEGEND:

- SHEETS
- (A) TRASH RECEPTACLE (19)
- (B) 4' BENCH (2)
- (C) 6' BENCH (8)
- (D) BIKE POST (4)

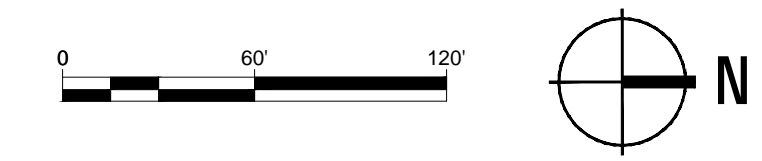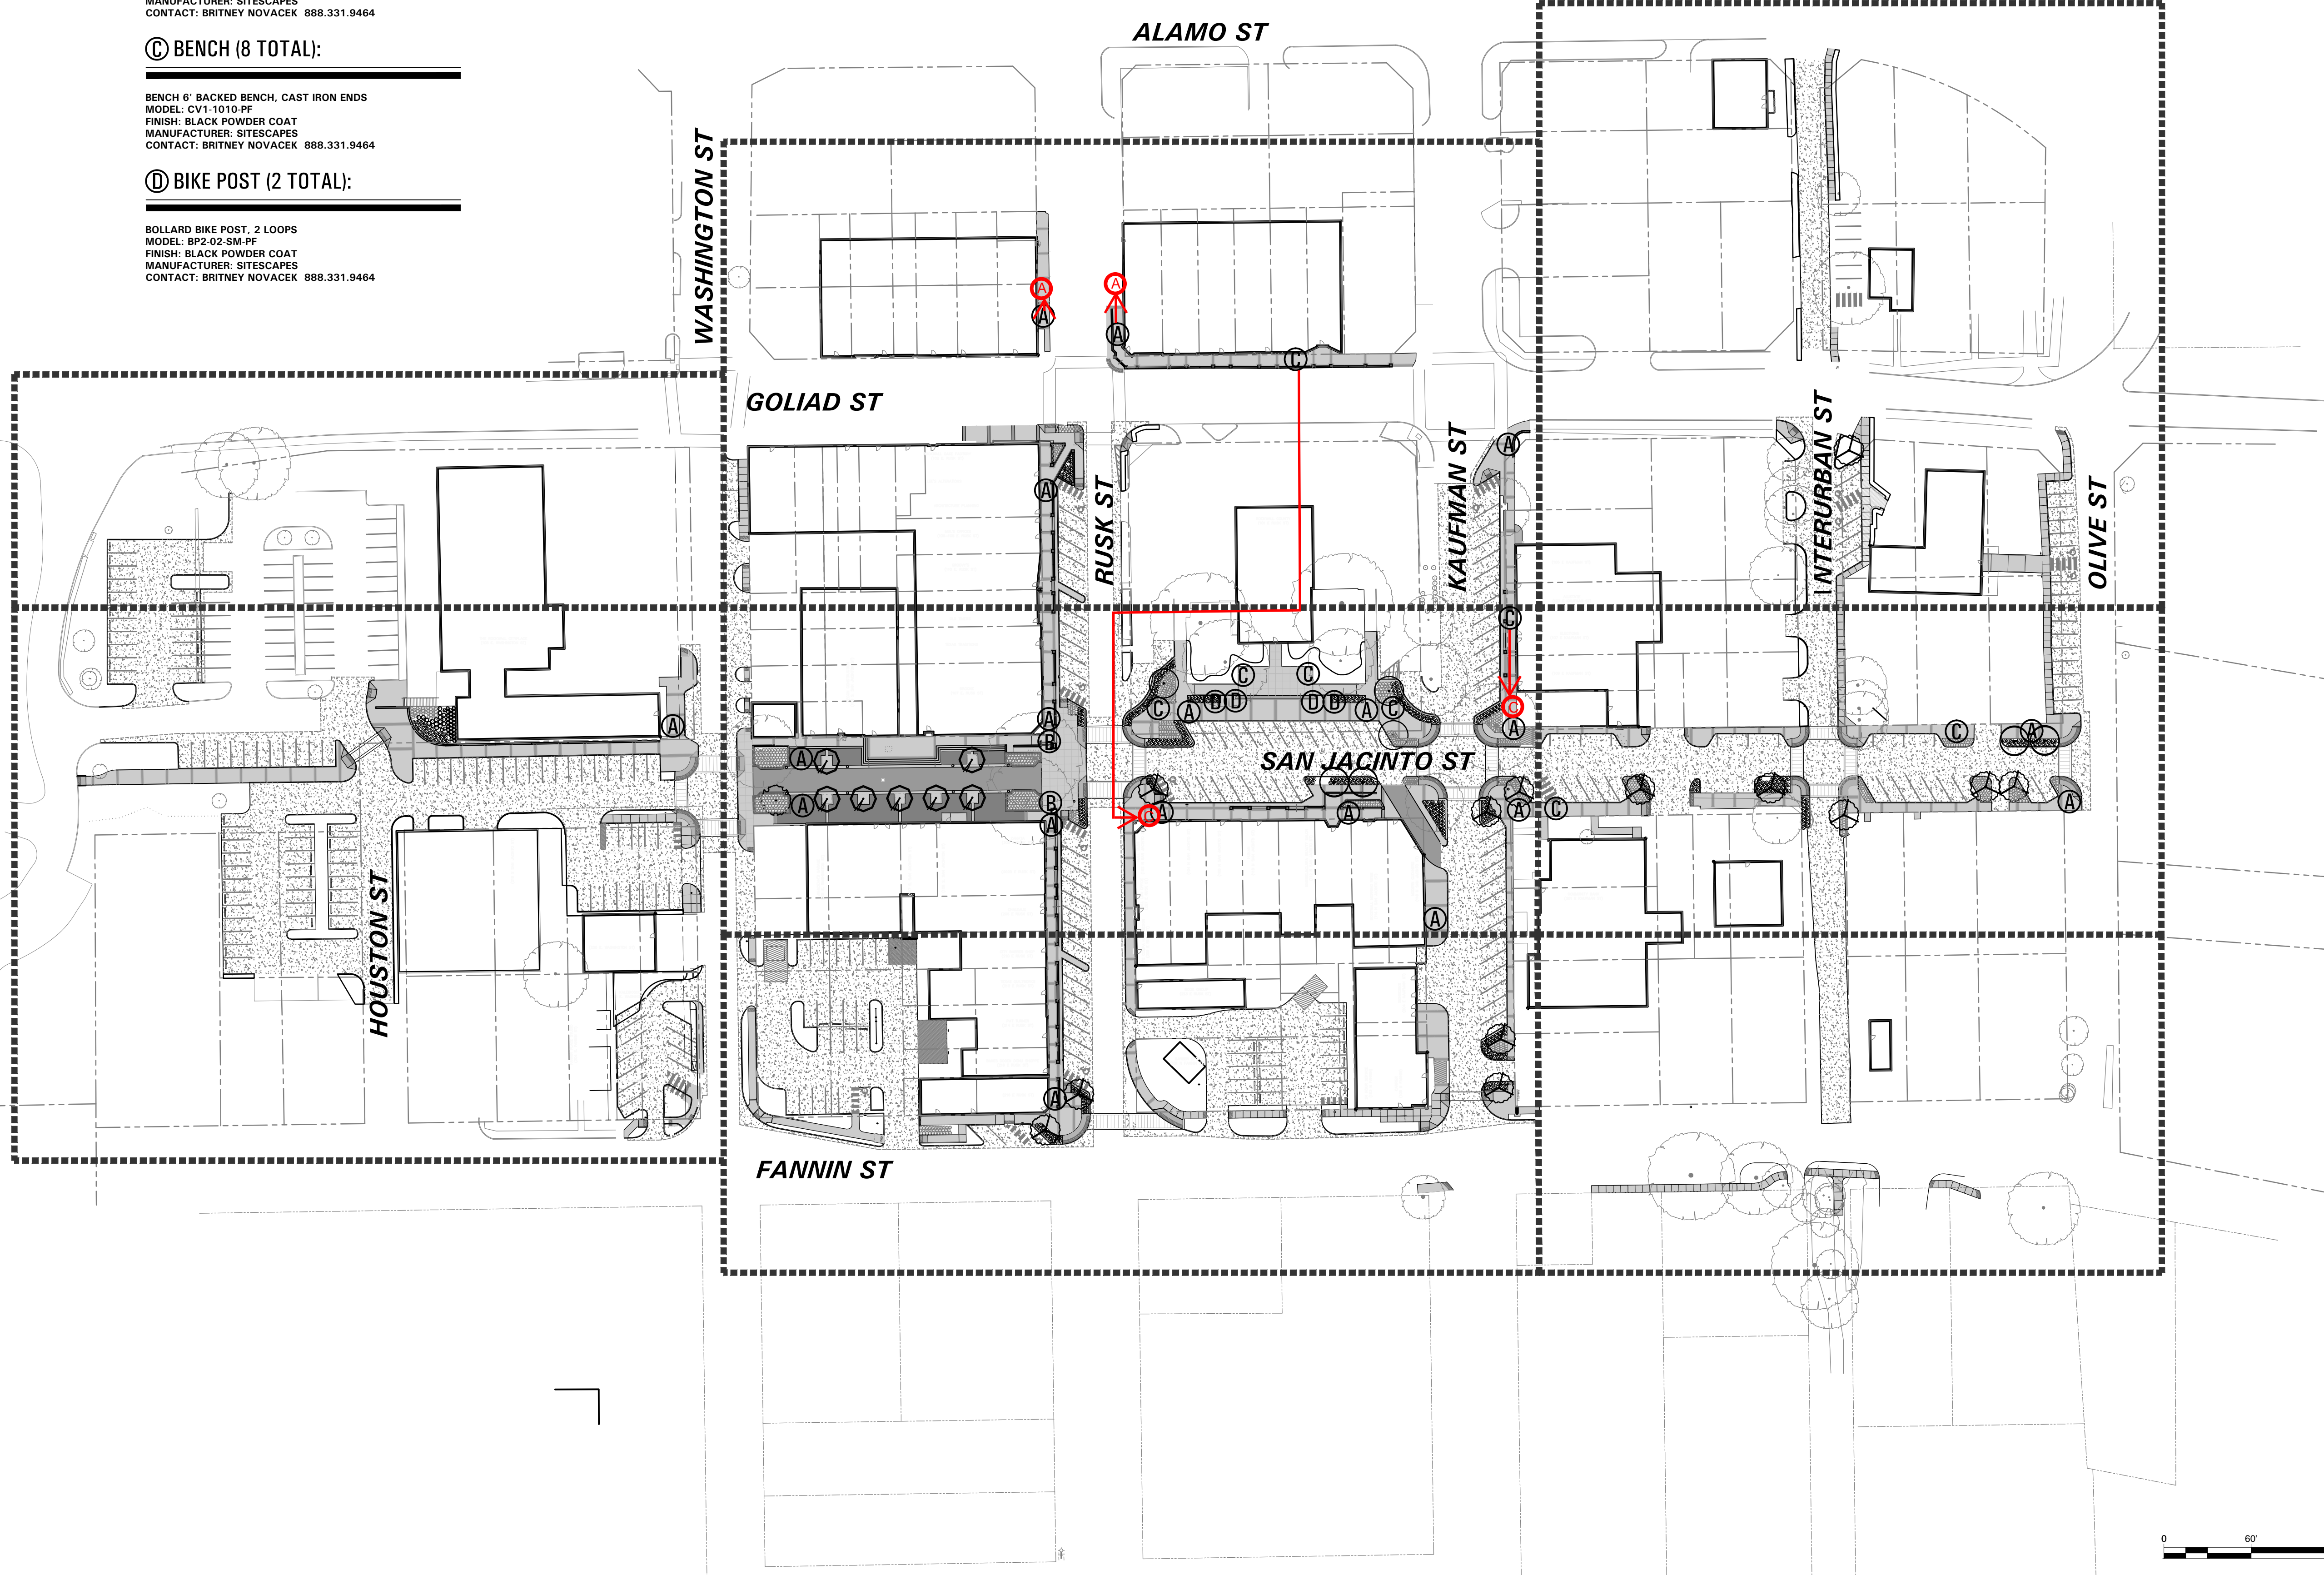

Downtown Rockwall
 la terra studio Project #12024
streetscape improvements
 PHASE 2
 rockwall, texas

submittals / revisions

no.	date	detail
1	06/08/15	LASI #17

la terra studio, inc.

12024
 its project number
 02.26.2014
 date
 rac; bhm
 drawn by
 mtb
 checked by



Site
Furnishings Plan
 sheet number

SF-1
AS BUILT
 03/07/2016