


~ MATCH LINE-SHEET SP-2 ~

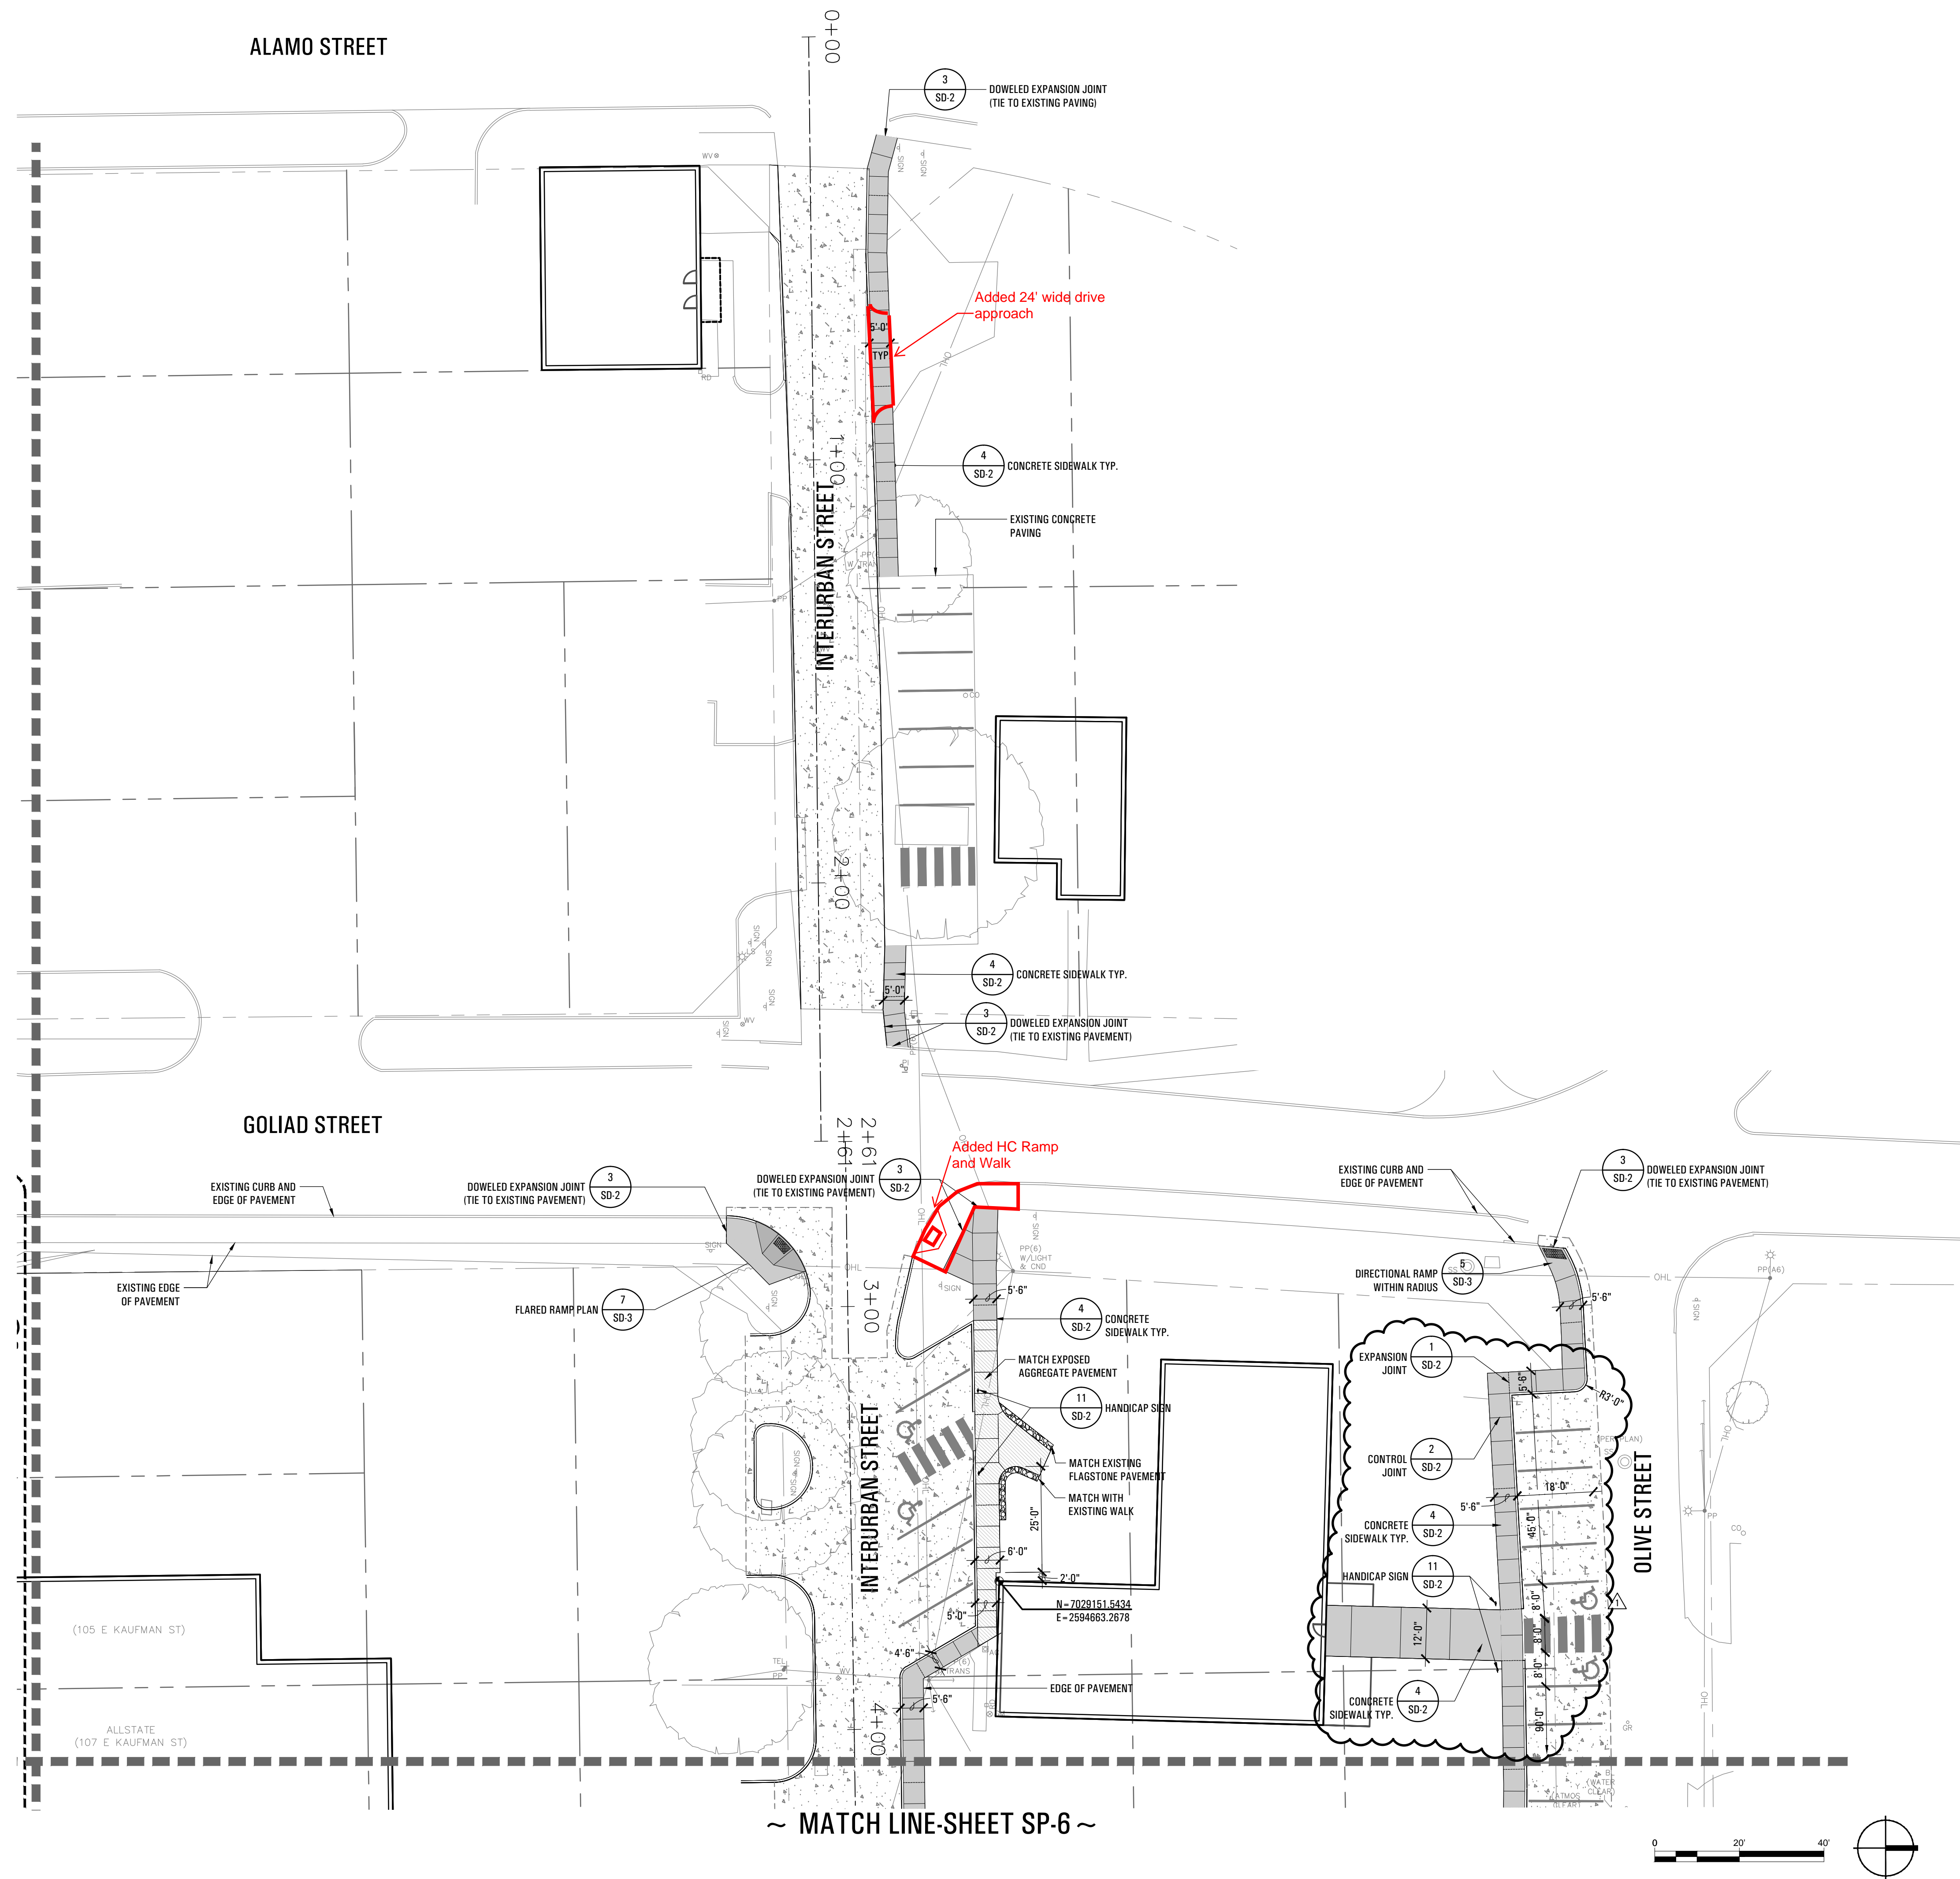


~ MATCH LINE-SHEET SP-6 ~

SITE PLAN LEGEND:

- EDGE OF PAVEMENT
- CONCRETE SIDEWALK PAVEMENT
- CONCRETE VEHICULAR PAVEMENT
- TYPICAL LIGHT FIXTURE

sheet location

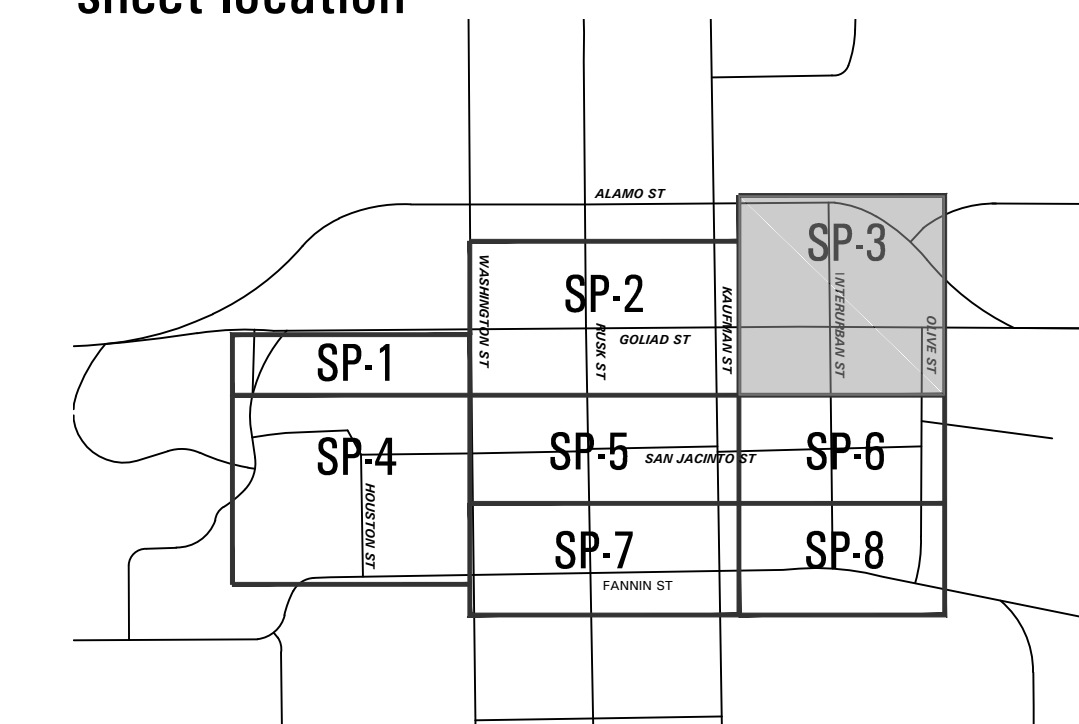

Downtown Rockwall
 la terra studio Project #12024
streetscape improvements
 PHASE 2
 rockwall, texas



submittals / revisions

no.	date	detail
1	01/23/15	RF# 157

la terra studio, inc.

12024
 Its project number
 02.26.2014
 date
 rac; bhm
 drawn by
 mtb
 checked by

registration



02.26.2014
 sheet title

Site Plan
 sheet number

SP-3
AS BUILT
 03/07/2016