
NEW EDGE OF PAVEMENT

~ MATCH LINE-SHEET SP-1 ~

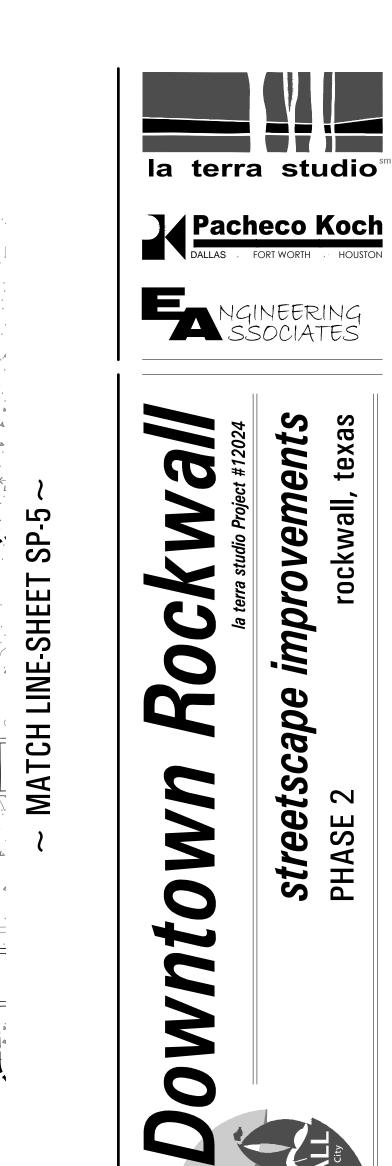


STREET

no. date detail 03/25/14 RFI# 25 (FOR CITY APPROVAL) 04/11/14 RFI# 72 10/09/14 RFI# 130

la terra studio, inc. 12024 Its project number 02.26.2014

rac; bhm drawn by

checked by

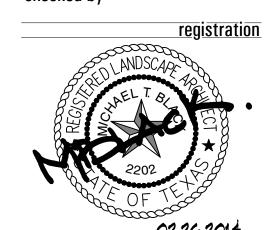

02.26.2014 sheet title Site Plan