


**SITE PLAN LEGEND:**

- EDGE OF PAVEMENT
- CONCRETE SIDEWALK PAVEMENT
- CONCRETE VEHICULAR PAVEMENT
- TYPICAL LIGHT FIXTURE

**sheet location**

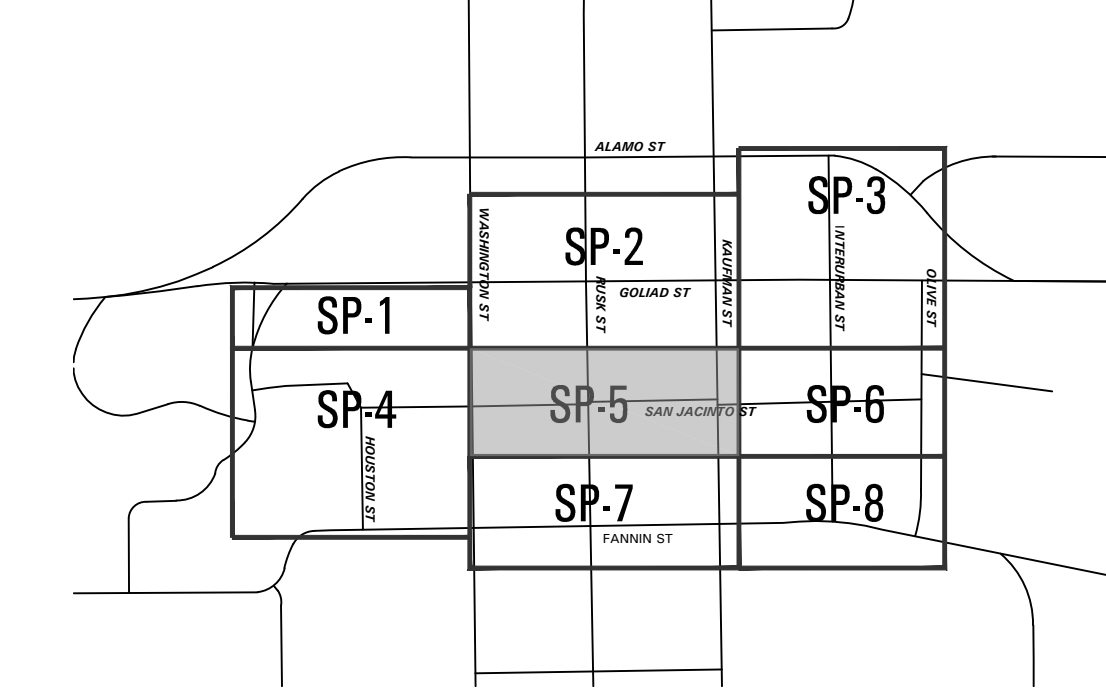

**Downtown Rockwall**  
 la terra studio Project #12024  
**streetscape improvements**  
 PHASE 2  
 rockwall, texas




submittals / revisions

no.	date	detail
1	04/03/15	RFI #170
2	04/06/15	RFI #171
3	10/06/15	RFI #174
4	10/29/15	RFI #208, #209

la terra studio, inc.

12024  
 lts project number  
 02.26.2014  
 date  
 rac; bhm  
 drawn by  
 mtb  
 checked by

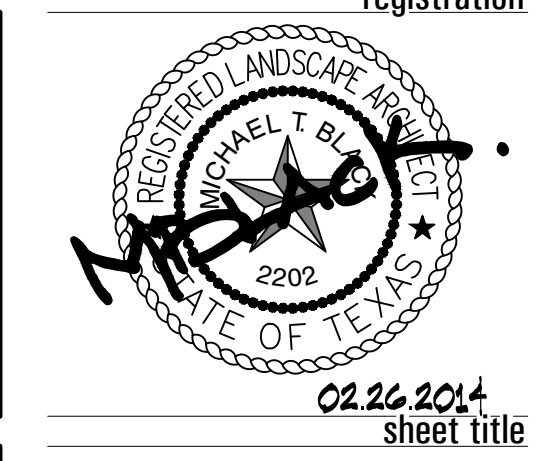

Site Plan  
 sheet number

**SP-5**  
**AS BUILT**  
 03/07/2016