


**SITE PLAN LEGEND:**

- EDGE OF PAVEMENT
- CONCRETE SIDEWALK PAVEMENT
- CONCRETE VEHICULAR PAVEMENT
- TYPICAL LIGHT FIXTURE

**sheet location**

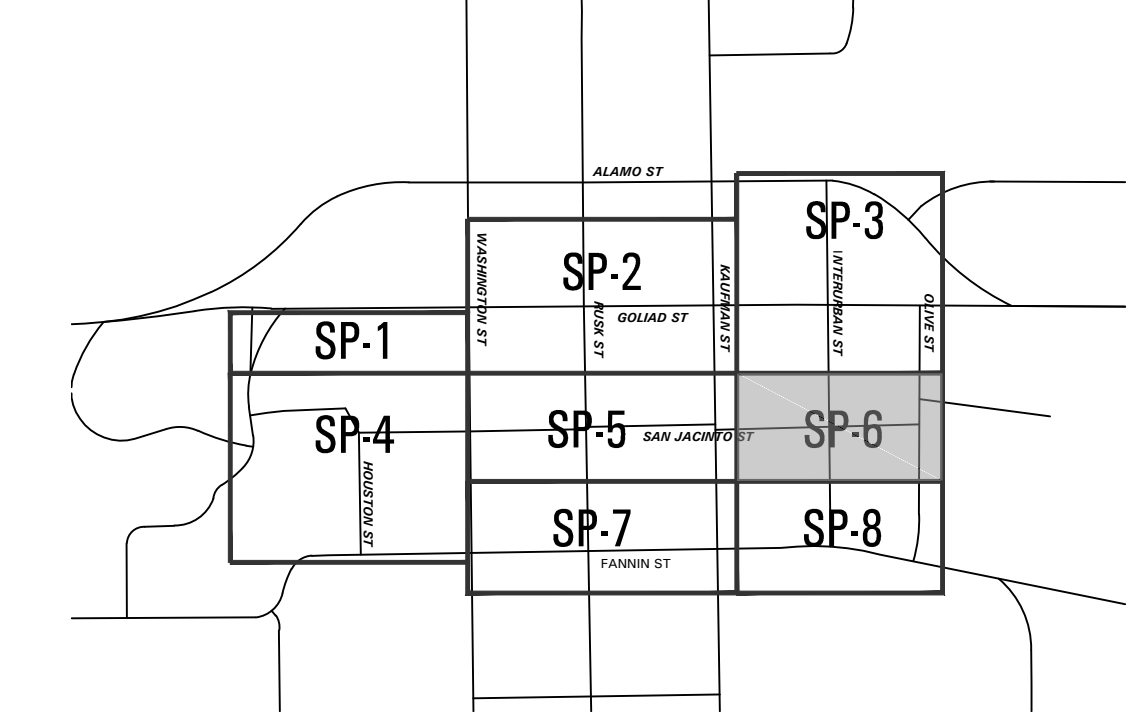

**Downtown Rockwall**  
 la terra studio Project #12024  
**streetscape improvements**  
 PHASE 2  
 rockwall, texas



submittals / revisions

no.	date	detail
1	12/02/14	LASI #13
2	12/08/14	RFI #151
3	12/22/14	RFI #150
4	02/10/15	RFI #159
5	03/11/15	RFI #162
6	05/01/15	RFI #175, #176
7	07/02/15	RFI #183
8	07/13/15	RFI #181

la terra studio, inc.

12024  
 its project number  
 02.26.2014  
 date  
 rac; bhm  
 drawn by  
 mtb  
 checked by

registration



Site Plan  
 sheet number

**SP-6**  
**AS BUILT**  
 03/07/2016