



LEGEND:

- PROJECT LIMIT LINE
- TYPICAL LIGHT FIXTURE

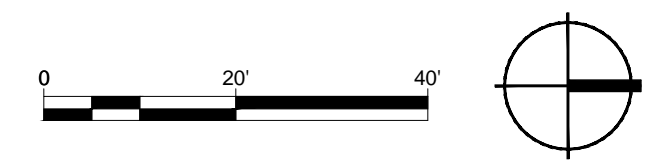

sheet location

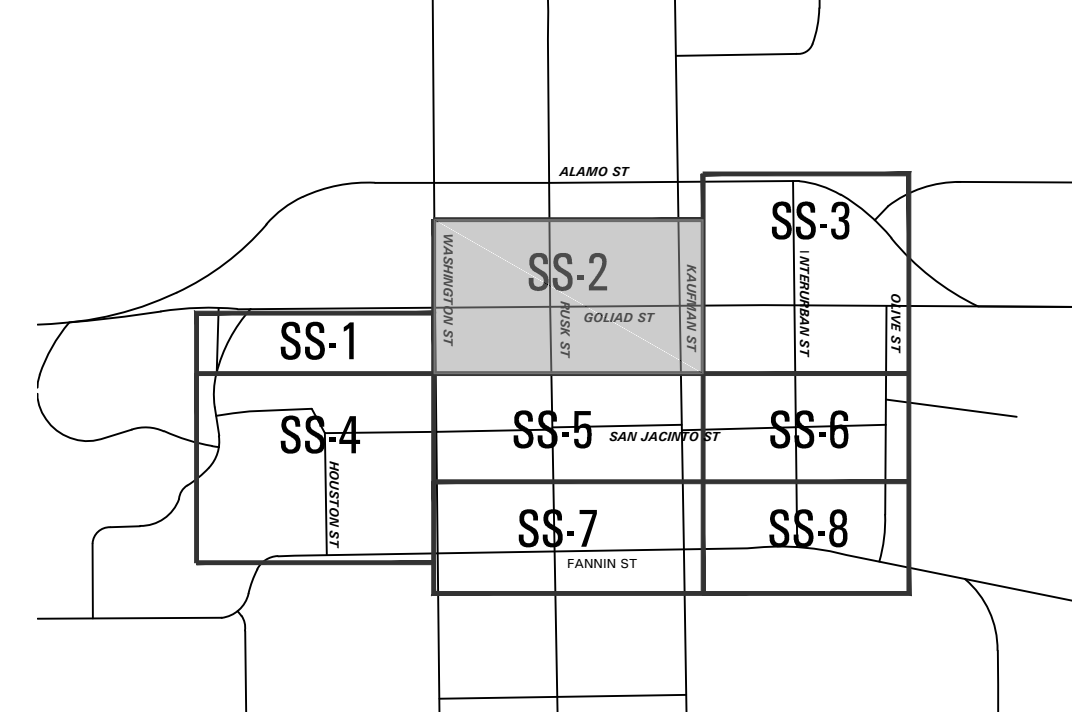

Downtown Rockwall
 la terra studio Project #12024
streetscape improvements
 PHASE 2
 rockwall, texas



submittals / revisions

| no. | date | detail |
|-----|----------|----------|
| 1 | 03/01/14 | RFI #35 |
| 2 | 09/23/14 | RFI #115 |
| 3 | 12/18/14 | RFI #115 |
| 4 | 10/14/15 | RFI #197 |
| 5 | 12/02/15 | LASI #23 |

la terra studio, inc.
 12024
 its project number
 02.26.2014
 date
 rac; bhm
 drawn by
 mtb
 checked by



02.26.2014
 sheet title
Subsurface Drainage Plan
 sheet number

SS-2
AS BUILT
 03/07/2016